42+92.85 107.95 for check should have been 107.90
thence chained to Hub under Inst Sta
1.0 Right of Sta 43+96.46
found this morning on first line (+ tied to)
1.0 out of ground) 4.2 North of Hub
44+00.66 Set Hub (large Cedar post 4' diameter standing
N W Cor Sec 4 chained South towards Inst 660.0 to
found this am 0.1 R + East of our line. thence pm
42+92.85 = Inst F. S. on Hub N.W. cor Sec 4

P.M

50+60.75 = 0.1 R = N W cor Sec 4

50+57.65 end of Calc course to Corner!!!
49+87 Cross E + W fence
also same Sta under fence Hub + Lack 1.0 R
45+07.1 Cross E + W fence at R angles

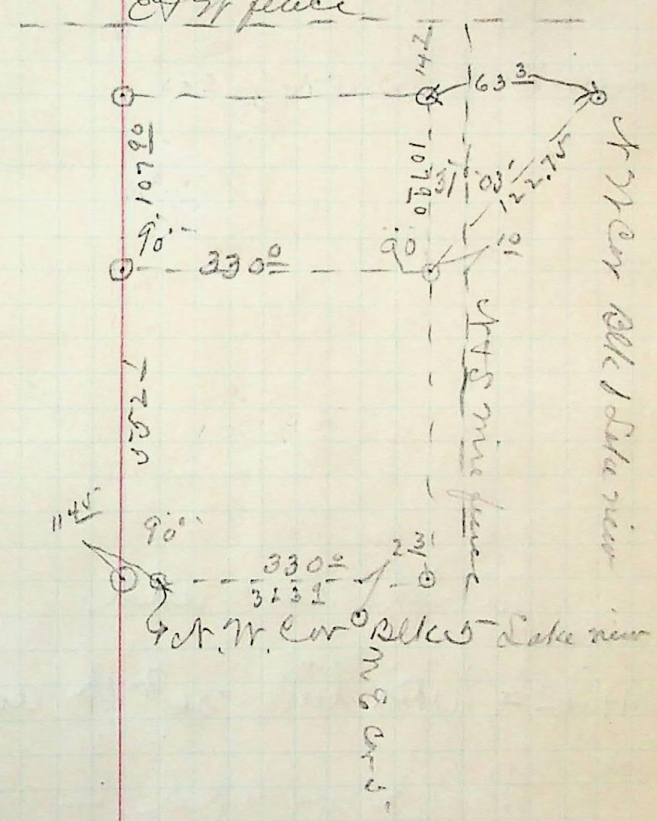

Wound
Post (Cedar) about 0.2 under Water level with
N W Cor Sec 4 Sta 50+60.75 0.1 ☐ Sec Cor

E + W fence

Meadow
1.0
E + W fence