


In March, 1890  
B 30

1741 B  
 And Pinecocks Lane from S line City Survey  
 Survey to Establish 33<sup>d</sup> Street

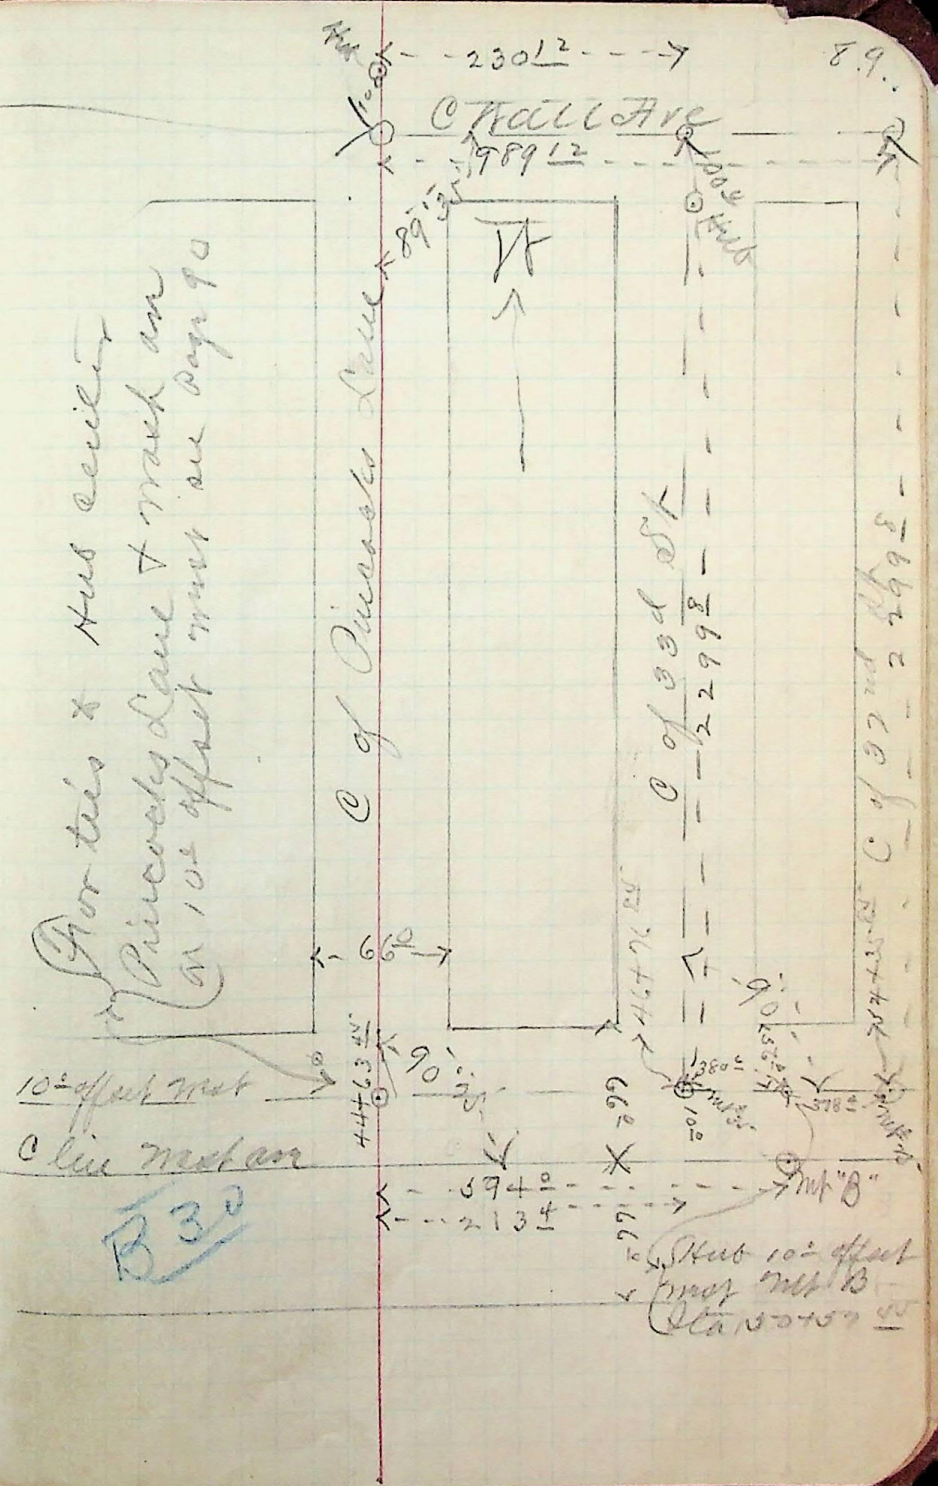

For this & Hub ceiling  
 Pinecocks Lane & mark an  
 on 10± offset met see page 90

B 30

Hub 10± offset  
 from prop met B  
 Sta 578±