

+ checked within 0.24 = checks.  
 86098 there chained South to Mt #2  
 North to Mt #4 checked exactly right!  
 Just over letter Hub retained distance

Long Mt #5 as Set 2 + set Hub

Set 3 distance (Set 3 being about twice as  
 to overlap 0.49 !!! Cut off 0.32 from

8613 + set Hub found these two distances  
 Hence chained from Mt #4 South

Set 66 Plot C

Hub for the E+W line bet Sets 2 + 3

Hence chained North 450.12 + set

Just over Mt #2 from Mt #4


between Co mts 2 + 4

Checking Recorded distance

Thursday AM March 13<sup>th</sup> 1890

See page 93 for ties to Co mt #4

1330

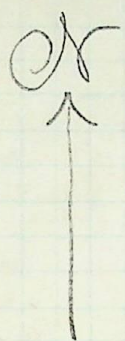

Center Line Washington Ave

460.12 Rec dist  
 1449.26 actual dist

8613 Rec dist  
 86098 actual dist

