


Tane

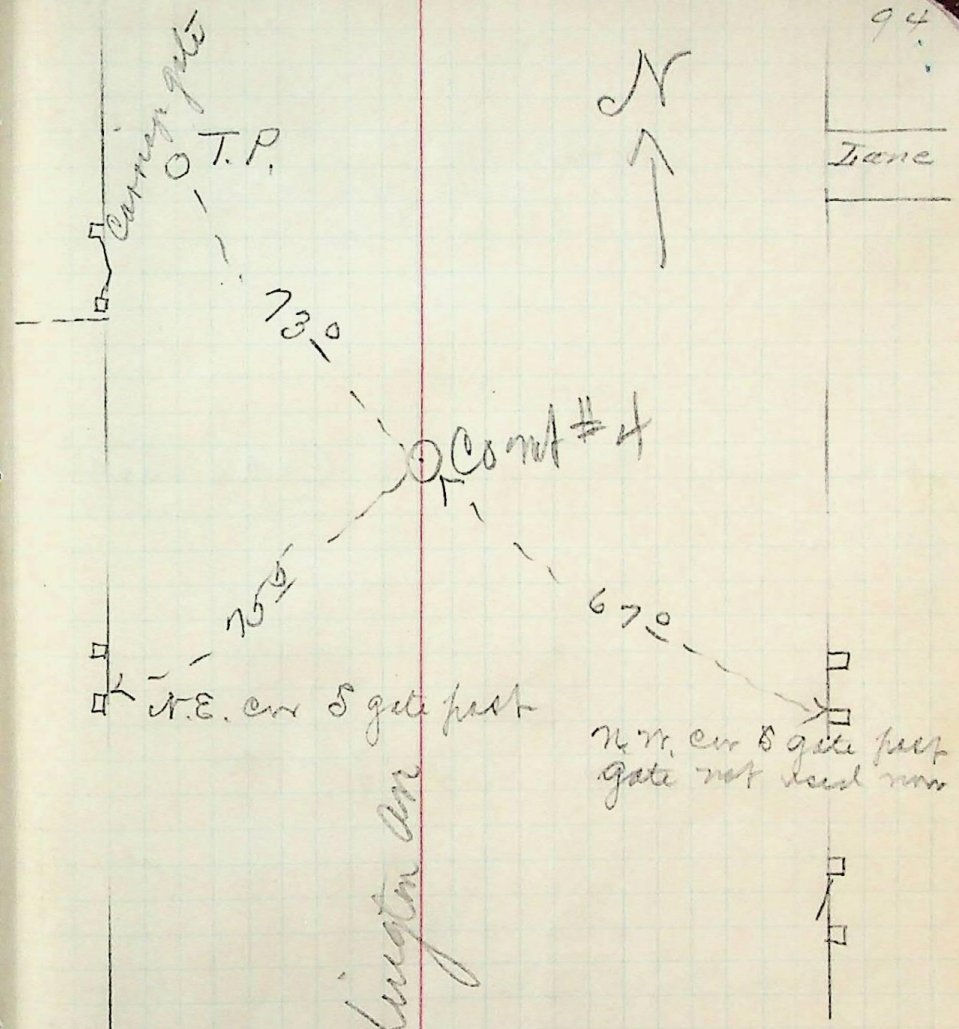

Washington Ave

N.W. cor S gate post
gate not used now

N.E. cor S gate post

Cont #4

T.P.

Cannon gate