
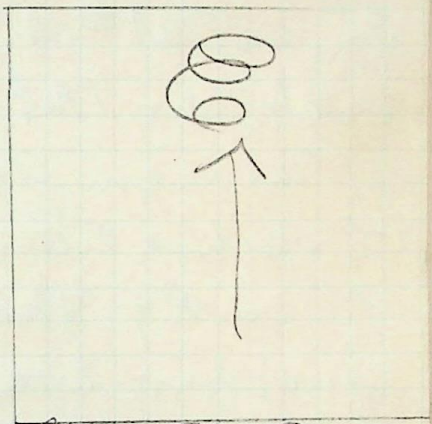


Jefferson Ave

IN 41.05

96

 


Sta 105+08


~~Ditch~~

Addys Ave

Sta 107+77.2

 

27th St

 

Washington Ave

100+00

W + S across 27th St
also Location of ditch
Pages 30-32
See Civil Book #1 A

East side Jefferson avenue
27th St West side Wash ingham to
Running Center for X Sectioning
Tuesday Am. March 18th 1890