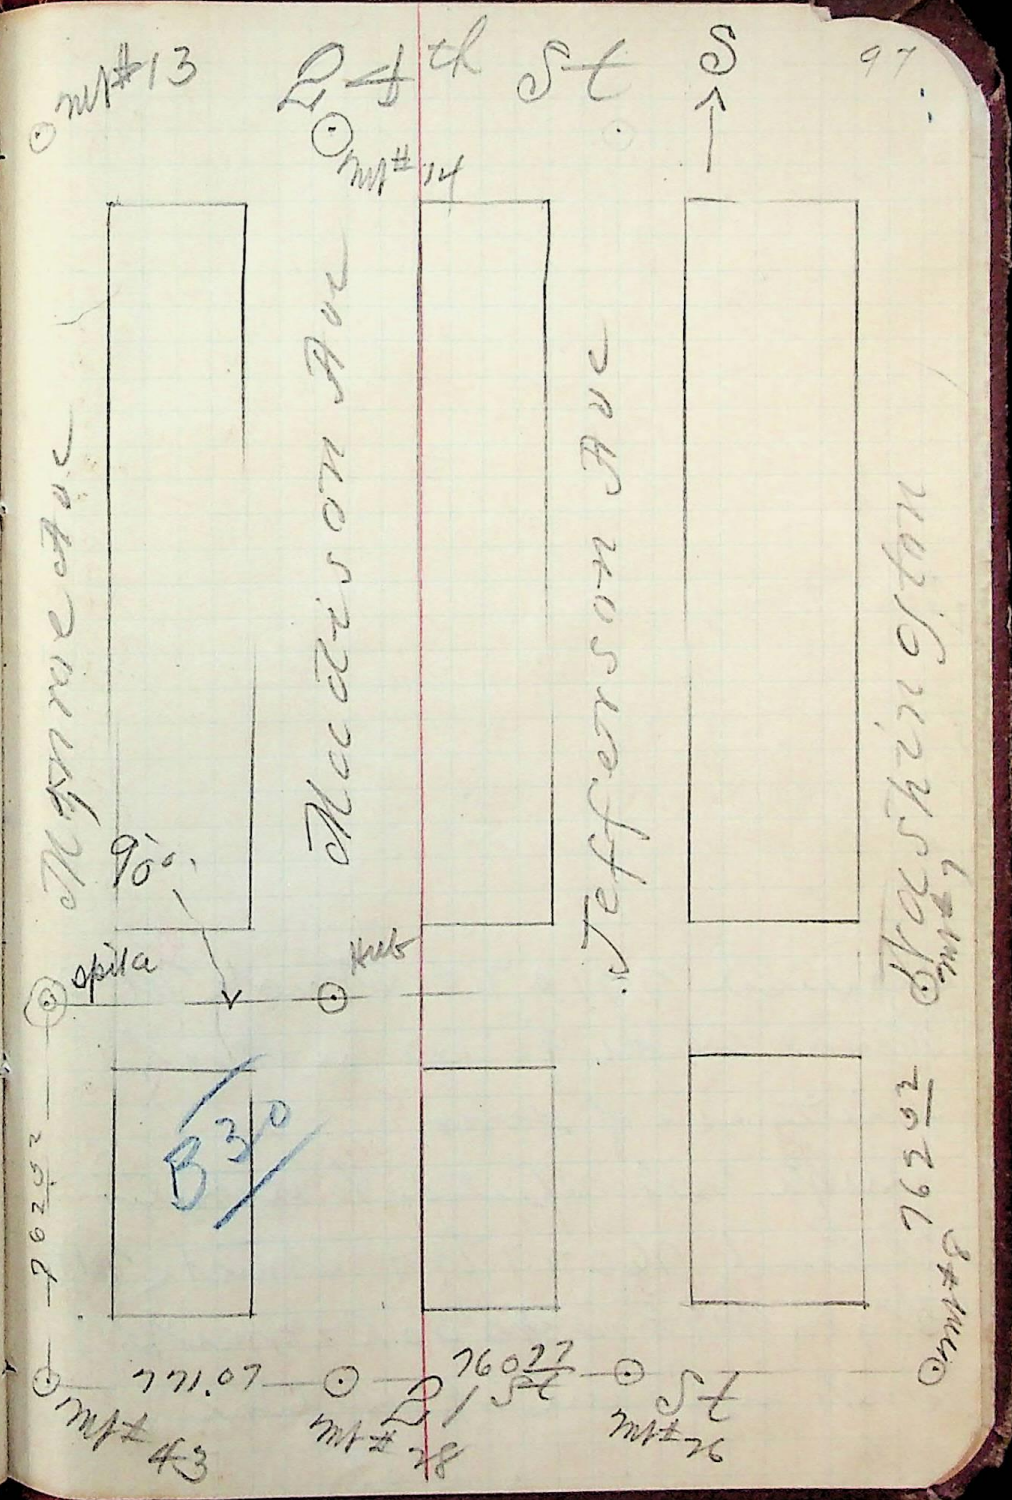Hub for Center of 22nd & Madison
& intersected, Spikes End set
F.S. on Mt #14 (Madison End 24th)
Inst over Mt #28 (21st & Madison)
of Madison Ave
2 spikes either side Center line
90°00 R & West (repeated) & set
Inst over latter Hub F.S on Mt #13
Center 22nd & Monroe Ave
Chained 762 02 & set Hub for
& 21st) F.S. on Mt #13 (Monroe & 24th)
Thence Inst over Mt #43 (Monroe
dist = 762 02 (Record = 762.40)
Inst over Mt #8 F.S on Mt #6 found
& Madison & Jefferson Avenues
Avenues on 21st bet Monroe & Madison
Intersection End checking Blk dist —
The Center of Madison & 22nd by
Ave & 22nd St by Measurement, B 3/0
Establishing Center of Monroe
Thursday March 20th 1890