


See N 1/2 Sec. 24, on page 120.

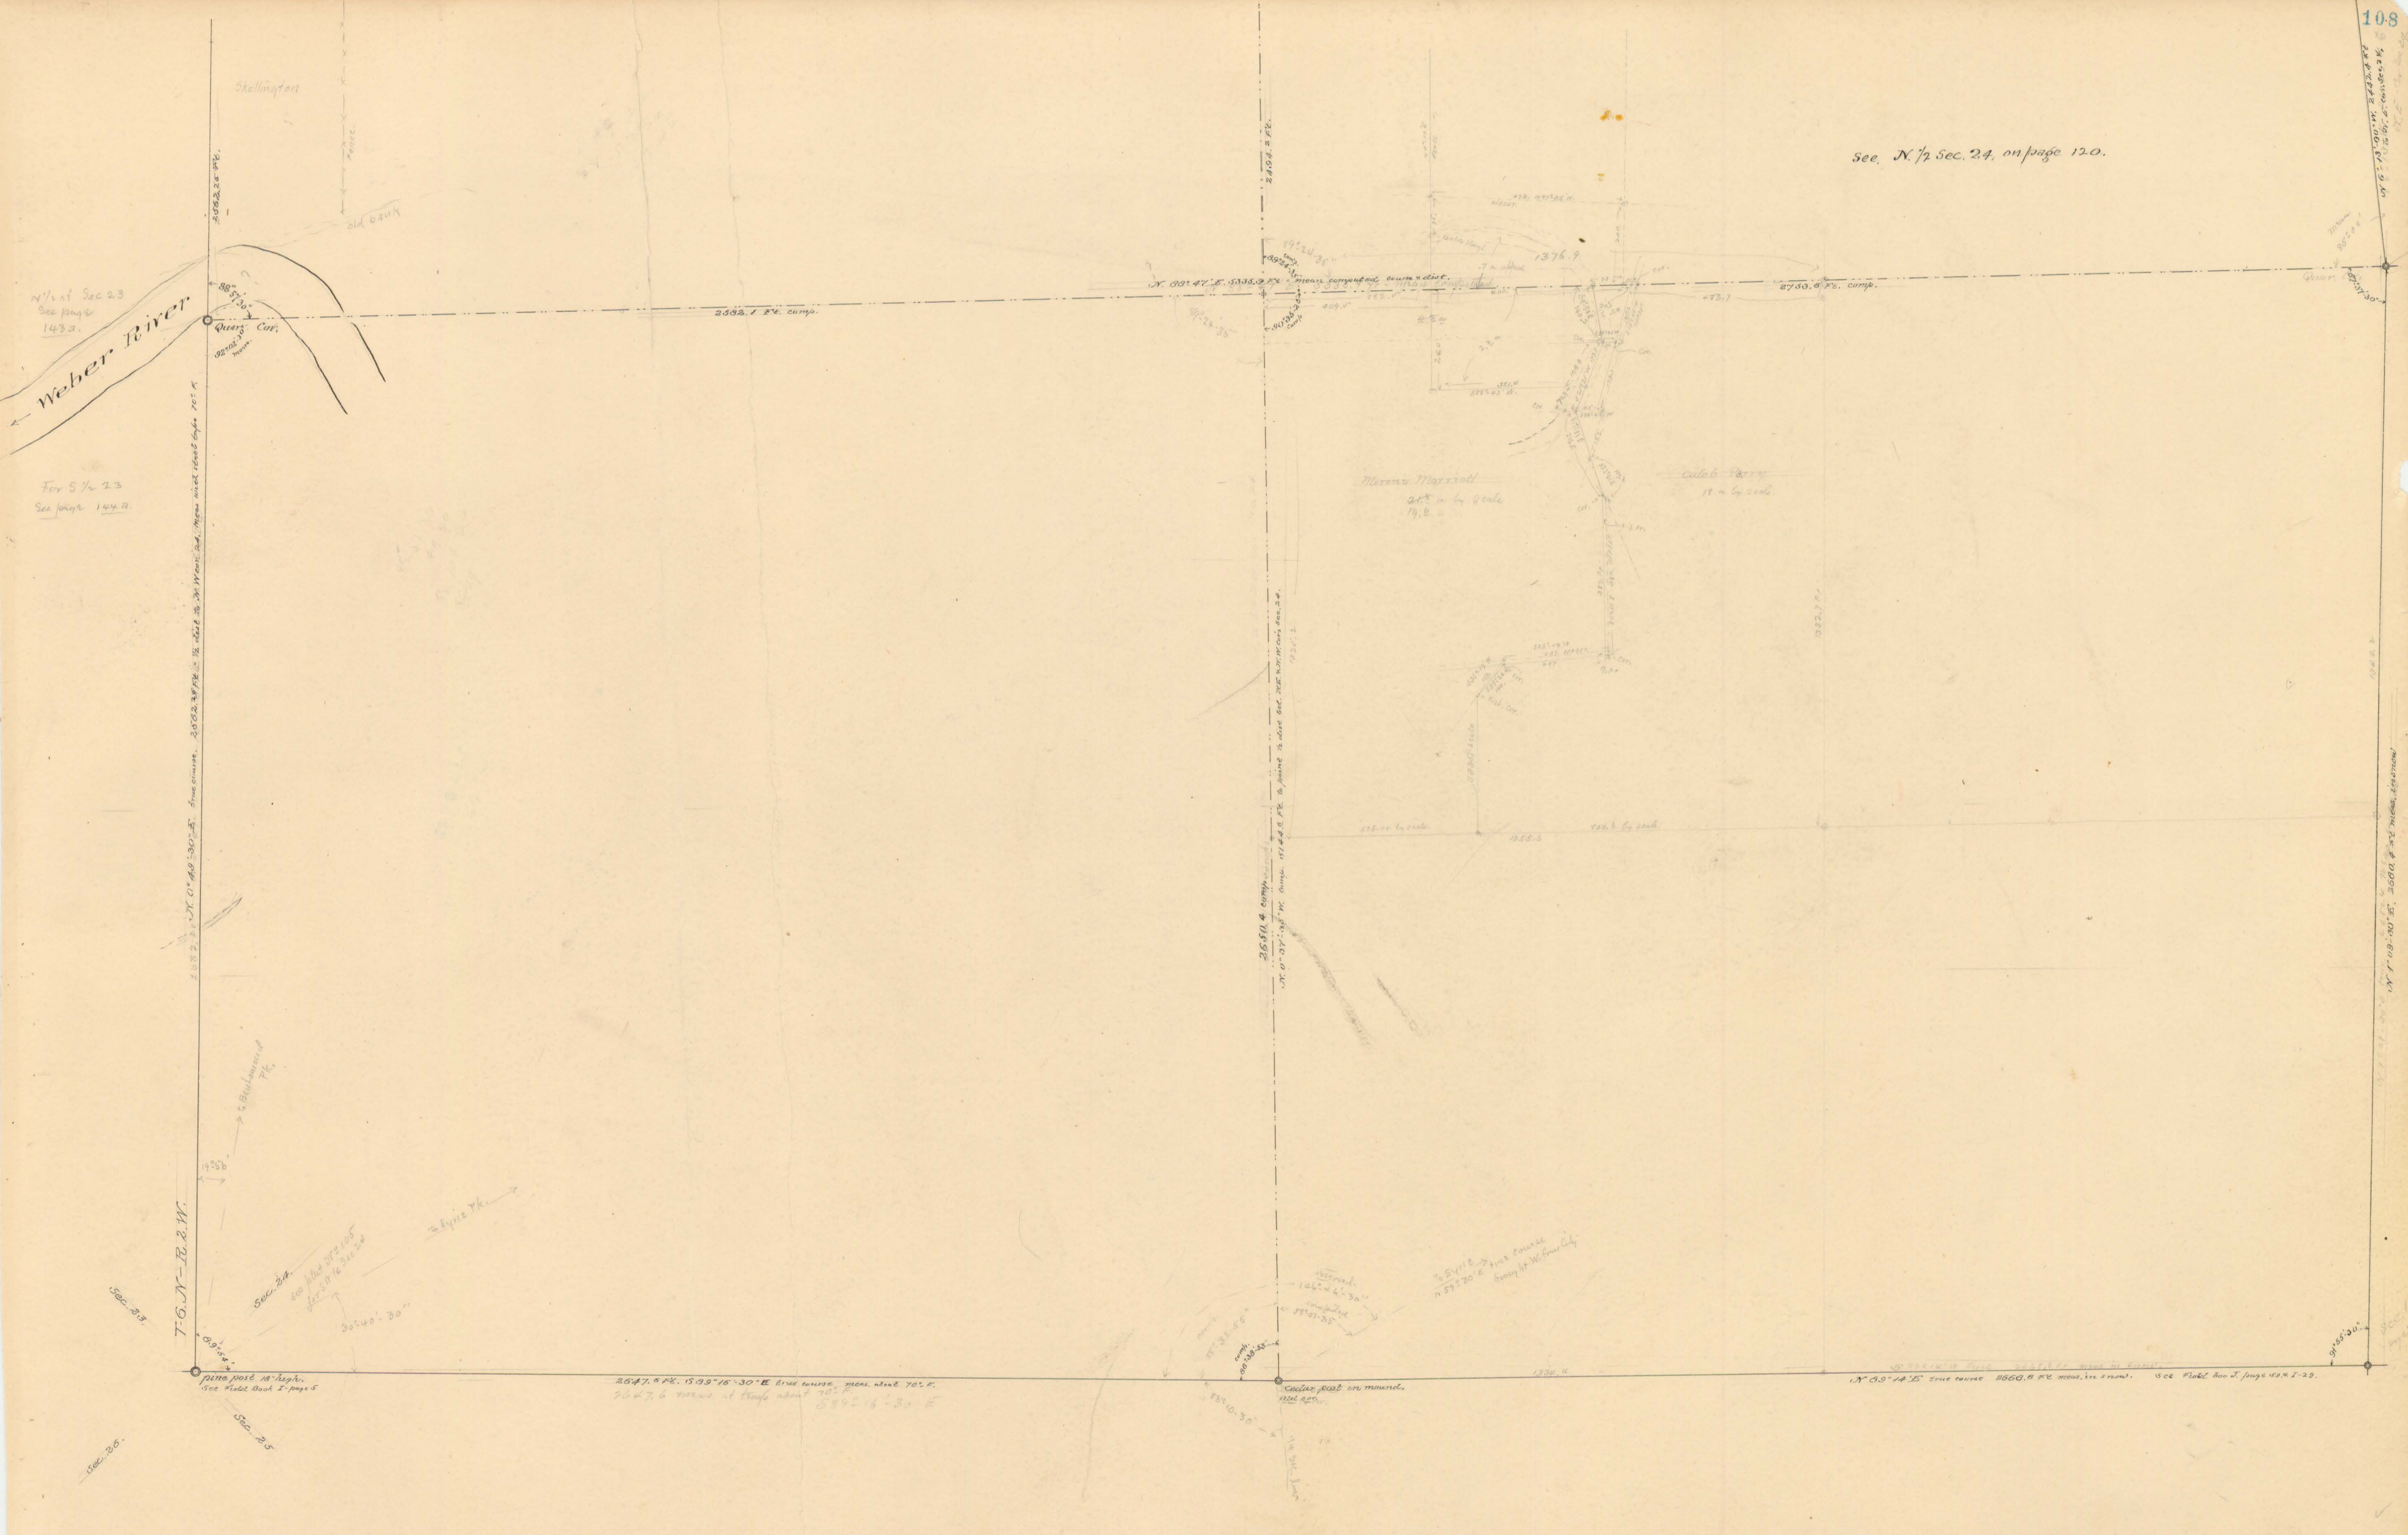

S 1/2 of Sec. 24 T6 N-R 2W