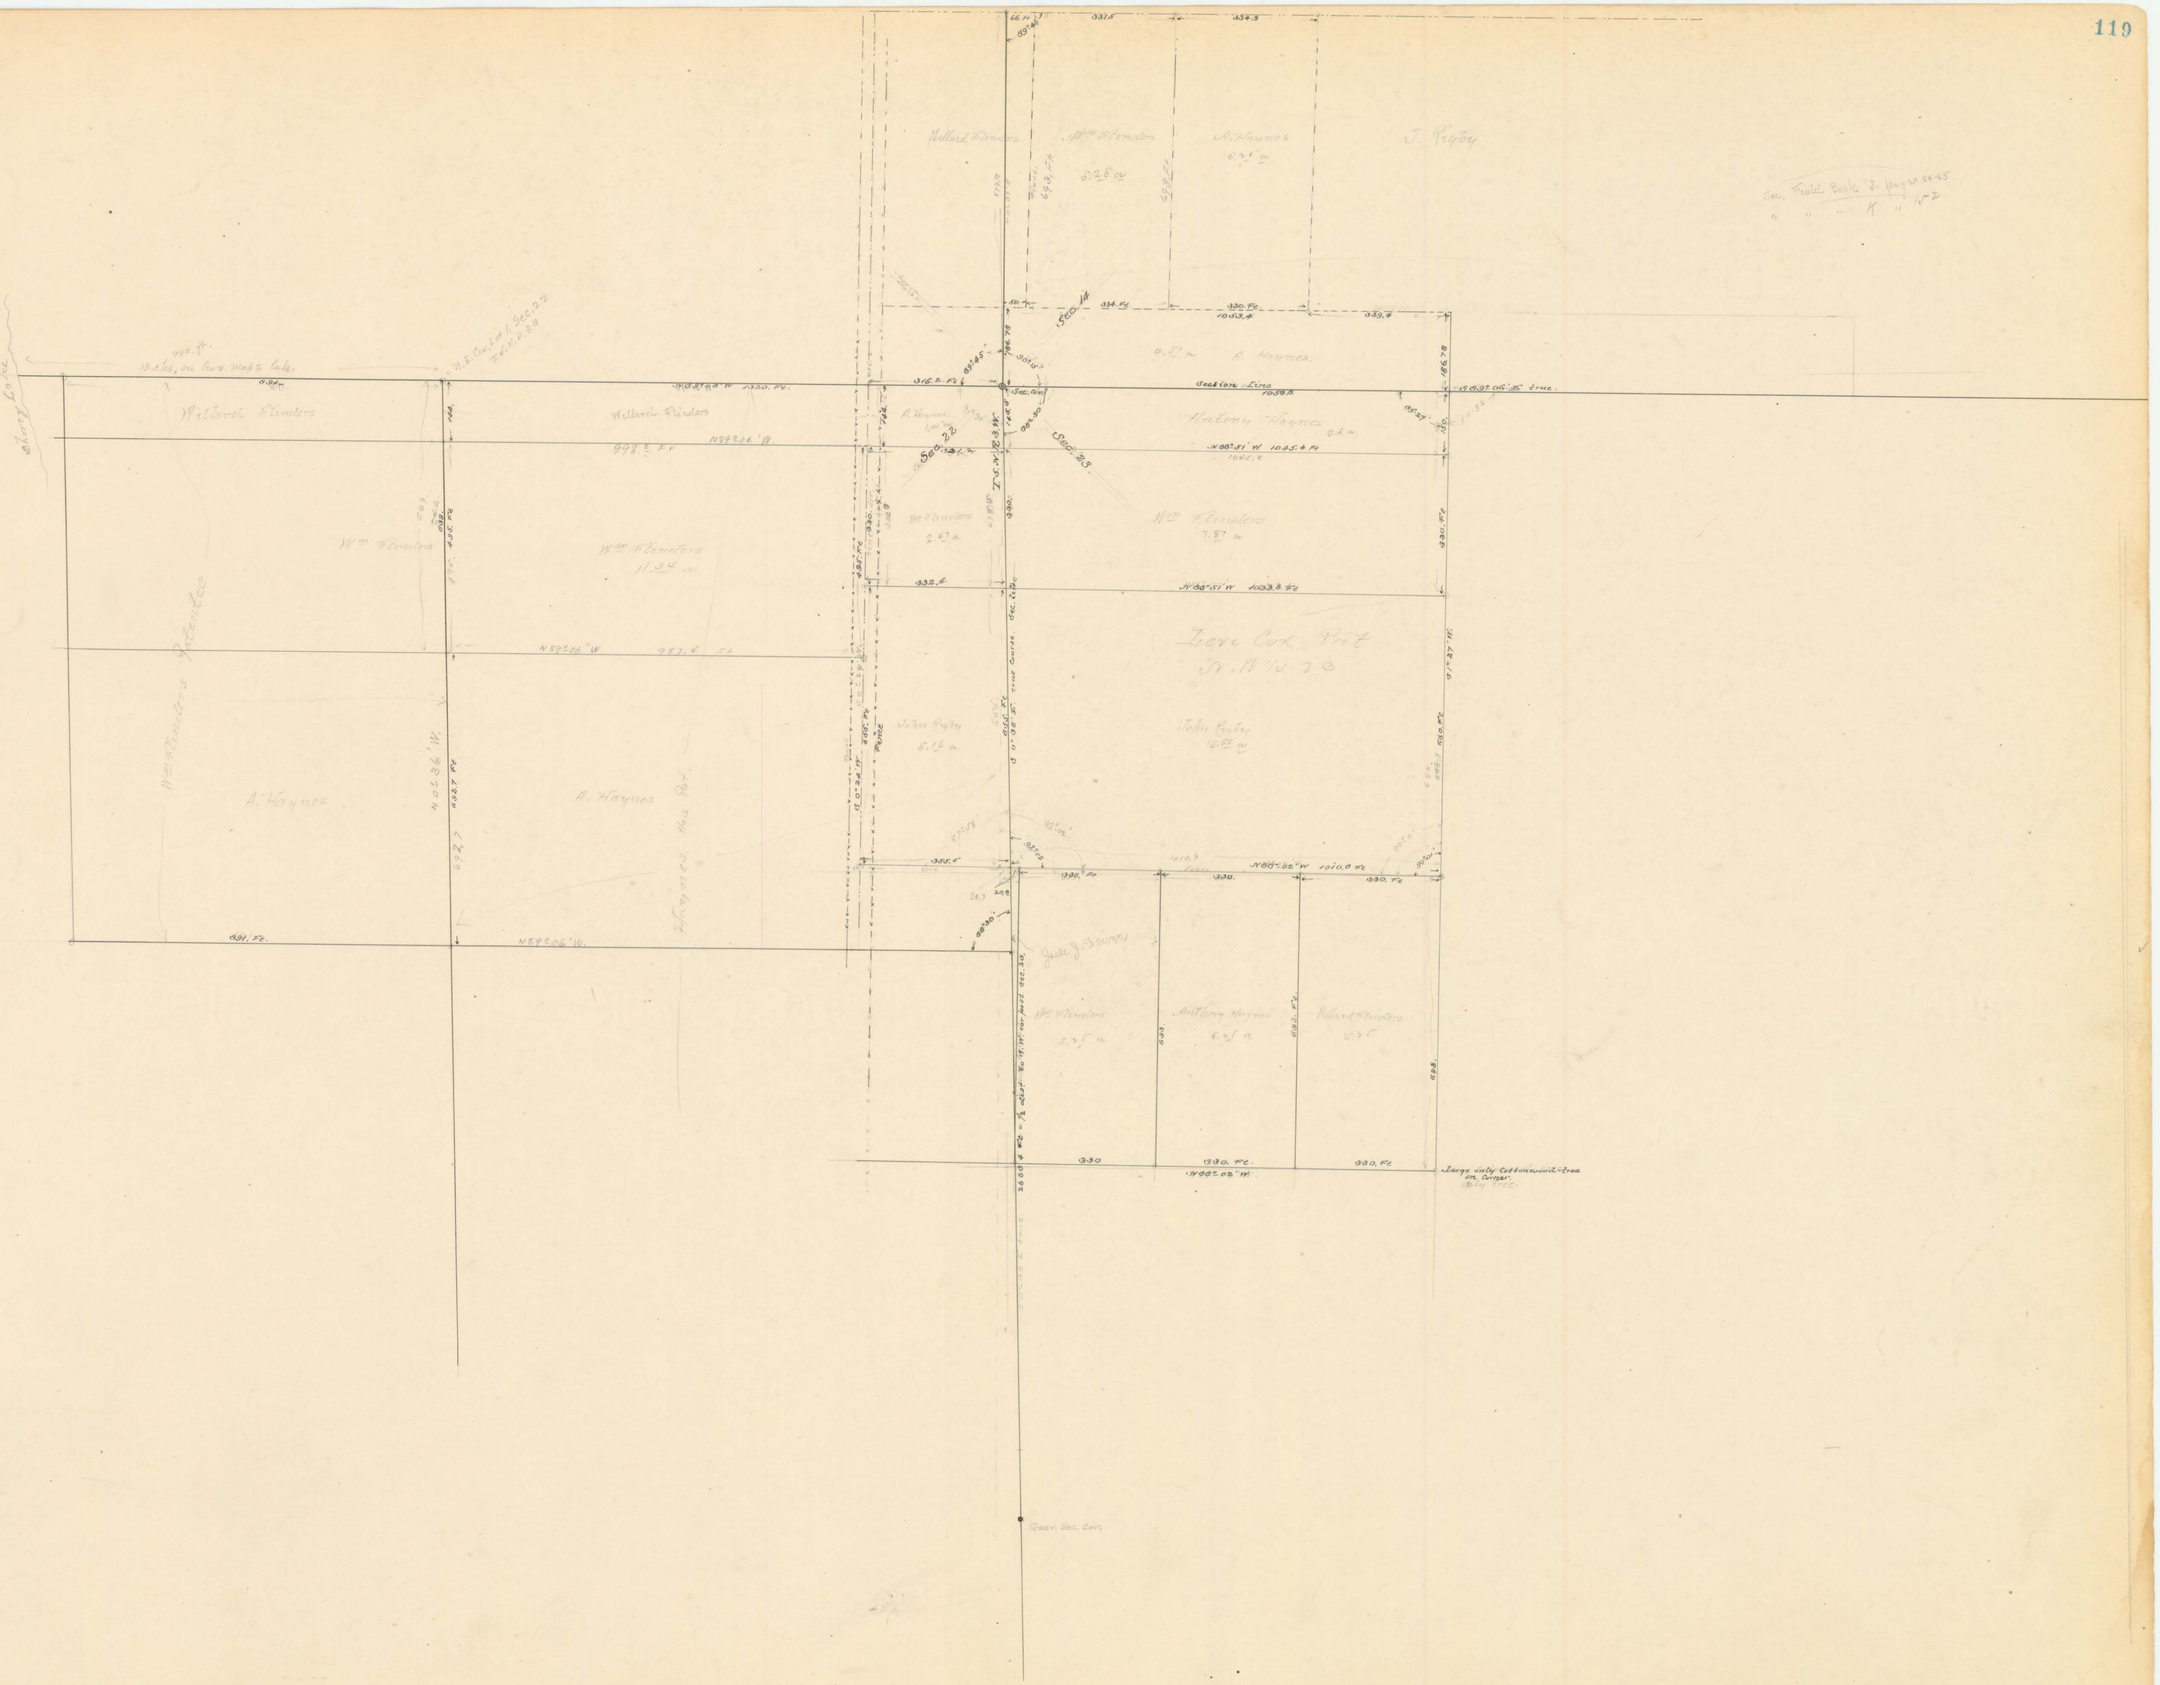
Willard Flinders
Wm Flinders
A. Haynes
J. Rigby
Section Line
Antony Haynes
Wm Flinders
Willard Flinders
A. Haynes
Wm Flinders
Willard Flinders
Antony Haynes
Wm Flinders
Willard Flinders
Wm Flinders Patentee
A. Haynes
A. Haynes
Haynes Hos Pat.
John Rigby
John Rigby
N89°06'W
N88°51'W
N88°02'W
Large sixty Cottonwood Tree on Corner
Quar. Sec. Cor.

Tp 5 N — R. 3 W