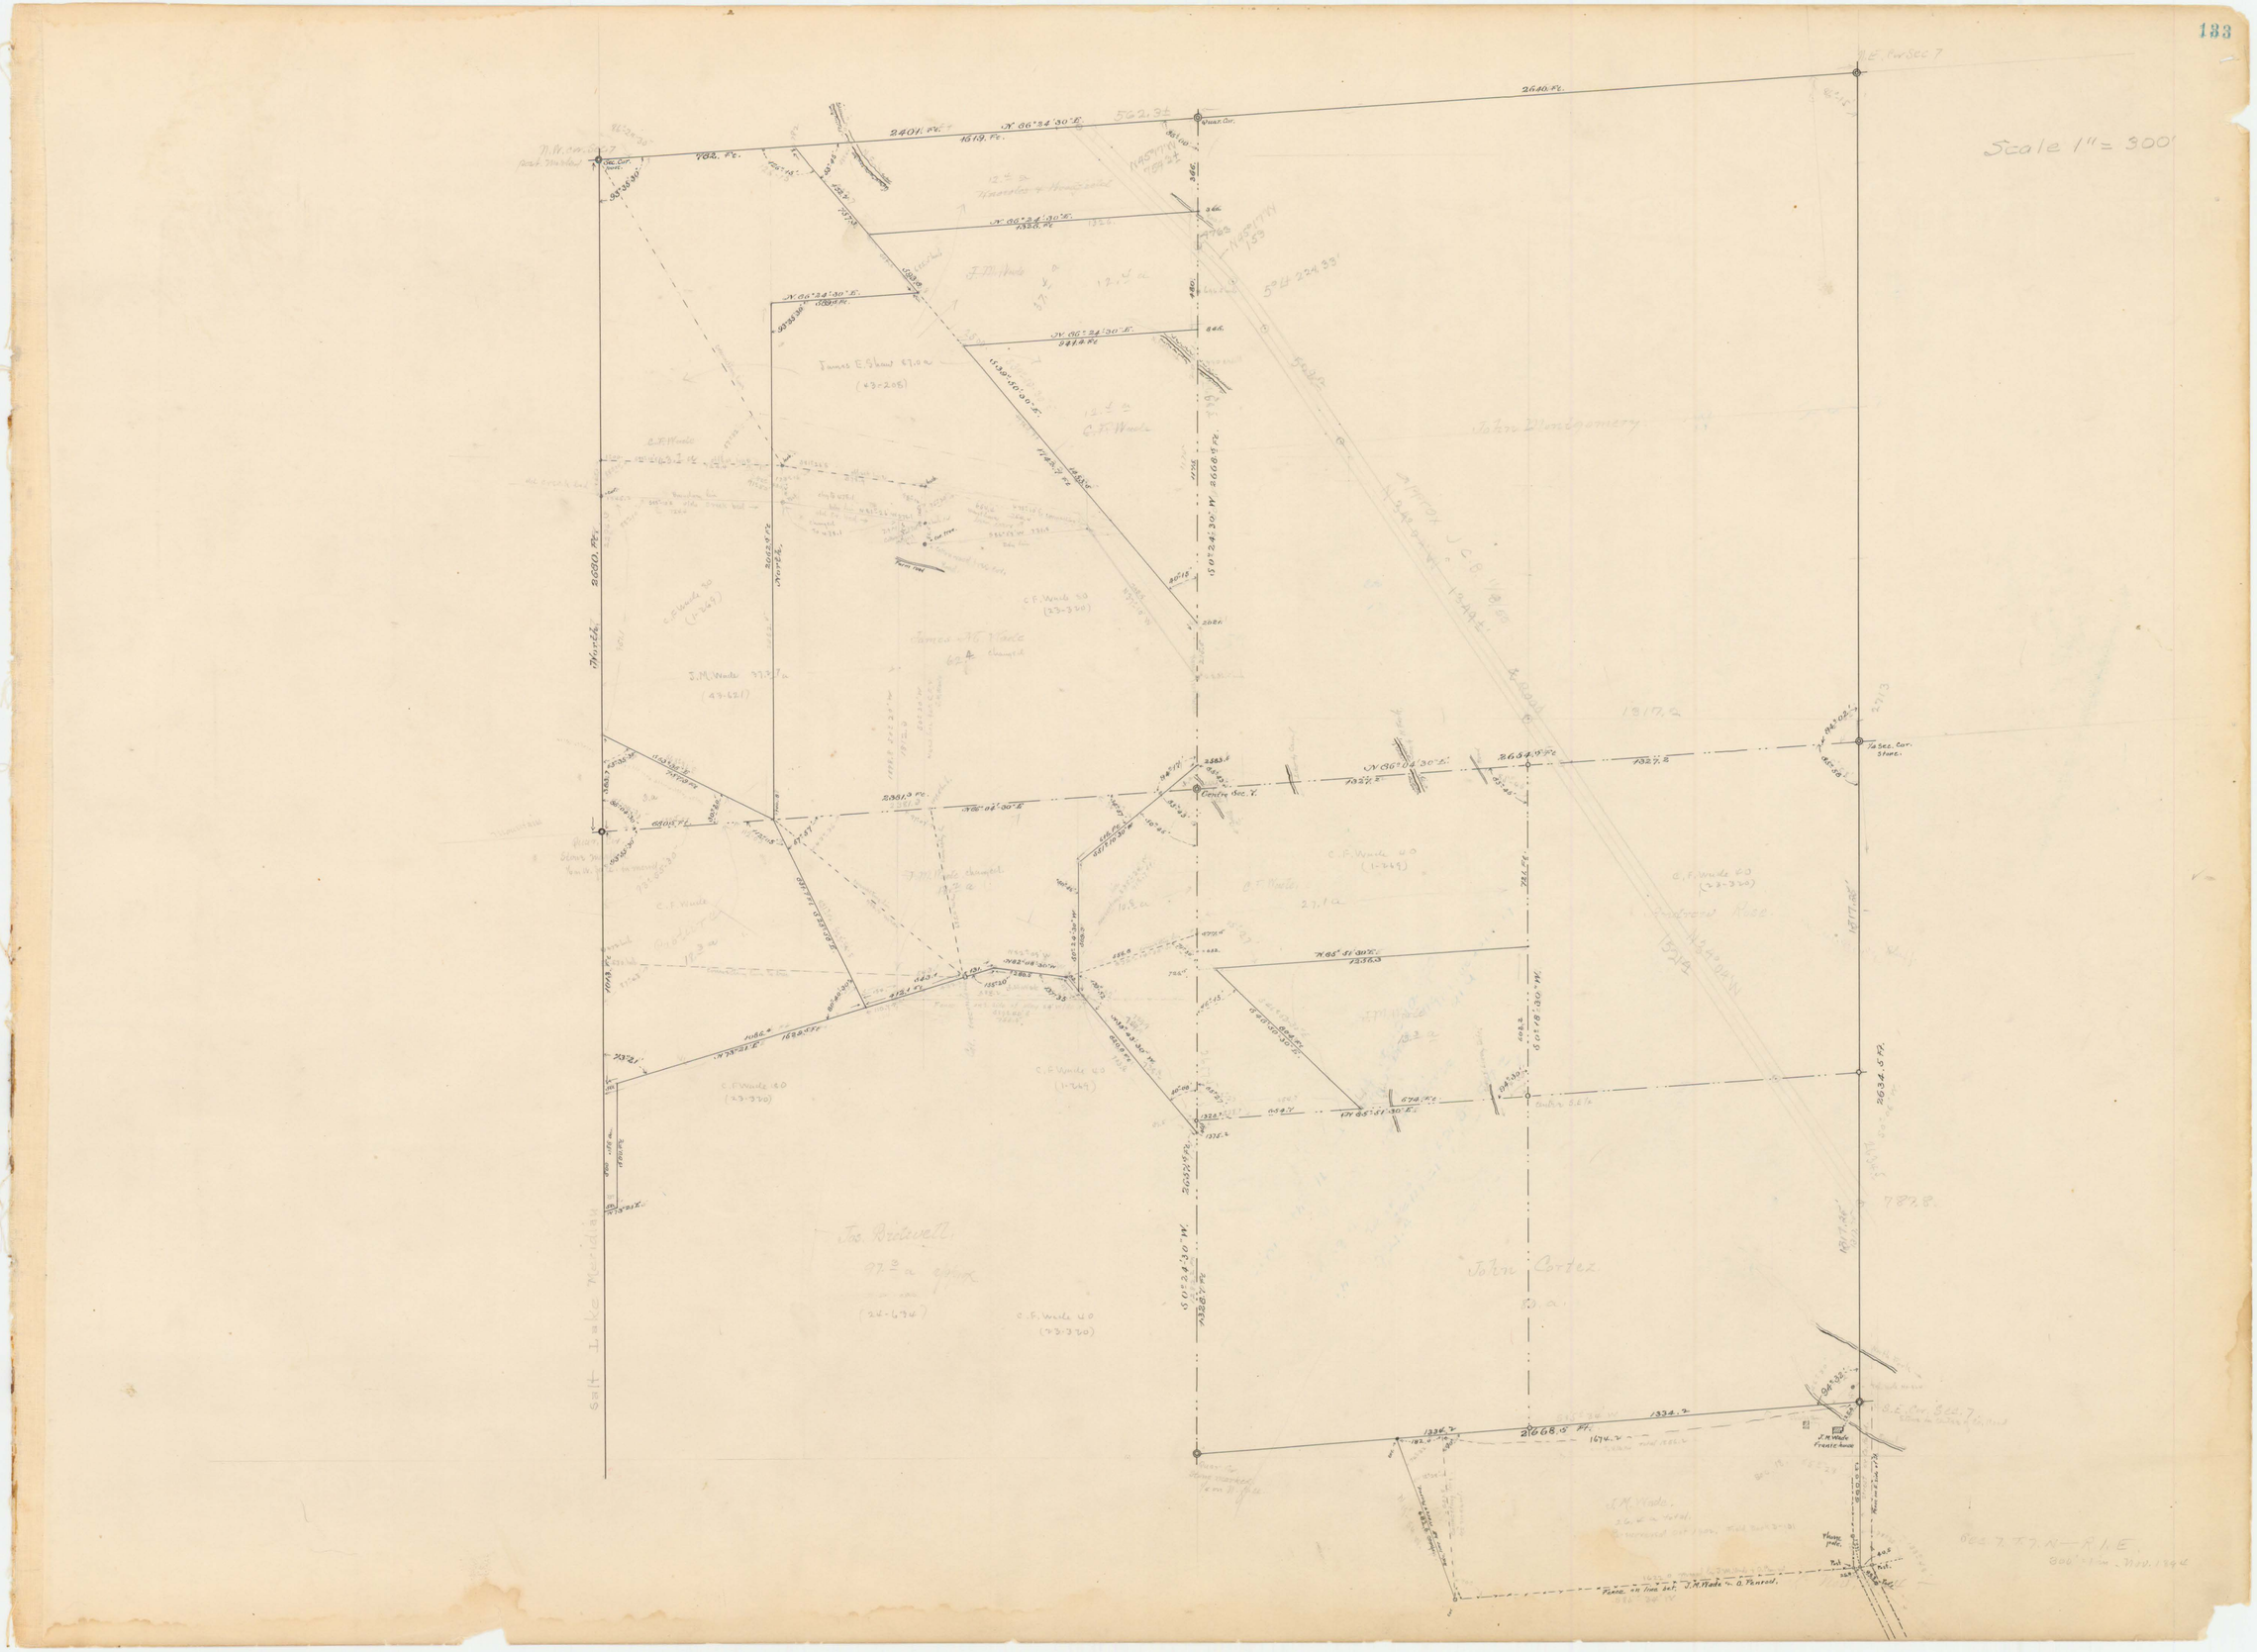
Scale 1" = 300'
John Montgomery
Jos. Bridwell
John Cortez
Salt Lake Meridian
Centre Sec. 7
Quar. Cor.
Sec. 7 T. 7 N. — R. 1 E.