

Old








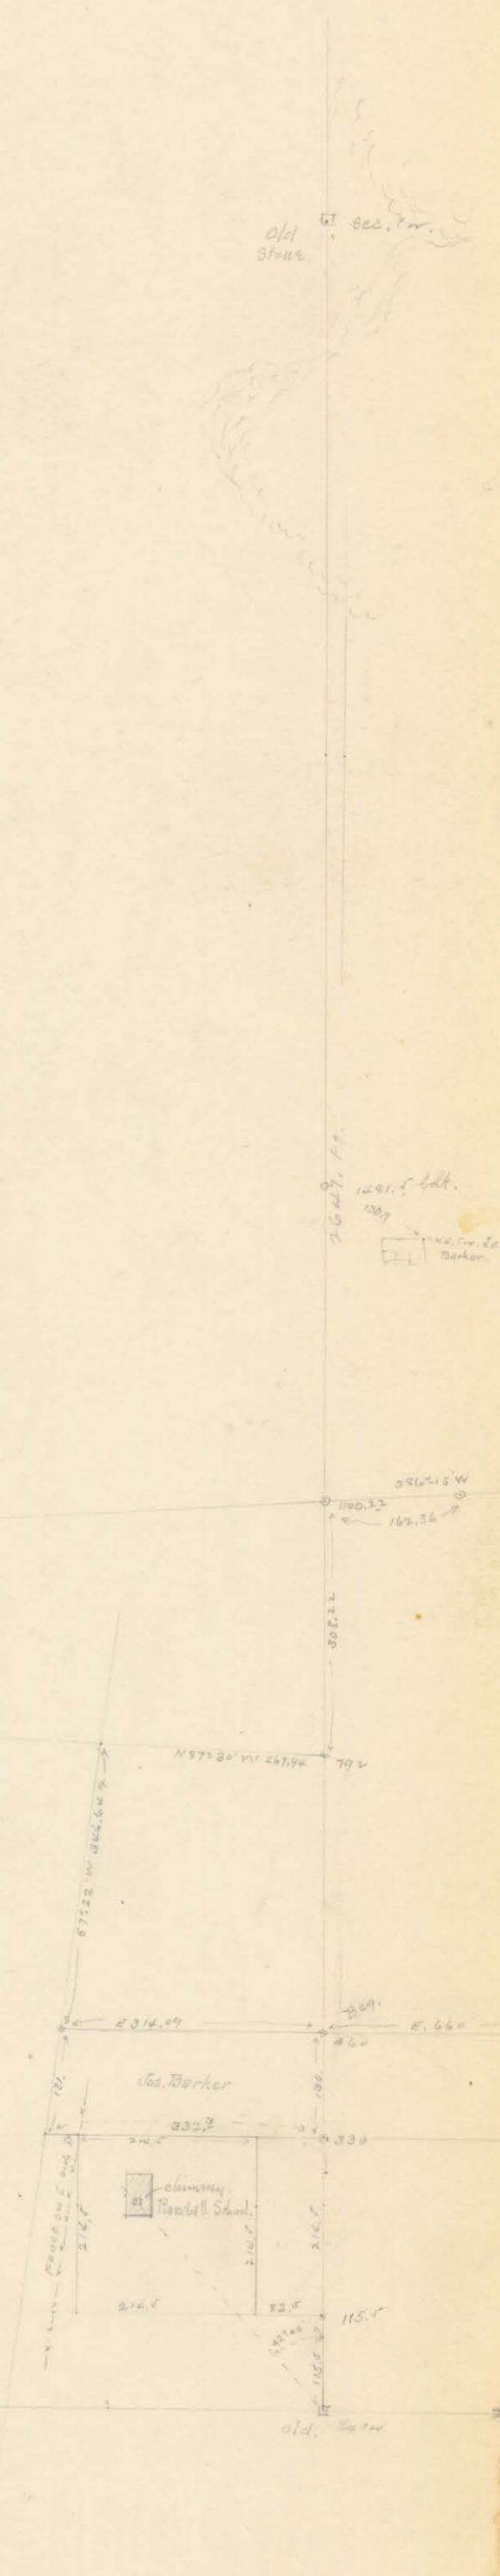

N 1/2 of Sec 4 T₆N - R. 1 W