

For 1/2 Sec. 23
See page 123B.

N 20° 10' 30" W
2500 ft.
2500 ft. 1999

For 1/2
Sec 24
See page
120

2737, 1st point where
road to road begins
turning to S.

2547.5 ft. in from
2573 road grade
2547

For 5/8
Sec 24
See page 108

N 01° 49' 30" E true curve 2562.20 ft. 1/2 dist.


stake

2640 ft.

2025 ft.
S.W. 1/4 Sec. 23
Tp. 6 N - R. 2 W.

Total 3263 ft.

2640
(2630.4)

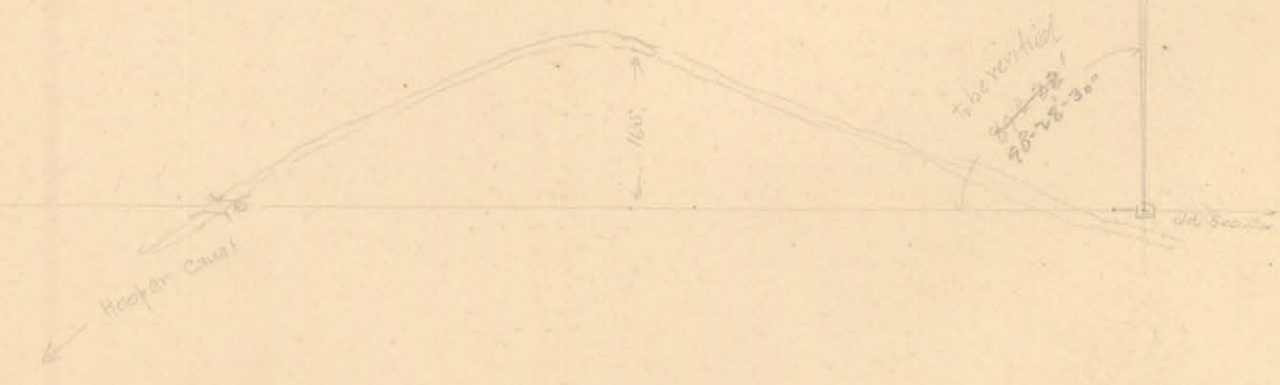

S 1/2 of Sec. 23 Tp. 6 N - R. 2 W.
Scale 200 ft. = 1 in.