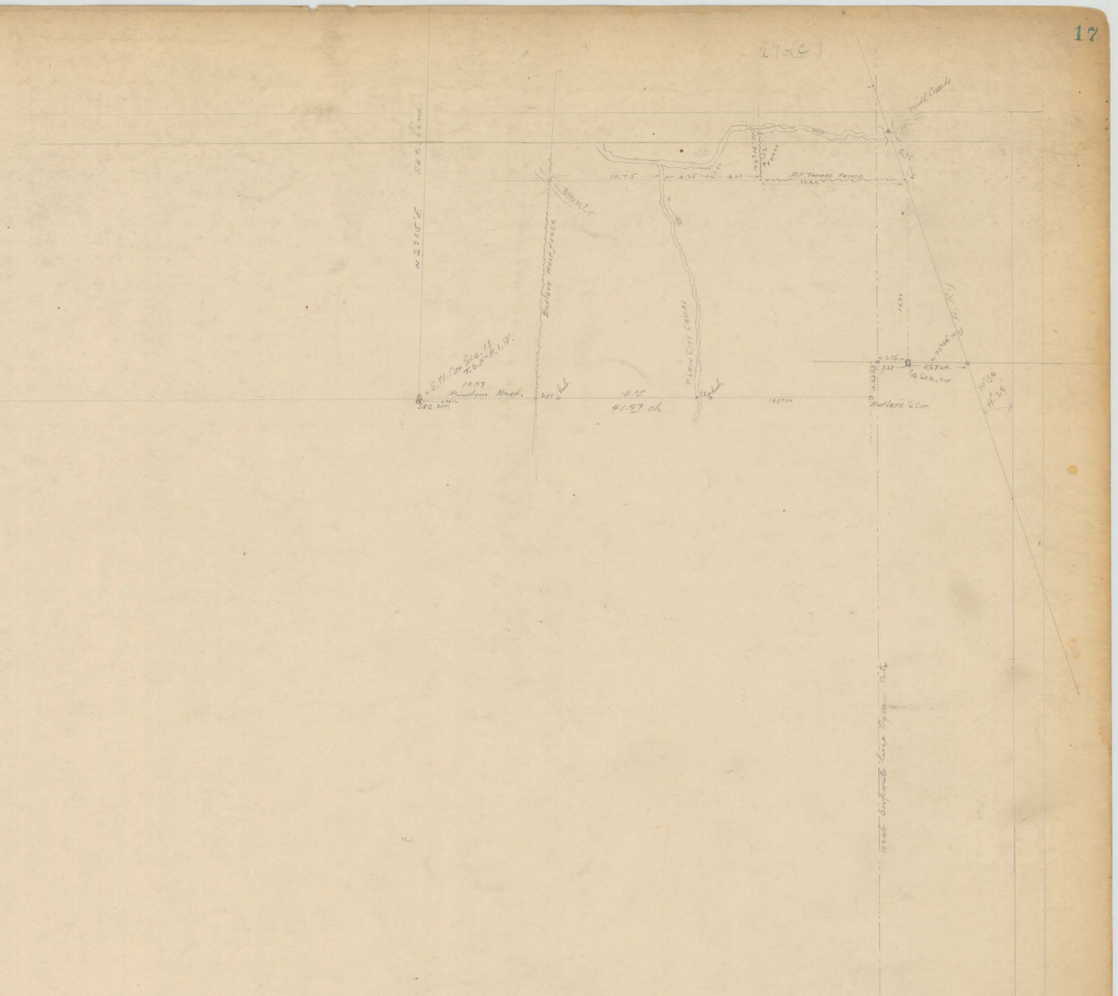
27 x C
Butlers Con.
