


Map of H.H. Holley's survey for G. Griffith & others Sept 26-1870-

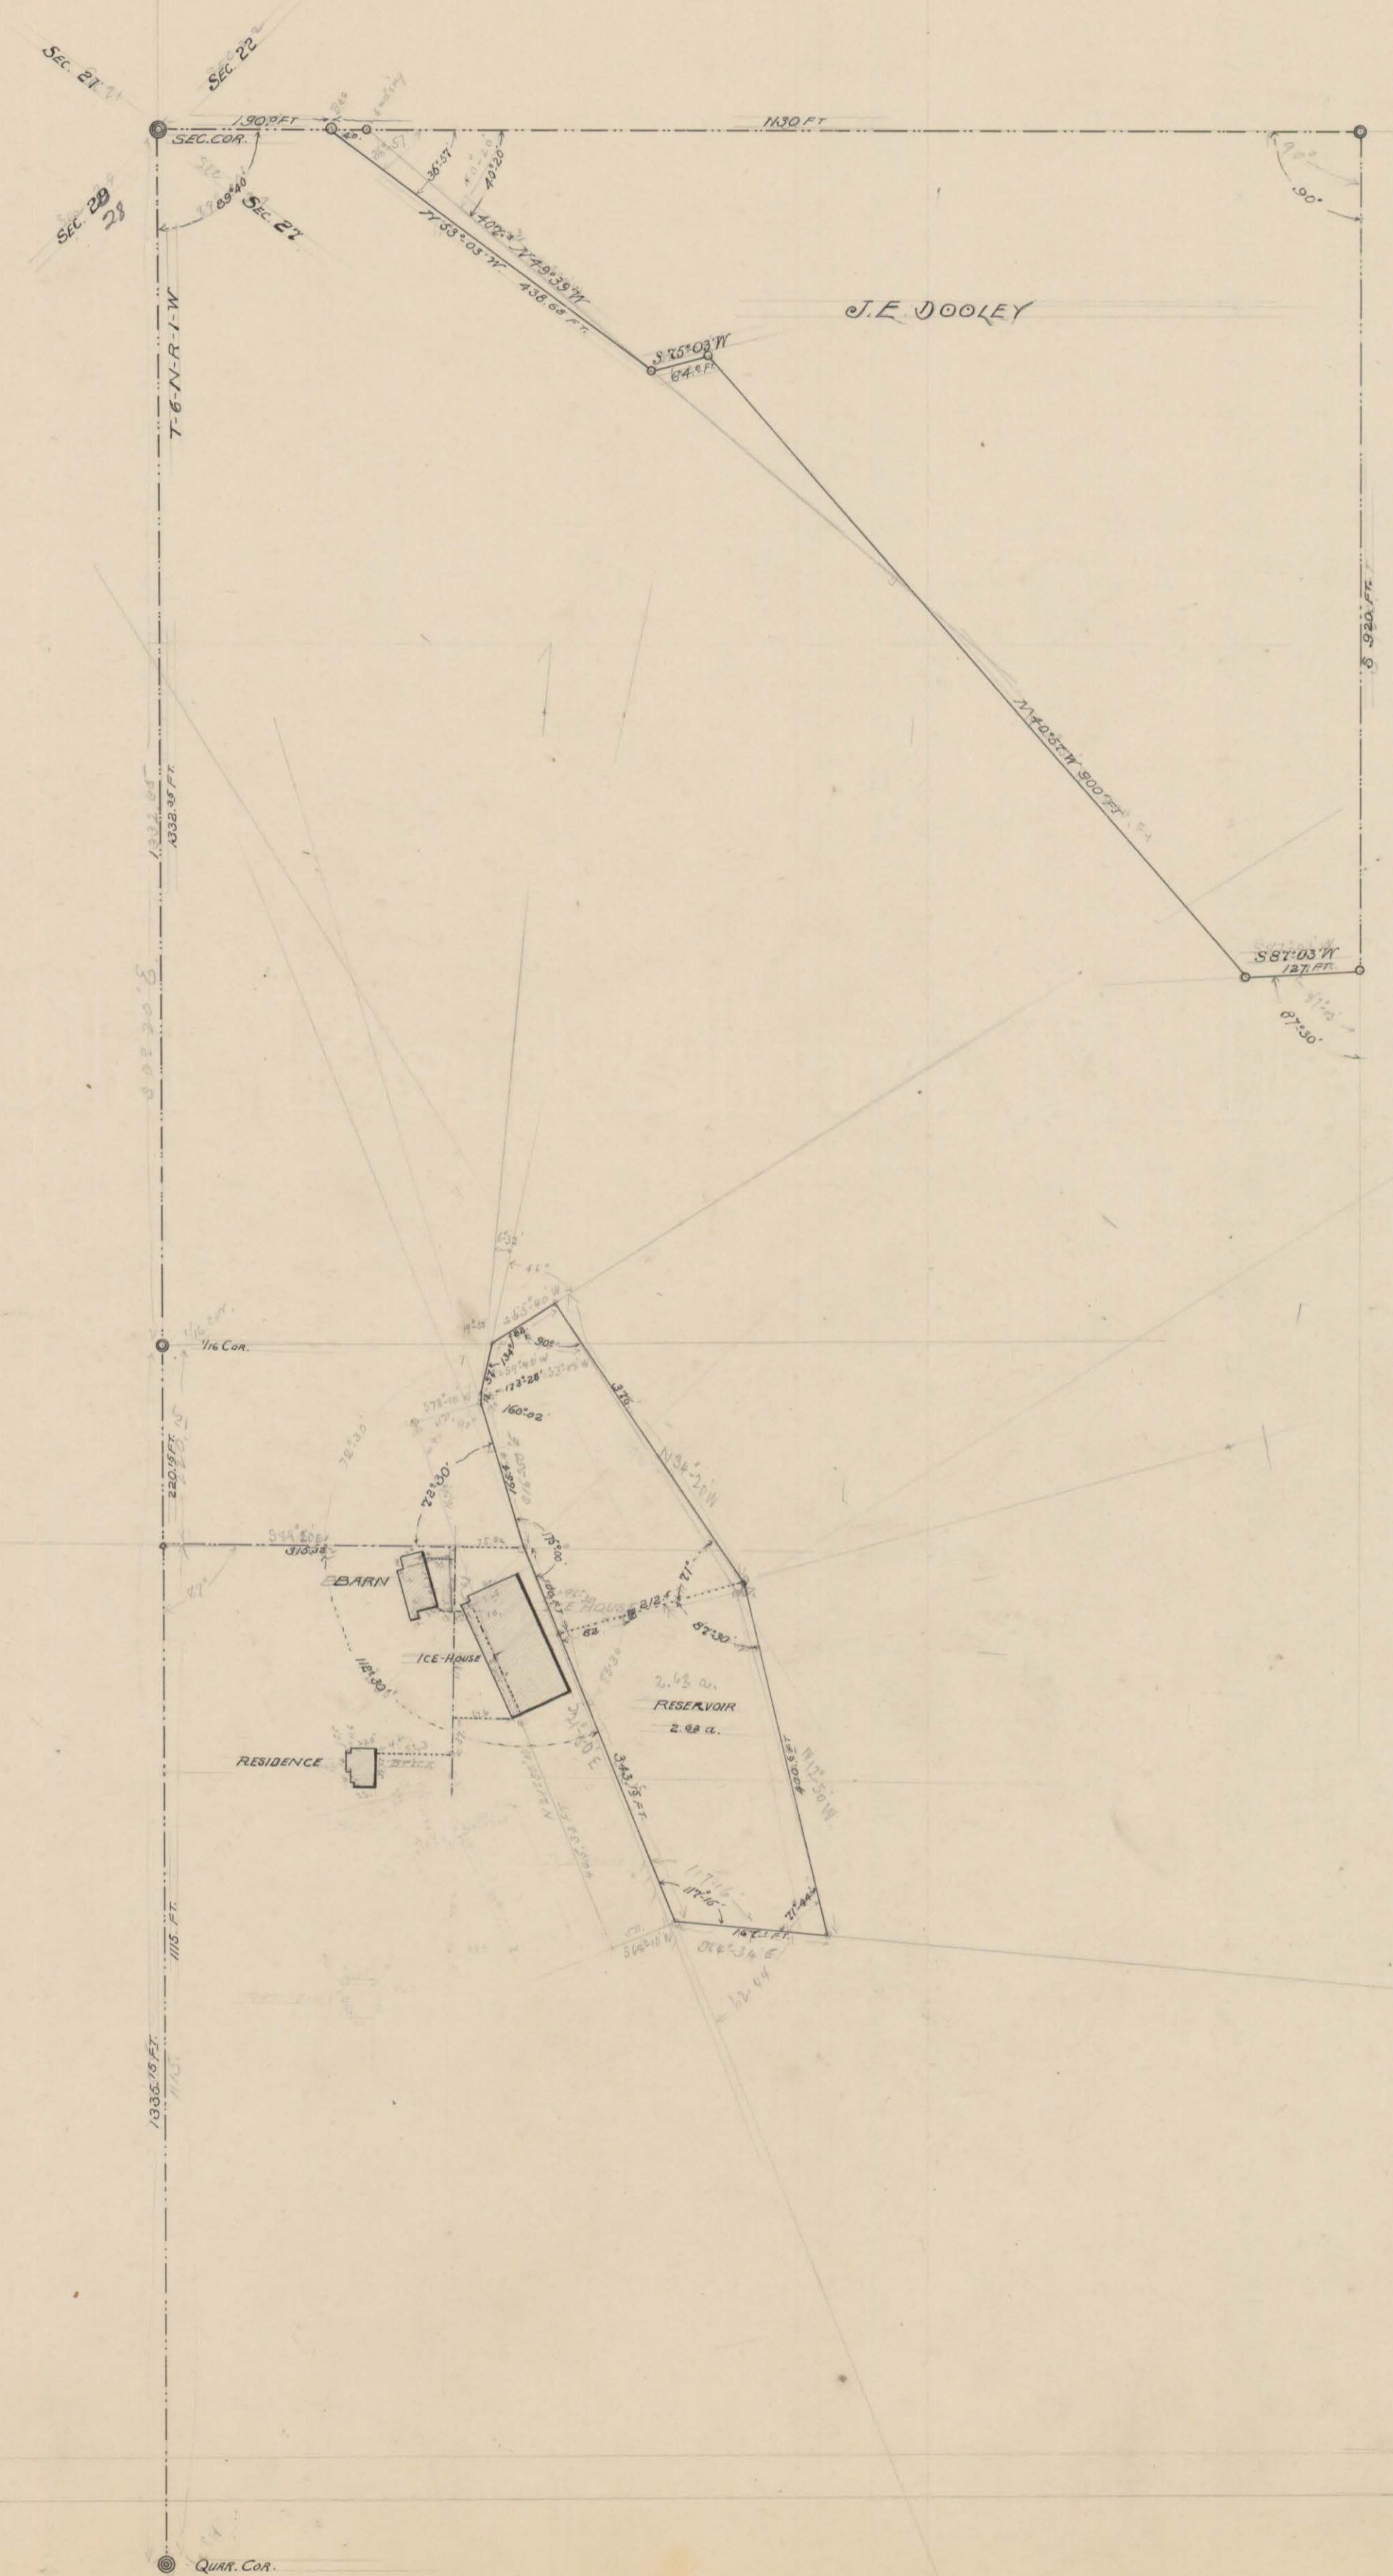

Scale 100 ft = 1 in.