


v. 100

Hartley to J.L. Wilson = 0.744
 Funk to Nelson = 0.126
 " " " = 0.029
 Hartley to Funk = 0.333

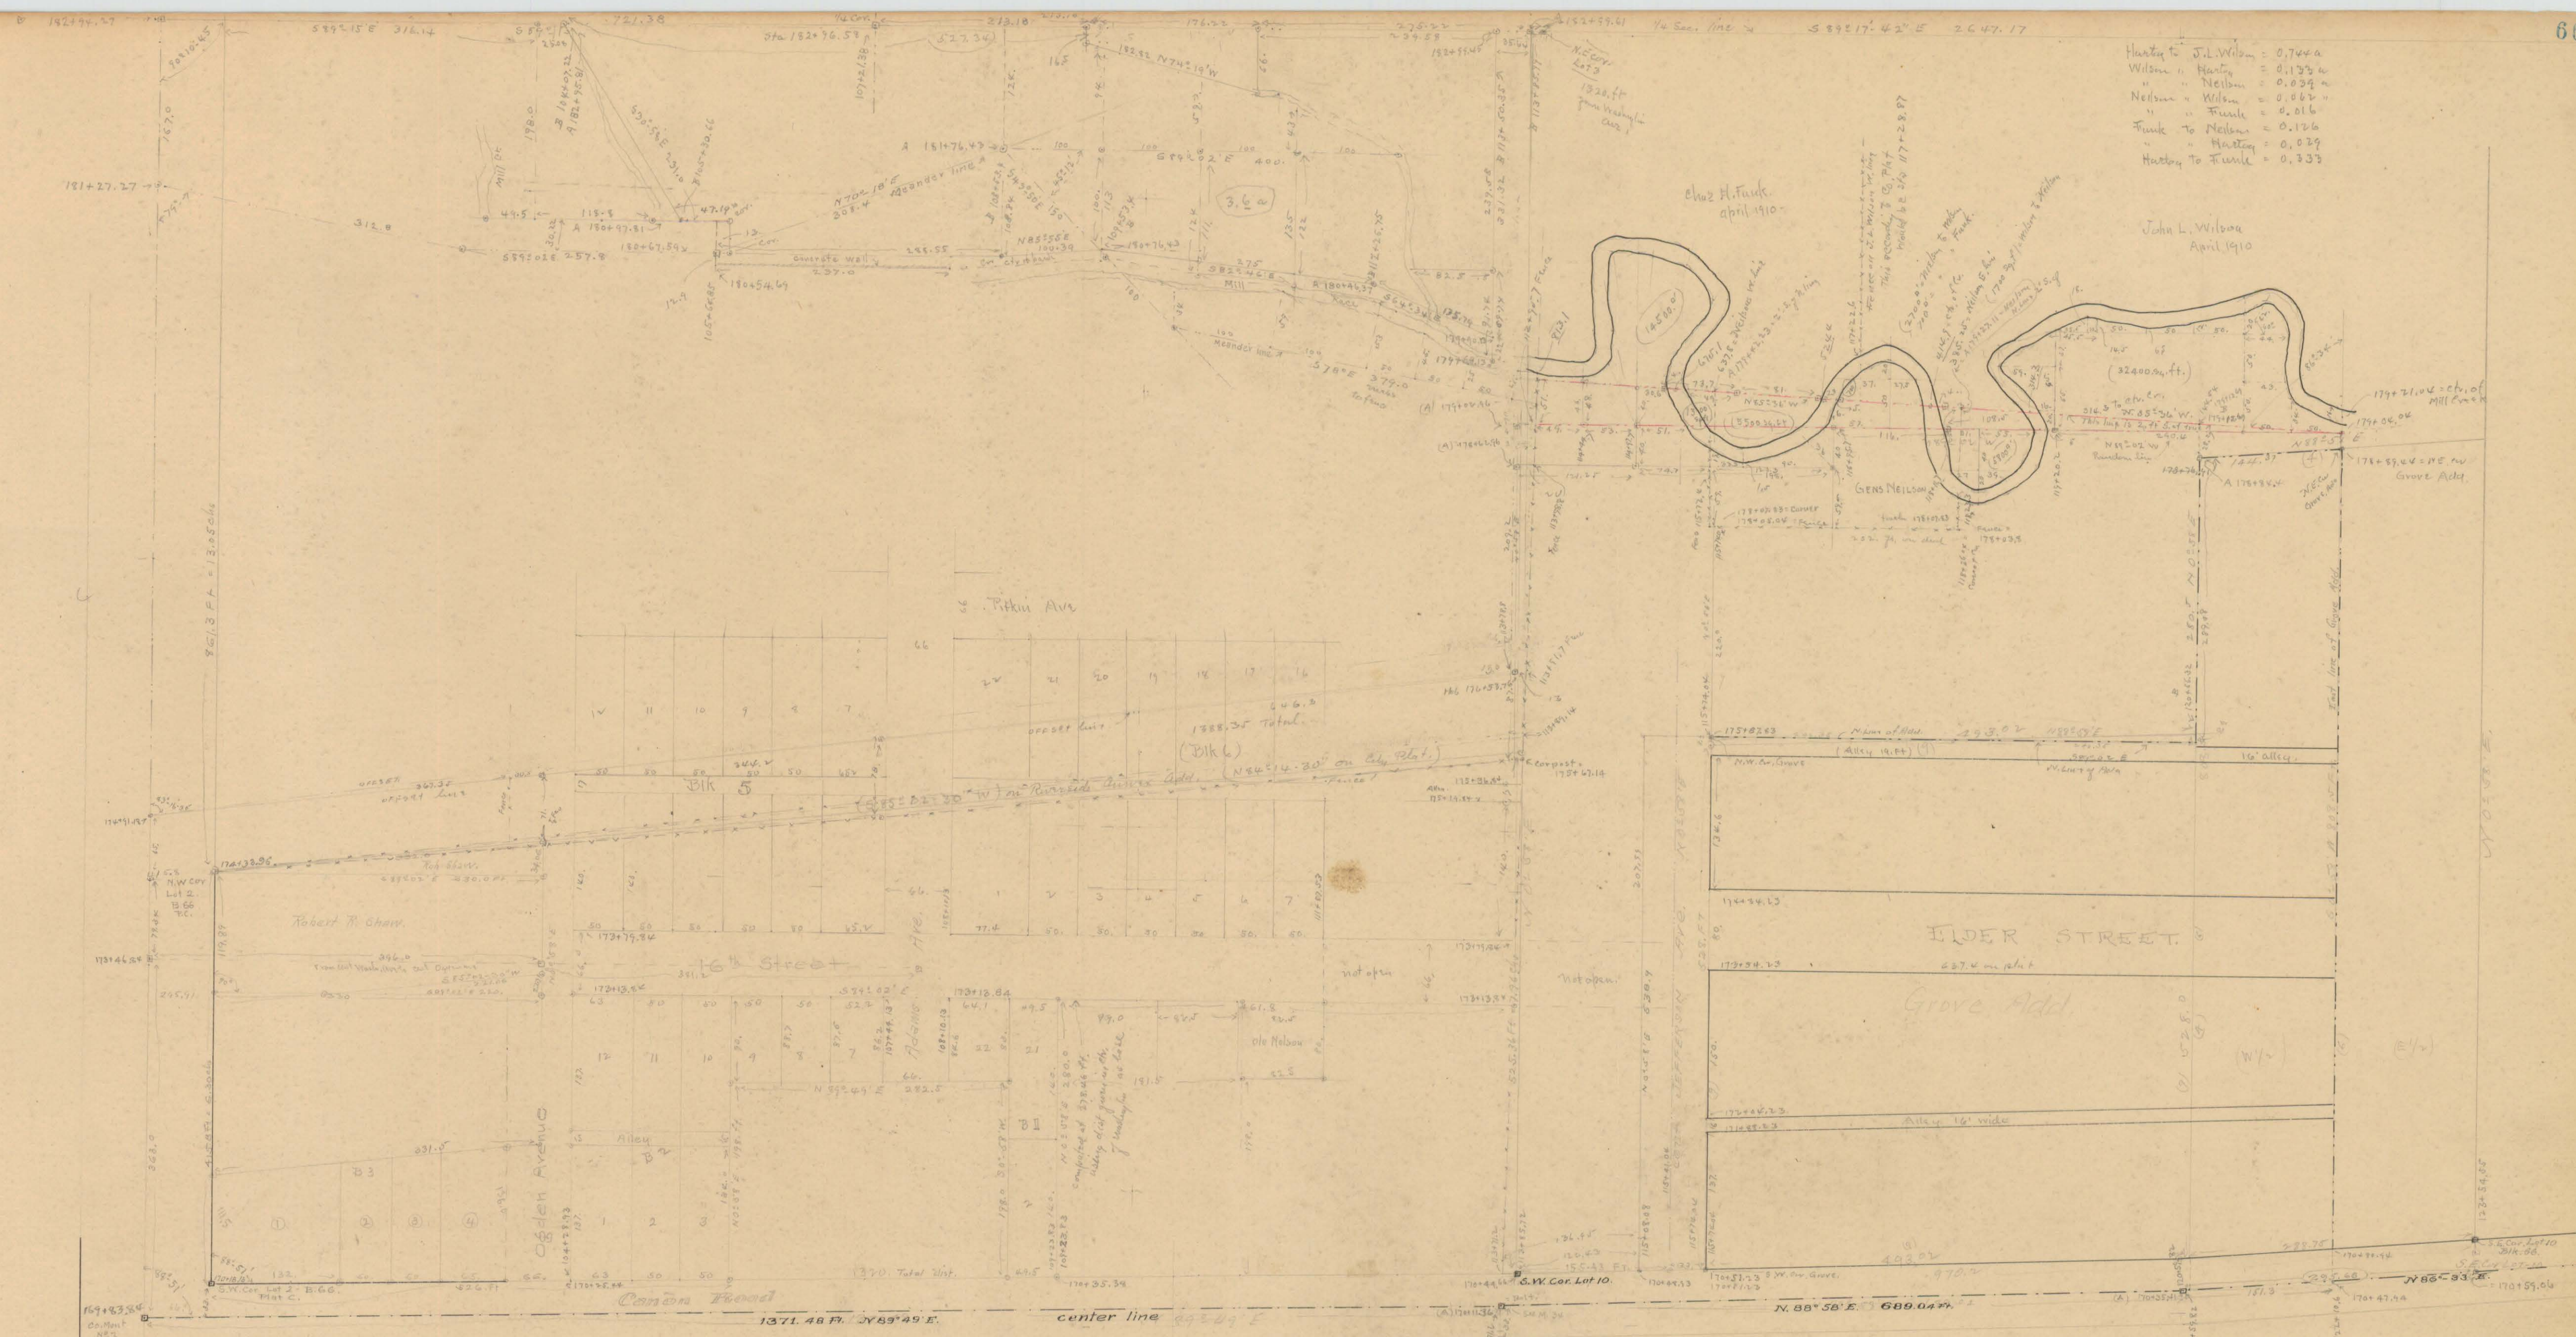

Washington Ave

Fire side Add.

with map in Detail of Grove Addition