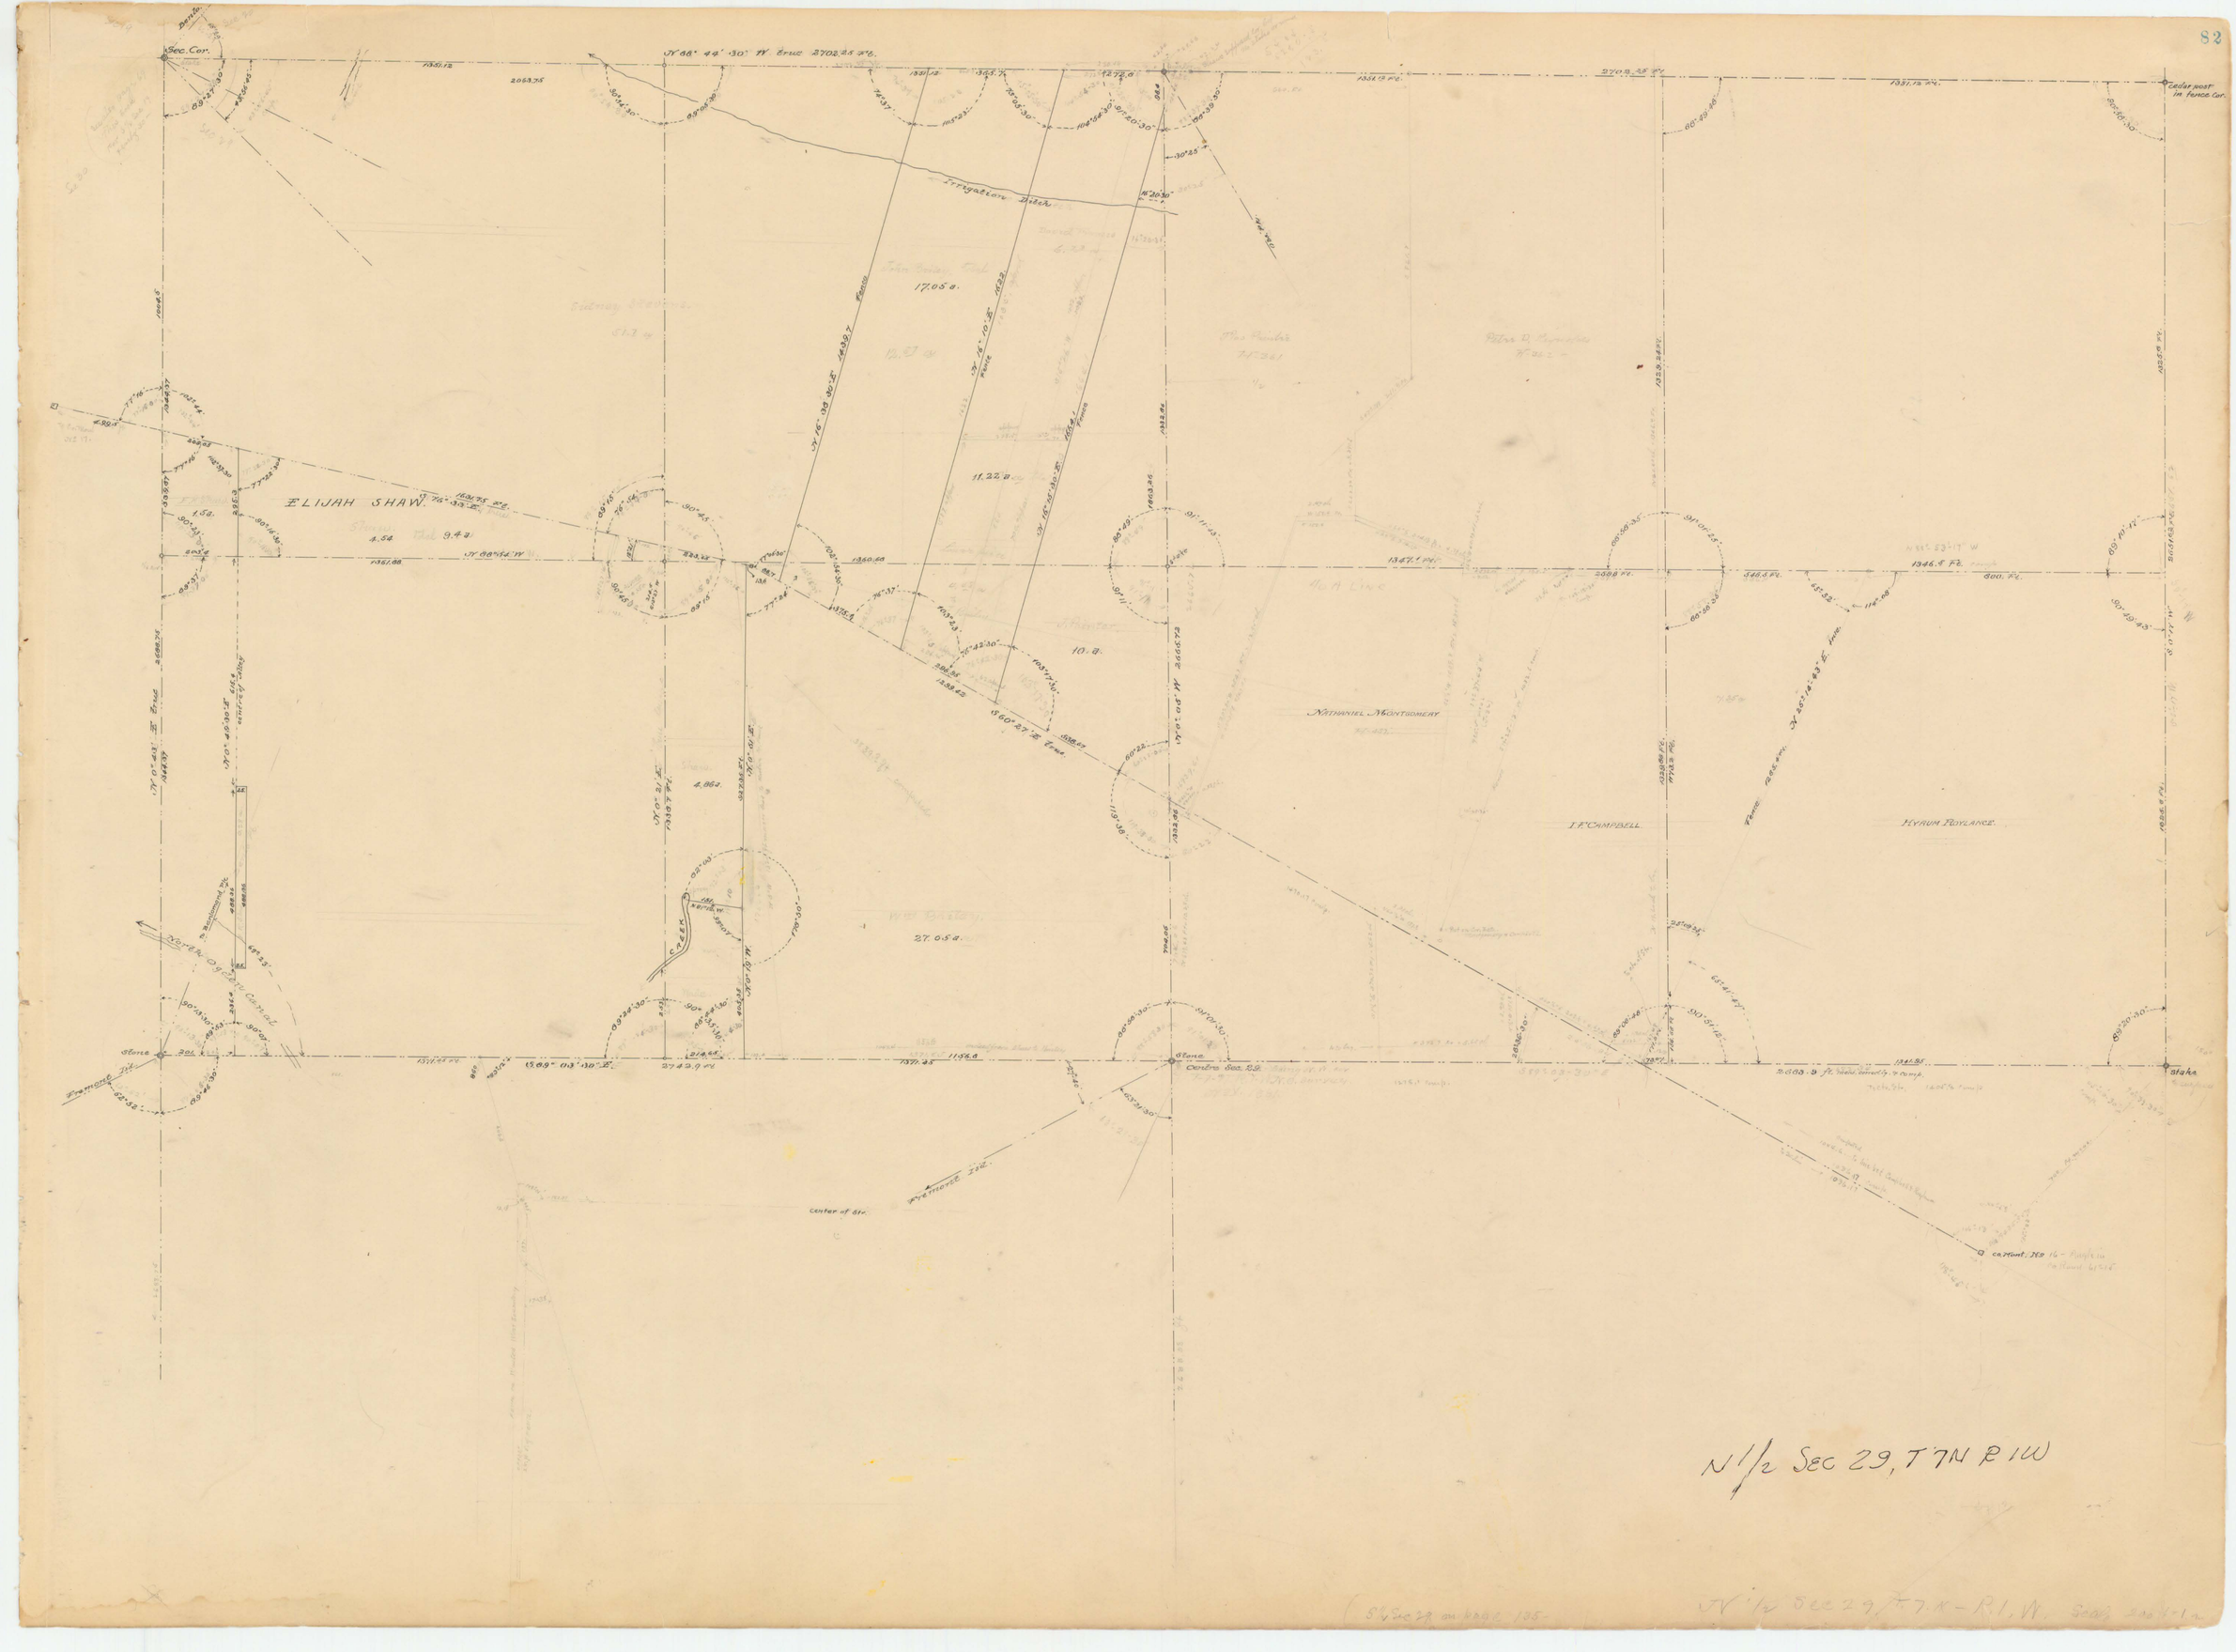

(S½ Sec 29 on page 105

N ½ Sec 29, T 7 N - R 1 W. Scale 2 in = 1 m