


BROWNING

151.66' 519.000 M.P.D.
FIVE POINTS BR.

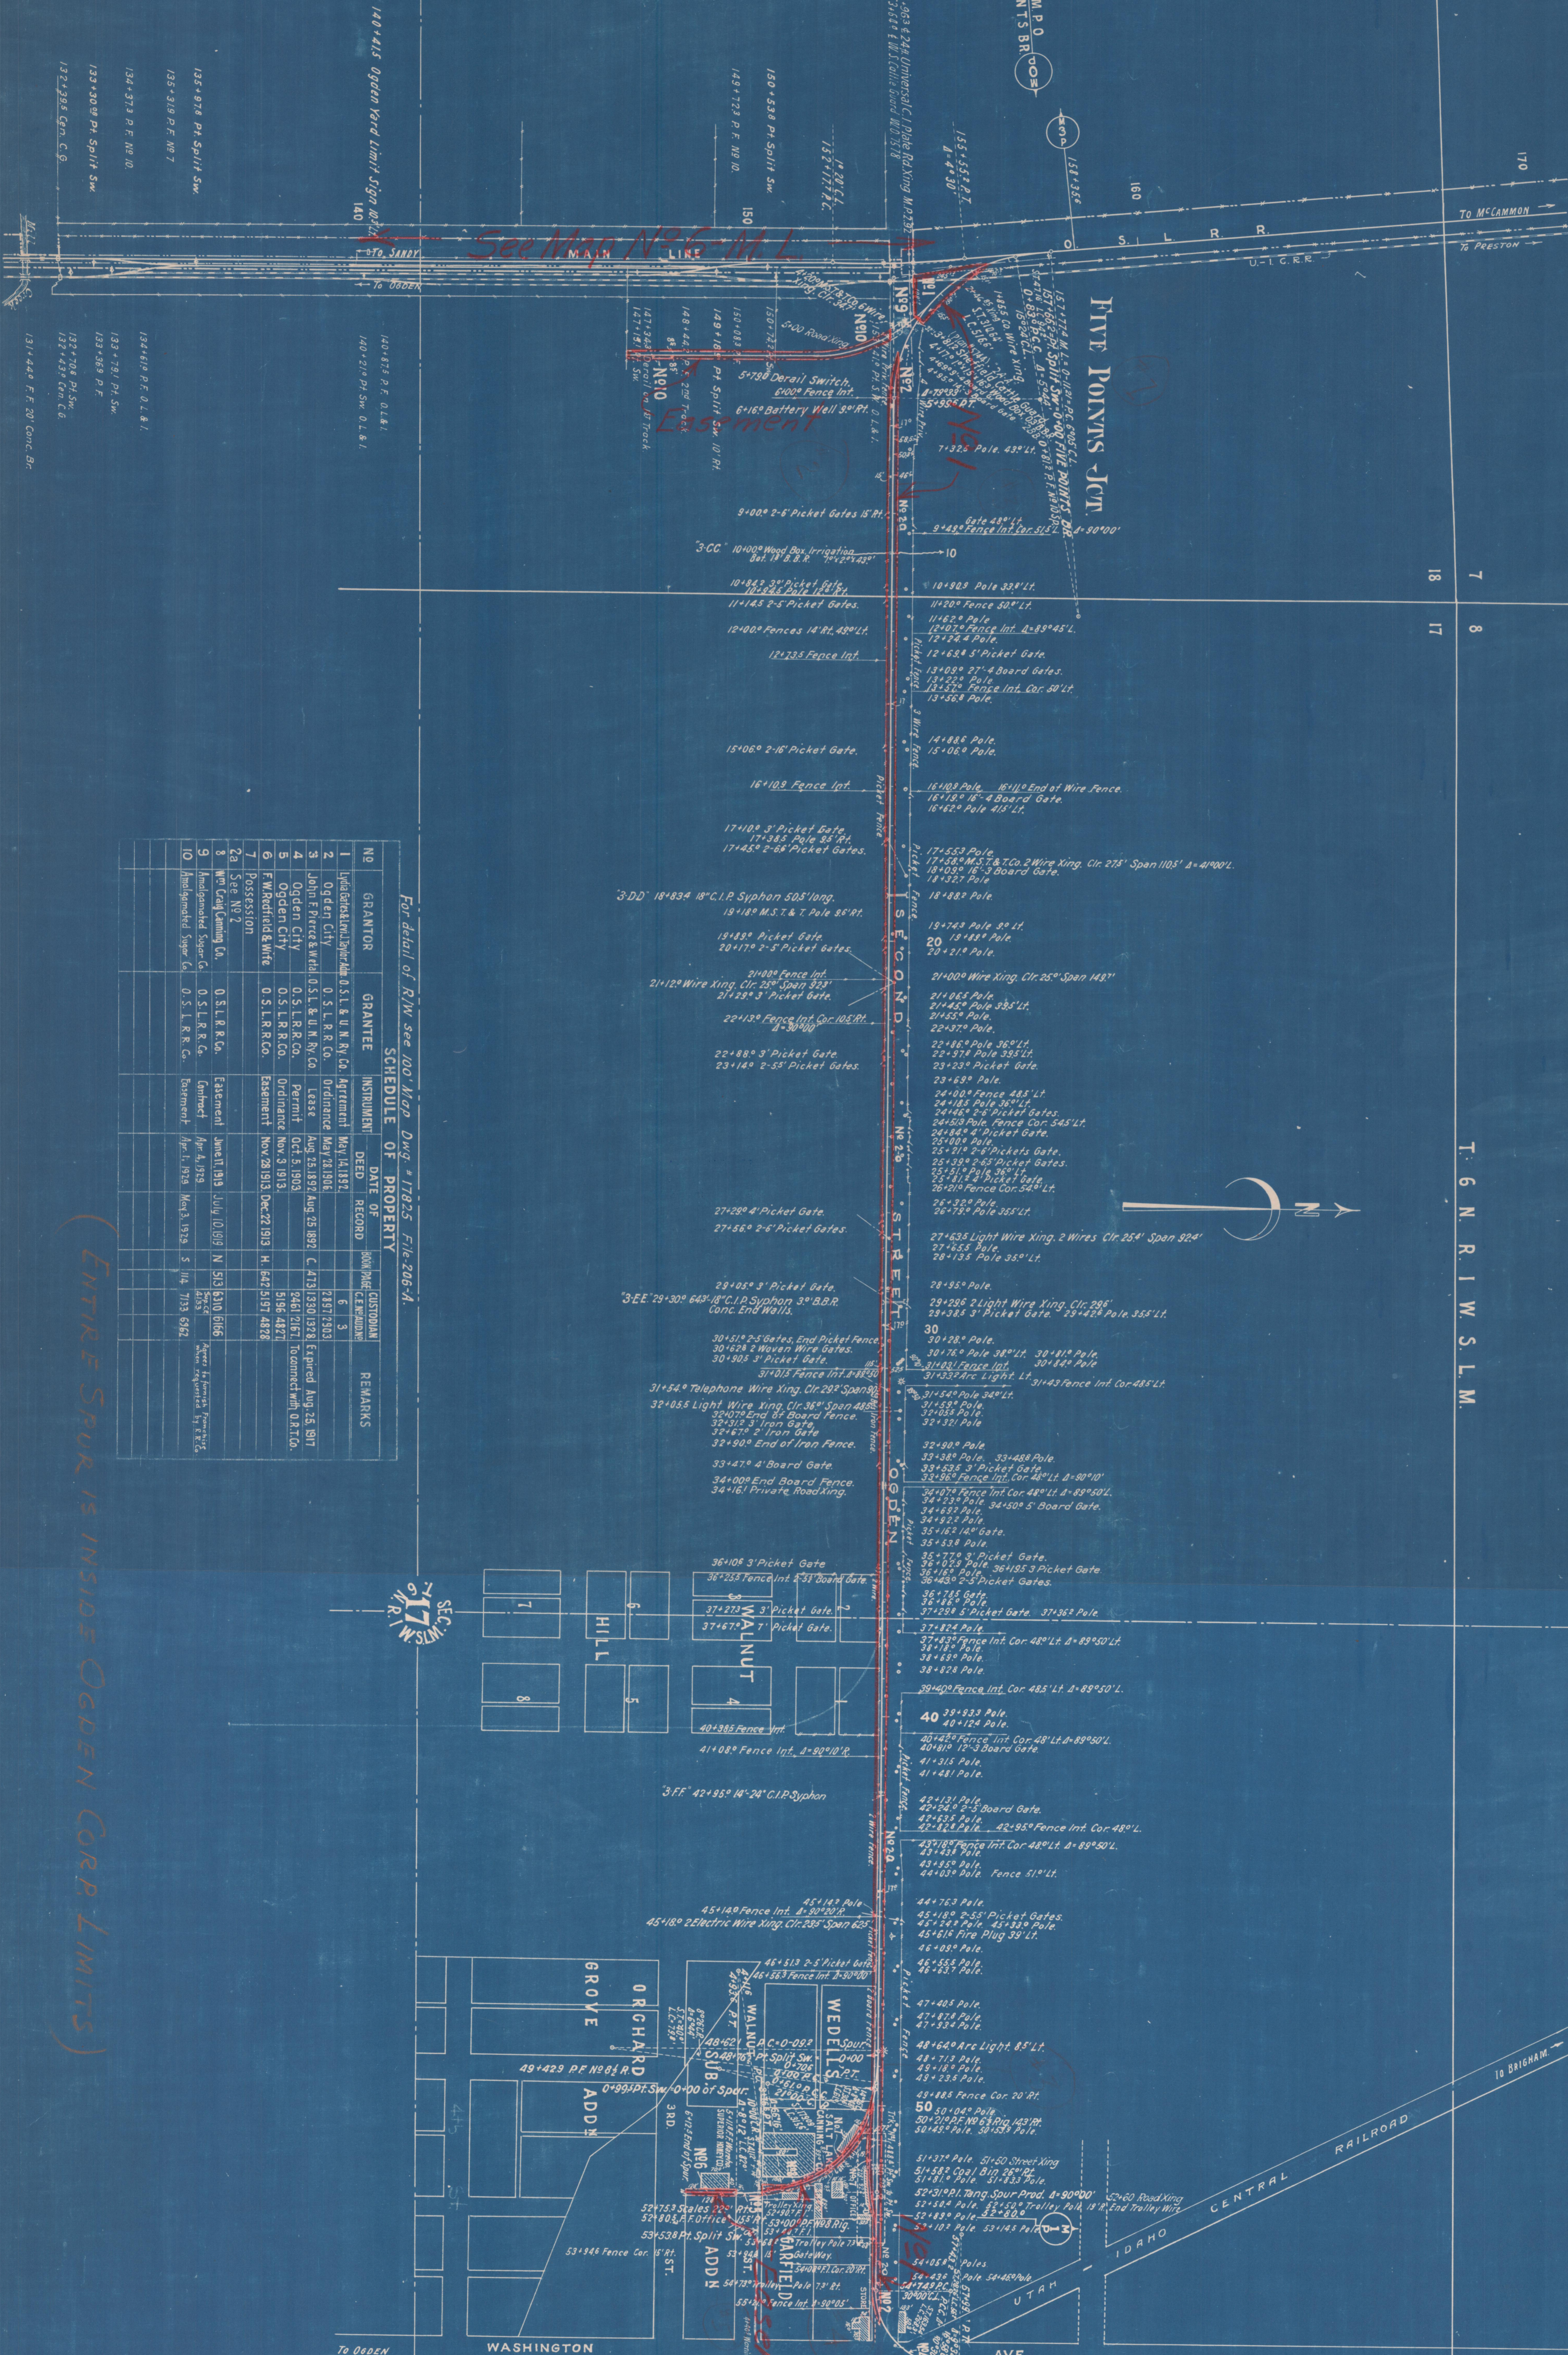

1404415 Ogden Road Limit Sign

For detail of R/W see 100' Map Dwg. # 17225, File 206-A.

NO	GRANTOR	GRANTEE	INSTRUMENT	DATE OF RECORD	RECORD	REMARKS

ENTIRE SPUR IS INSIDE ODGEN CORP. LIMITS

T 6 N R I W S L M

WEBER COUNTY
FIVE POINTS BRANCH
MAP NO. 1