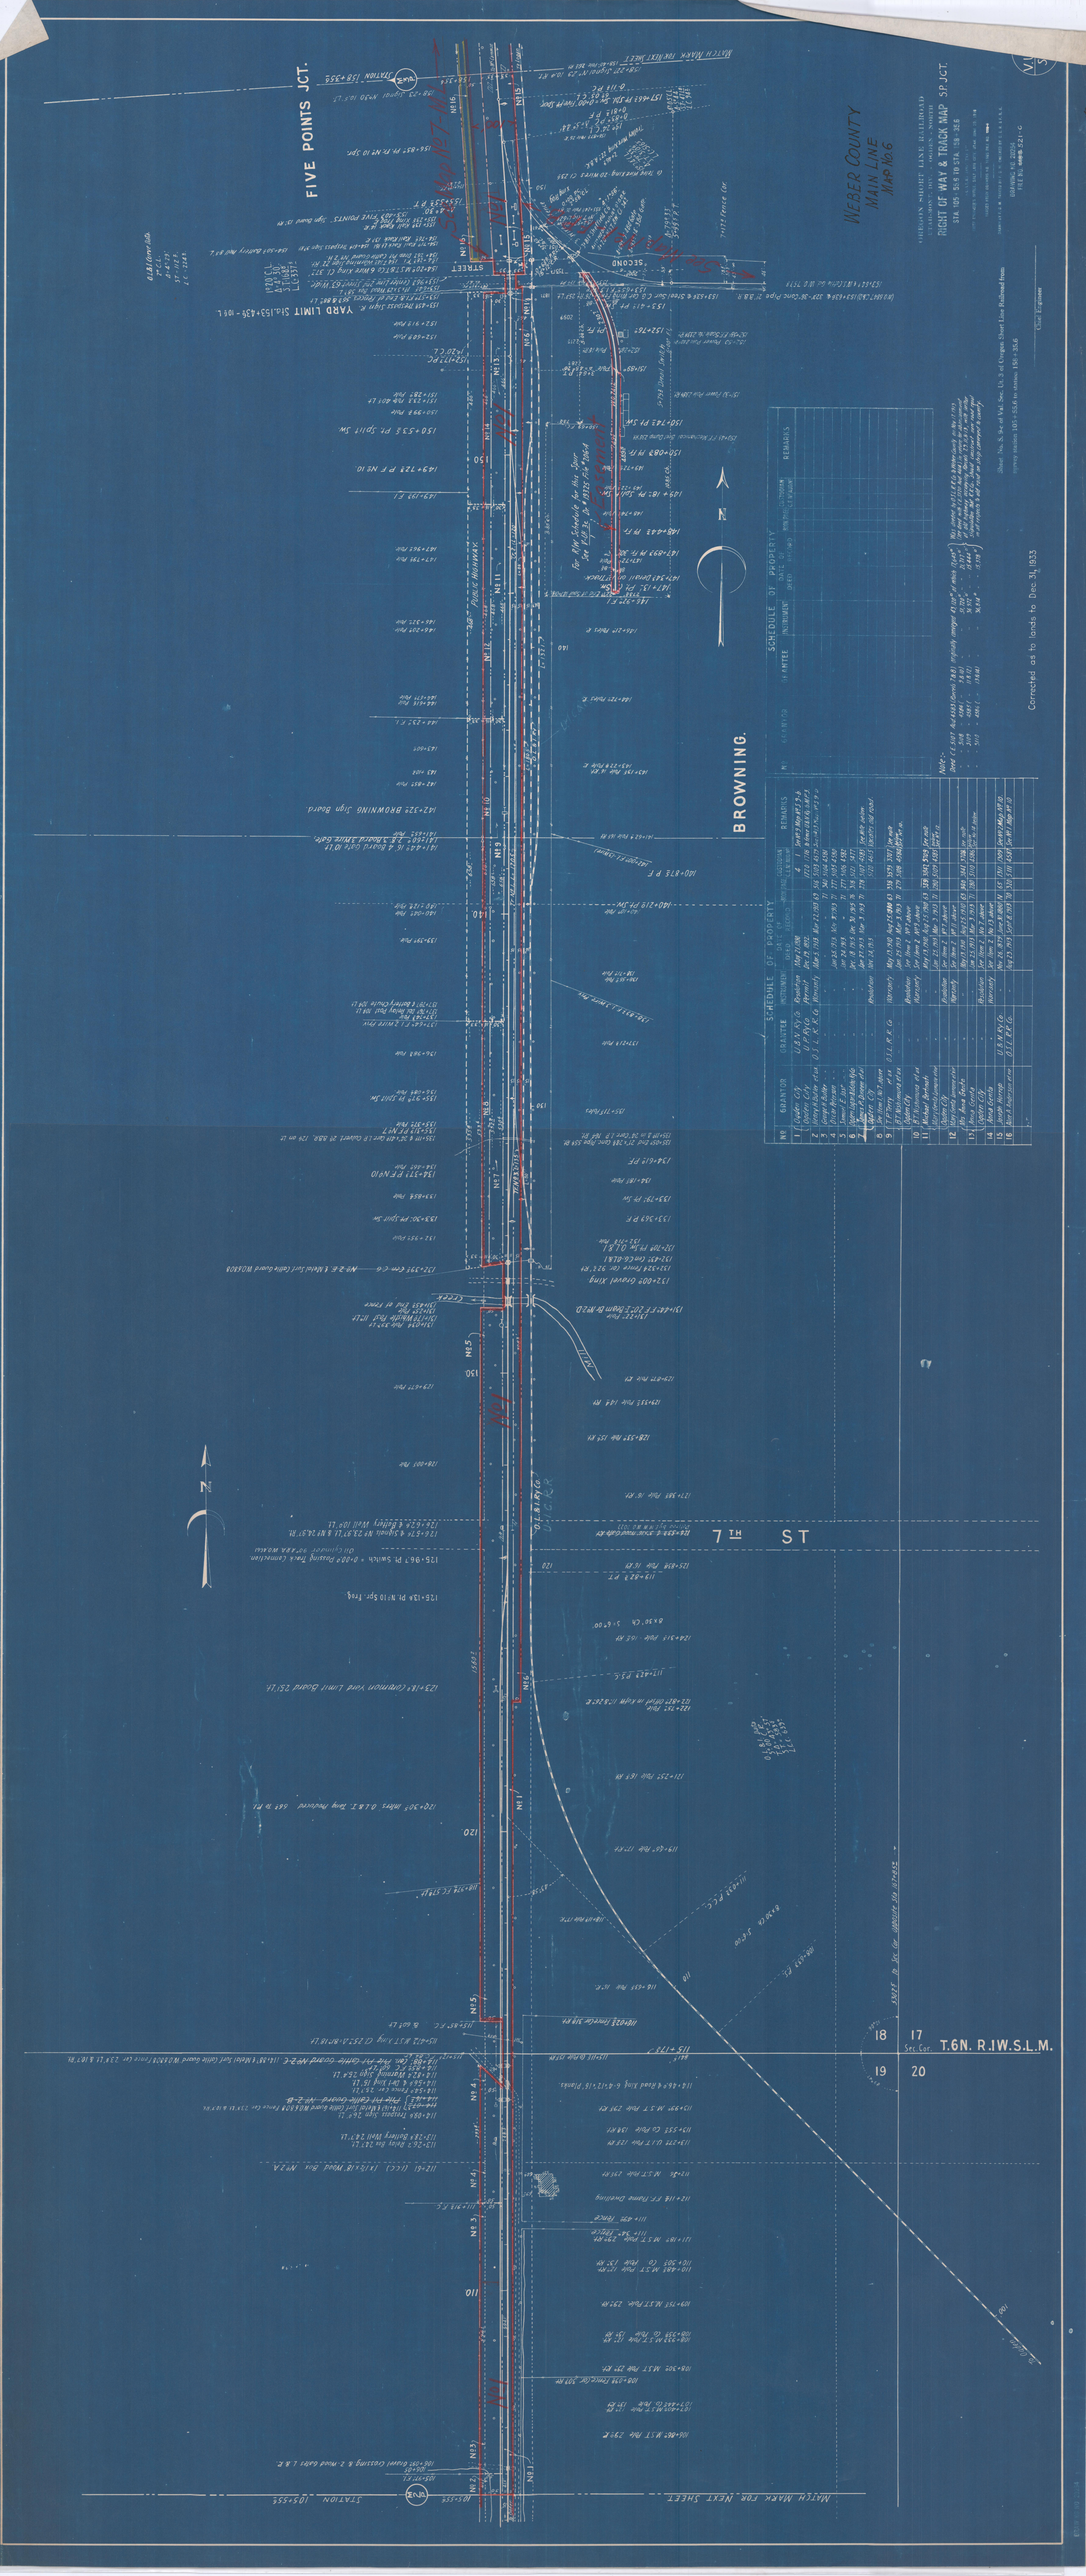
FIVE POINTS JCT.
STATION 158+956
MATCH MARK FOR NEXT SHEET
STATION 105+555
7TH ST
BROWNING.
WEBER COUNTY MAIN LINE MAP NO. 6
RIGHT OF WAY & TRACK MAP S.P.JCT.
STA 105 55 TO STA 158 + 956
SCHEDULE OF PROPERTY
T.6N. R.1W.S.L.M.
Sec. Cor.
18
17
19
20
Corrected as to lands to Dec. 31, 1933
Chief Engineer