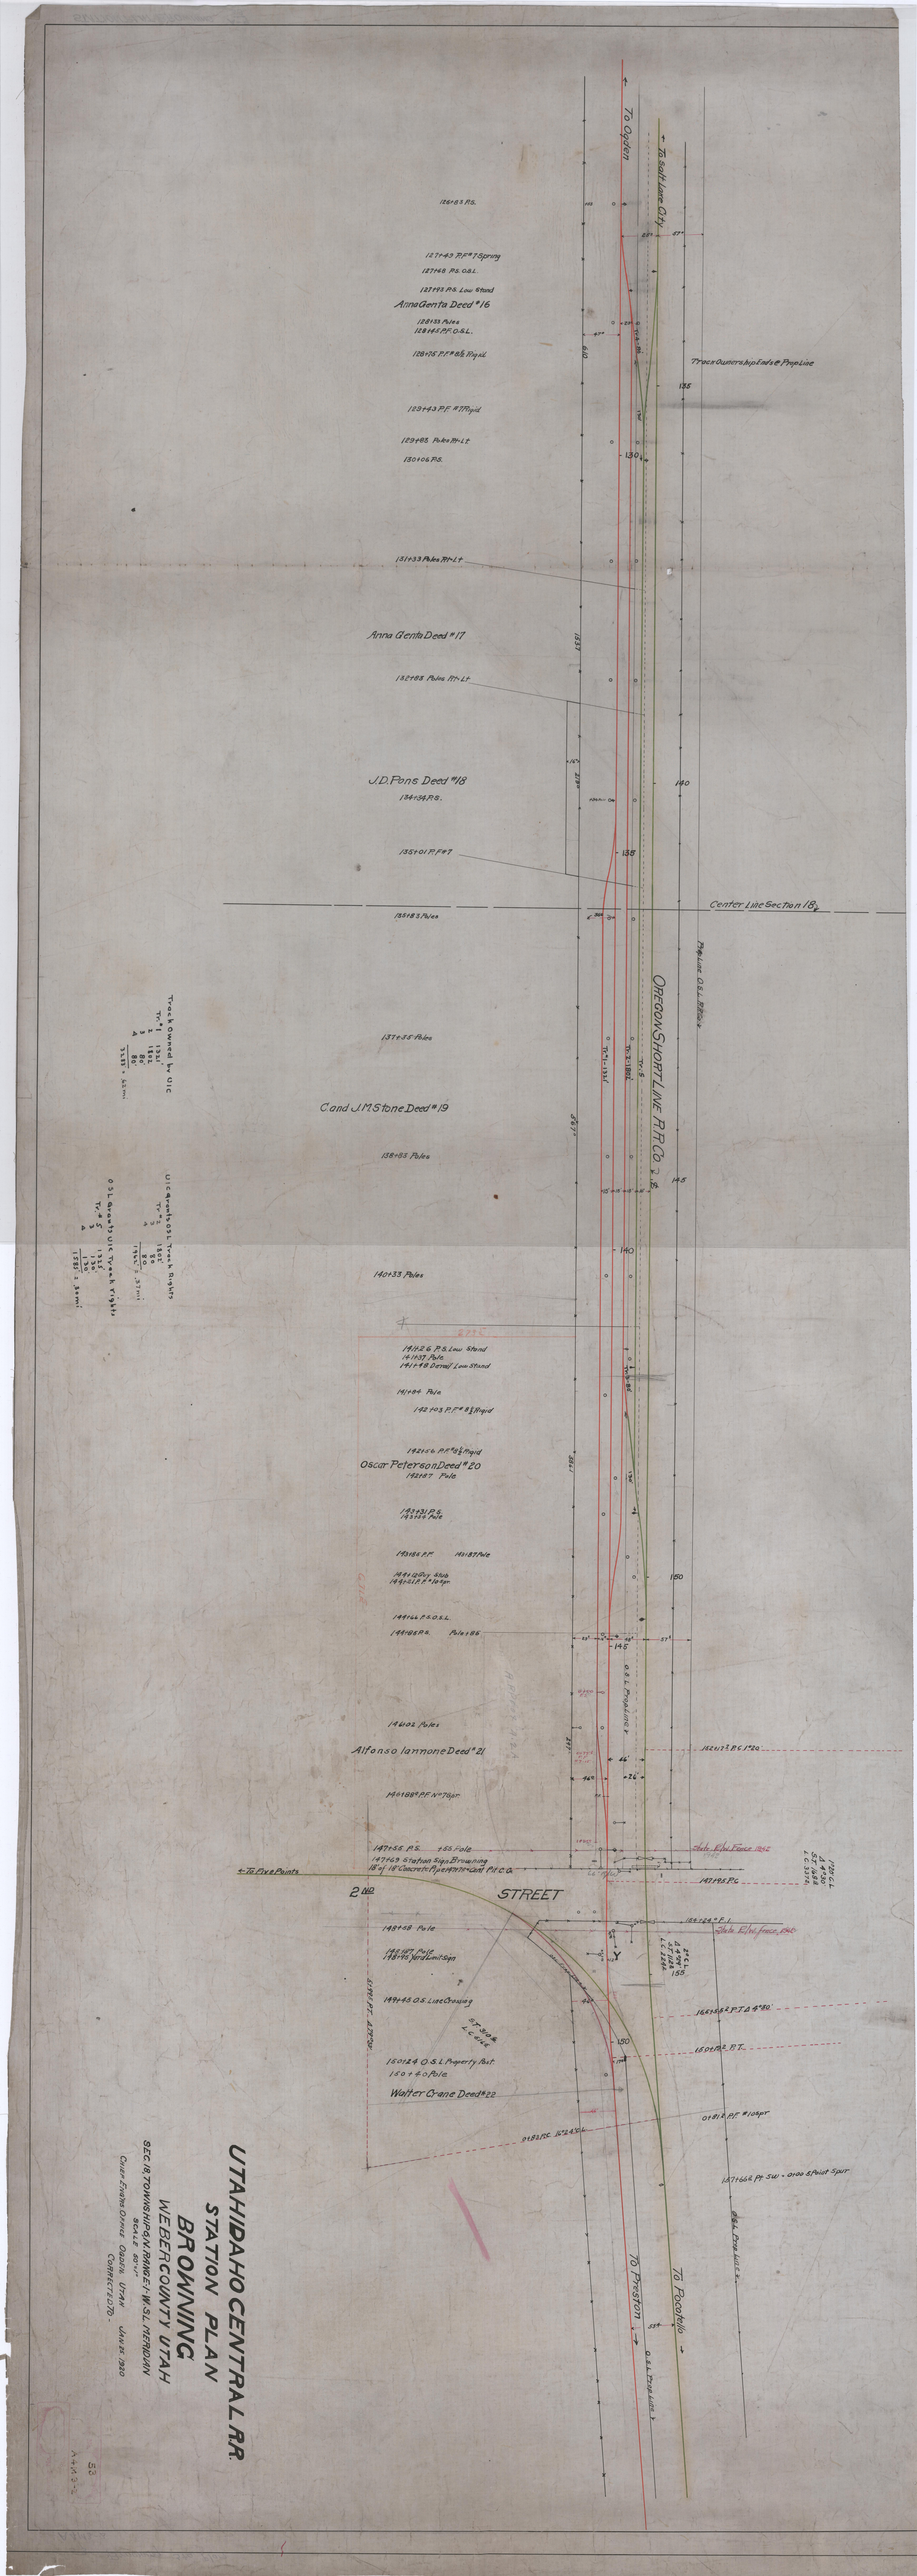
UTAH IDAHO CENTRAL R.R.
STATION PLAN
BROWNING
WEBER COUNTY UTAH
SEC. 18 TOWNSHIP 6 N. RANGE 1 W. SL. MERIDIAN
SCALE 80'=1"
Counter 1070
To Ogden
To Salt Lake City
Anna Genta Deed #16
Anna Genta Deed #17
J.D. Pons Deed #18
Cond J.M. Stone Deed #19
Oscar Peterson Deed #20
Alfonso Iannone Deed #21
Walter Crane Deed #22
Center Line Section 18
OREGON SHORT LINE R.R. CO.
O.S.L. Property Line
U.I.C. Branch Ogden Track Rights
O.S.L. Branch Ogden Track Rights
Track Owned by U.I.C.
STREET
To Five Points
To Preston
To Pocatello
Station Sign Bearing 18 of 18 Concrete Pipe Arm Cast on P.I. C.A.
