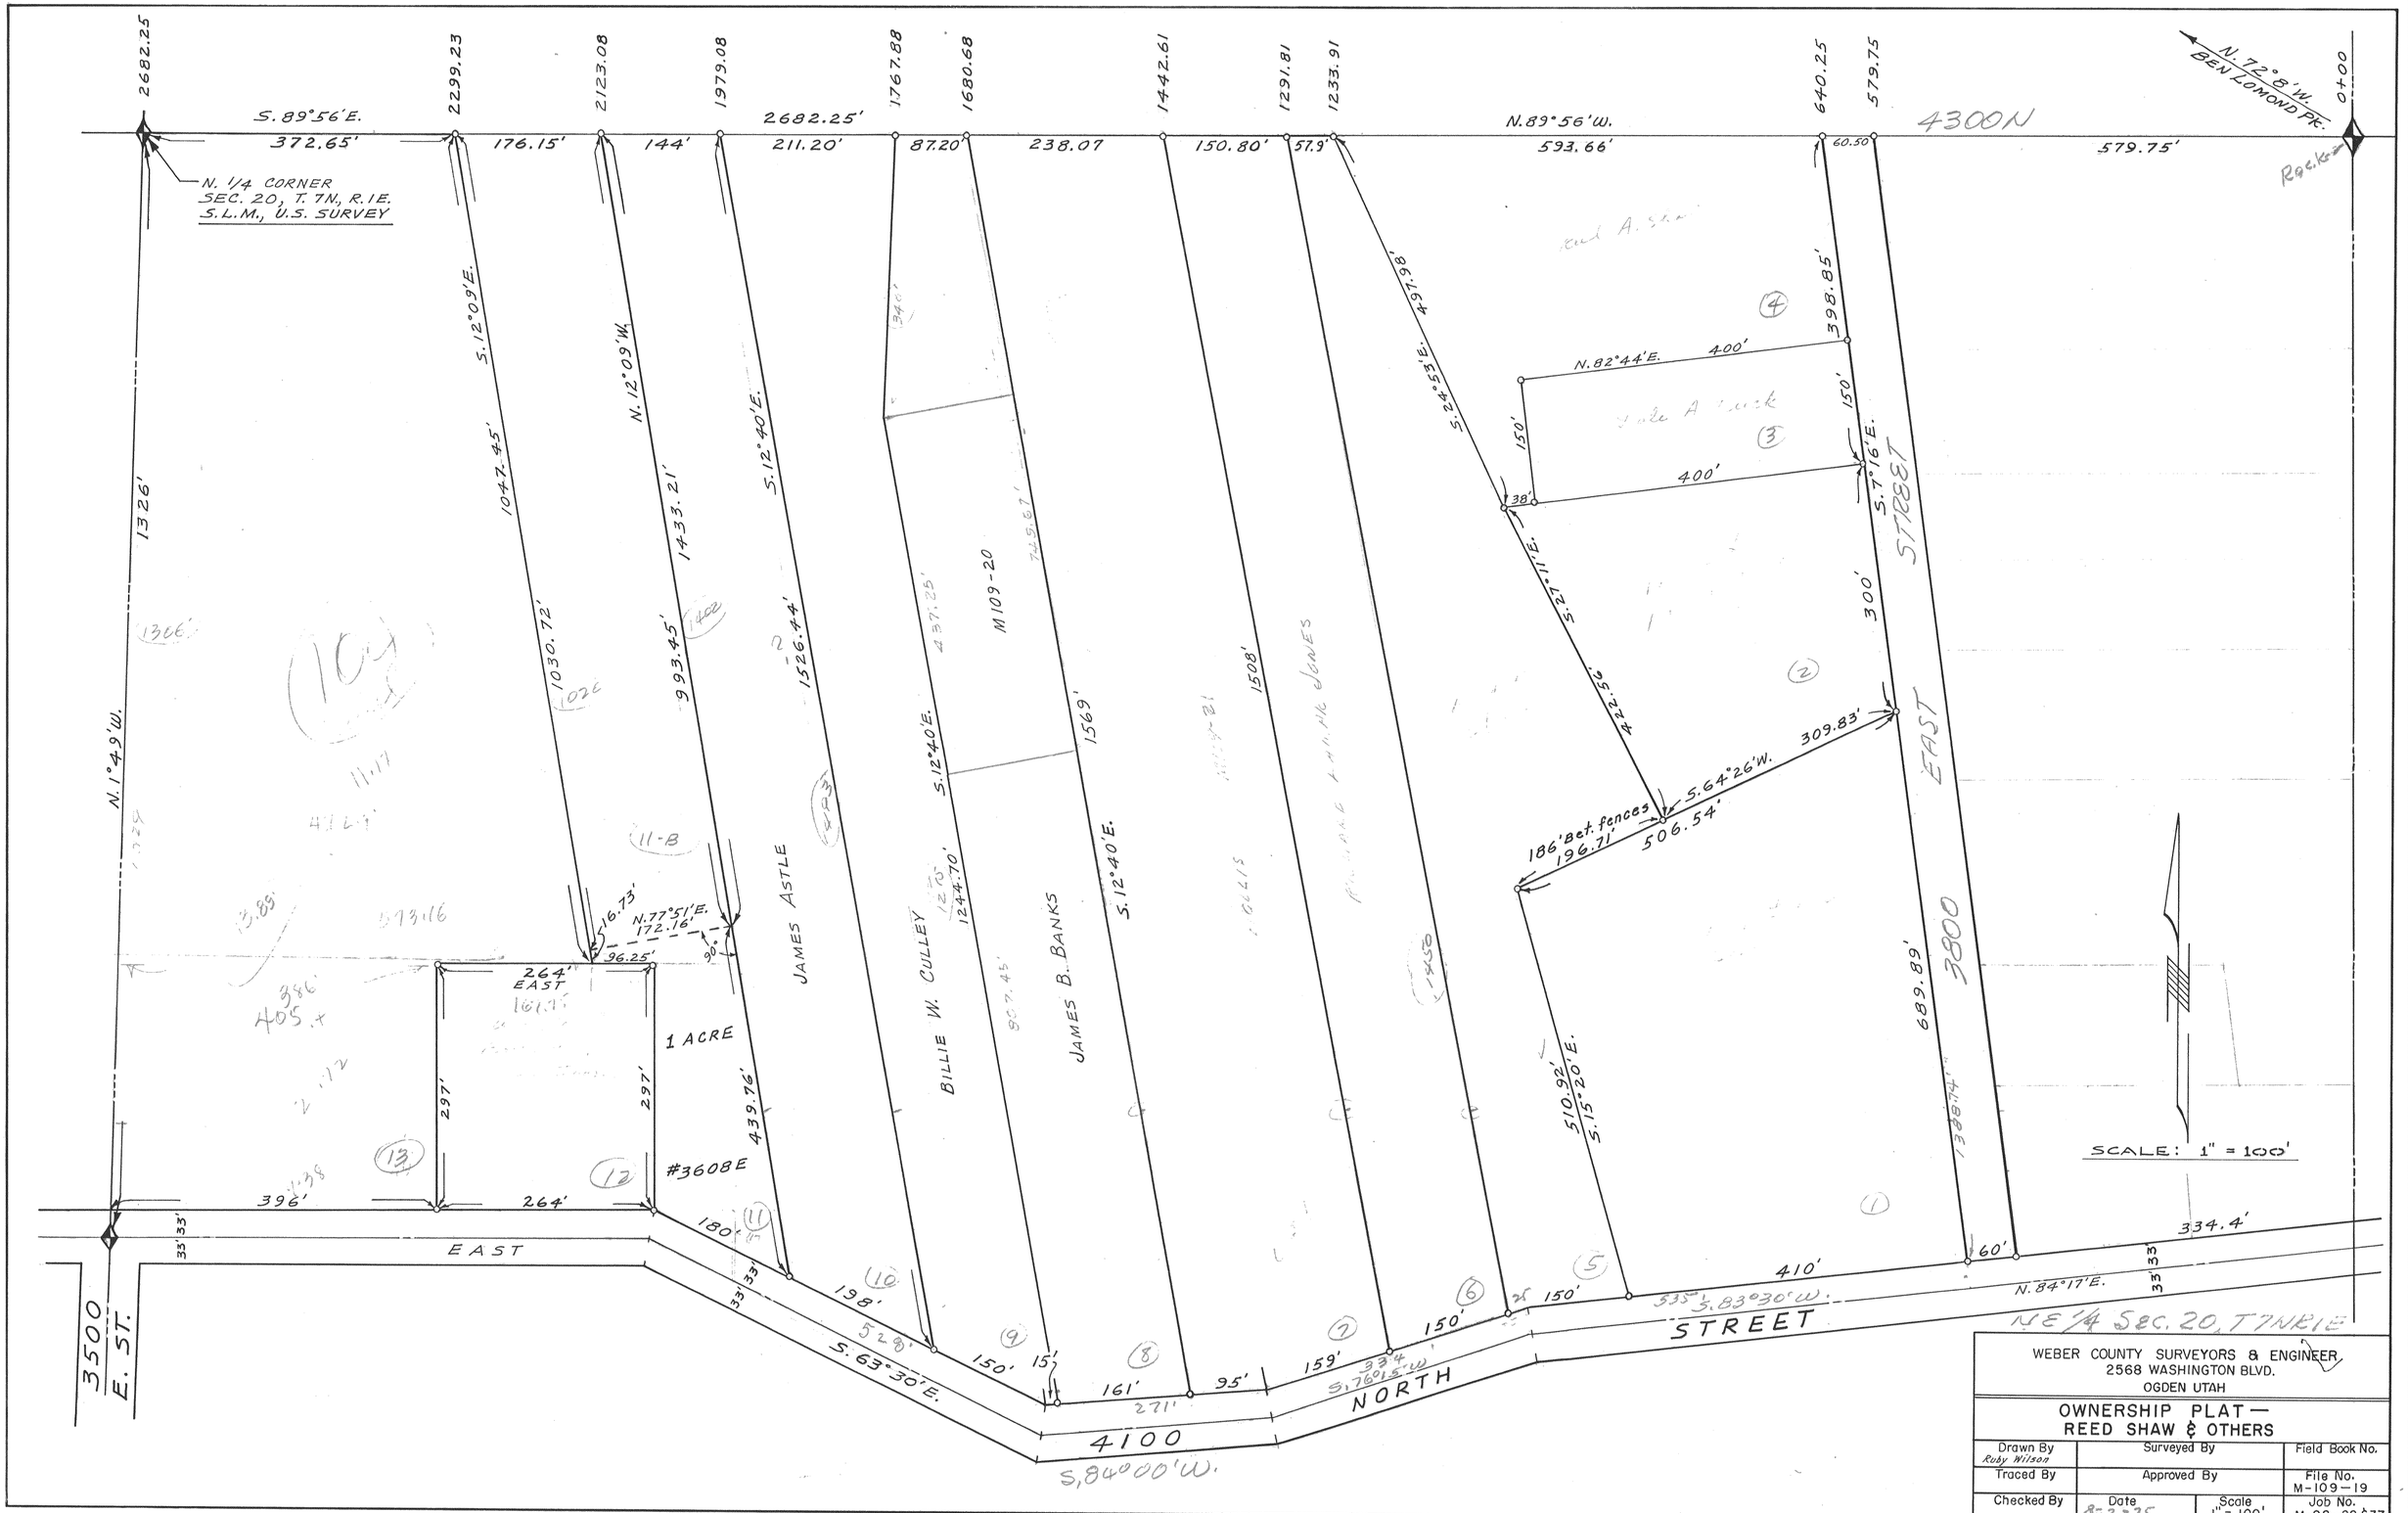

WEBER COUNTY SURVEYORS & ENGINEER
2568 WASHINGTON BLVD.
OGDEN UTAH

OWNERSHIP PLAT —
REED SHAW & OTHERS

Drawn By Ruby Wilson	Surveyed By		Field Book No.
Traced By	Approved By		File No. M-109-19
Checked By	Date 8-2-75	Scale 1" = 100'	Job No. M-98-28 & 37

REED SHAW 8 AC. PARCEL A17-692