


PROJECT	STATE	SECTION	SHEET	TOTAL SHEETS
S-242(1)	UTAH	S-242(1)	1	33
		S.P. 1633	POST	1

STATE OF UTAH


STATE ROAD COMMISSION

PLANS OF PROPOSED STATE ROAD

FEDERAL AID PROJECT
S-242(1) ~ LENGTH 4.098 MILES
WEBER COUNTY
S.P. 1633 ~ LENGTH 0.284 MILES

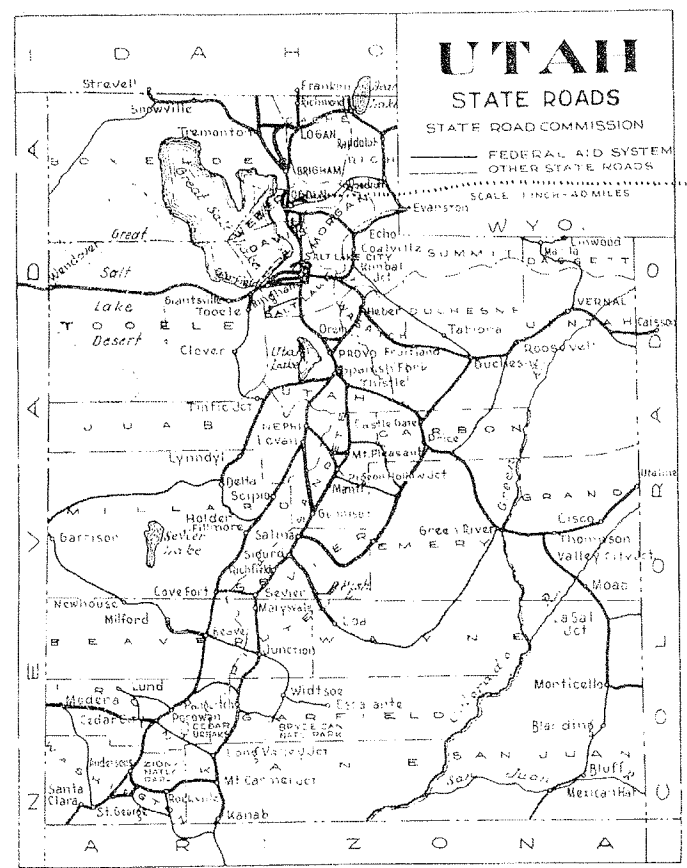

S.P. 1633

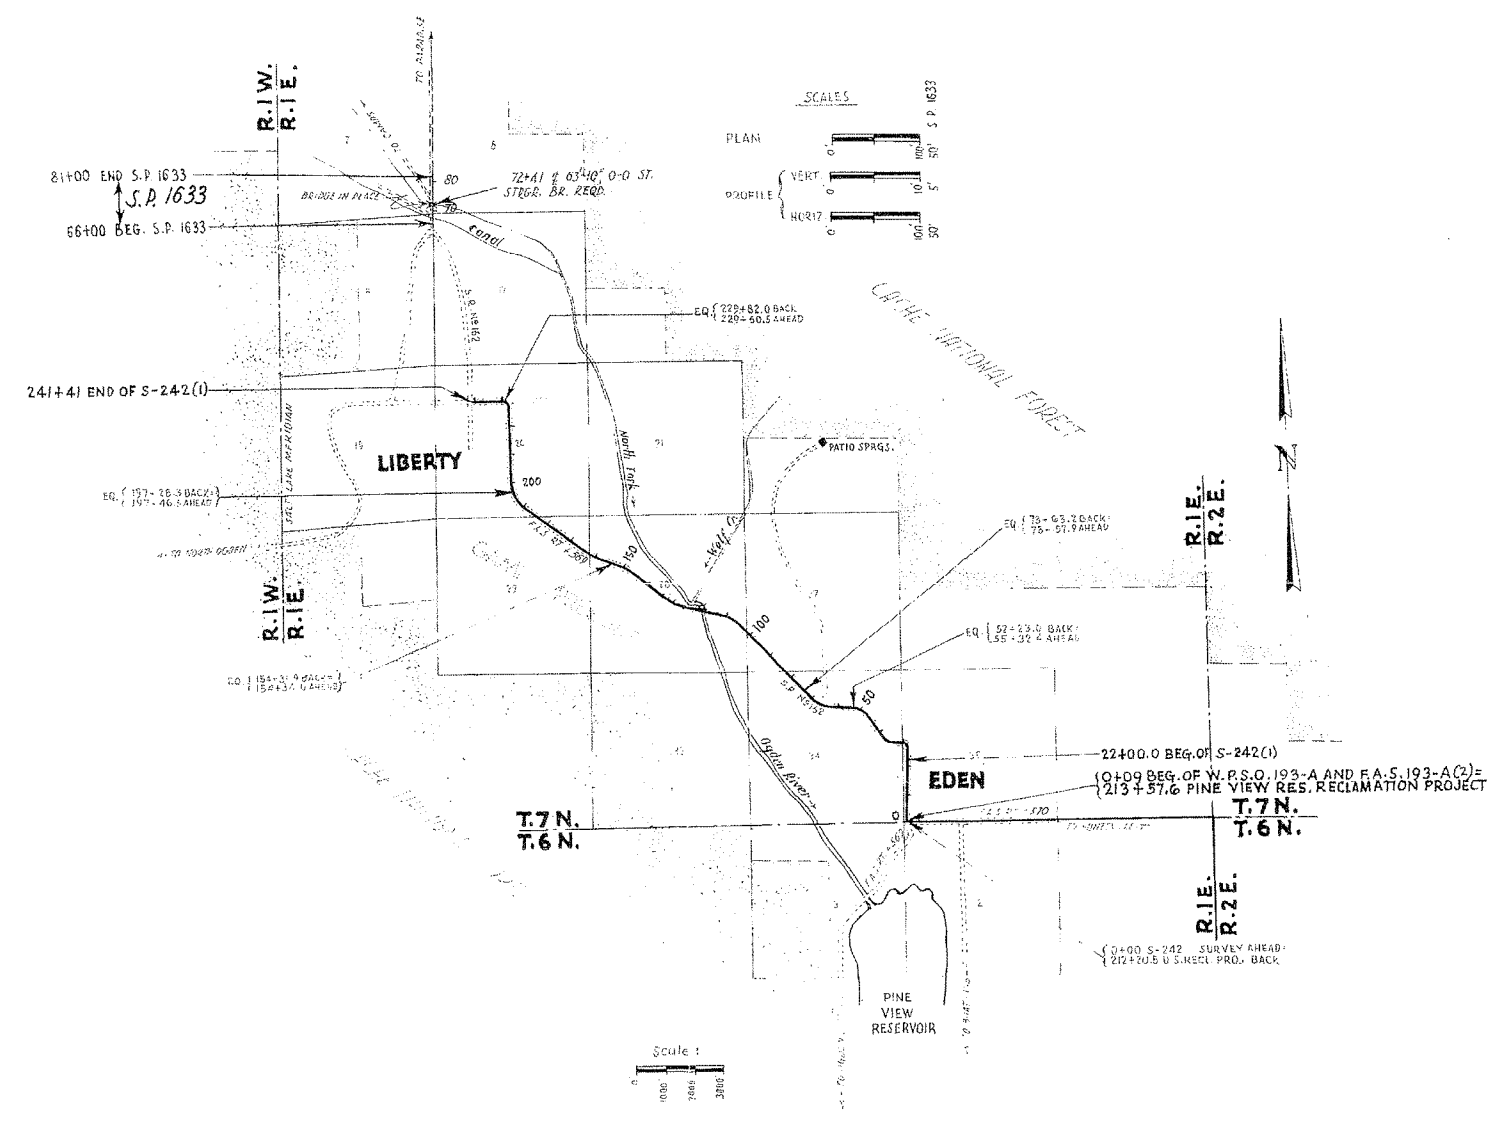

INDEX TO SHEETS S-242(1)

SHEET NO.	DESCRIPTION	DRAWING NO.	STATION
1	TITLE SHEET		
2	TYPICAL SECTION		
3-10	PLAN AND PROFILE		
11-12	12'x3'x50'-3/4" BOX CULVERT	E-792	85+32
13-14	12'x3'x35'-4 1/2"	E-797	80-15
15-16	5'-6" x 3'-10" CULVERT EXTENSION	E-795	104+52.4
17-18	6'x4'x28'-10" BOX CULVERT	E-800	106+12.5
19-21	12'x4'x34'-7 1/8" BOX CULVERT	E-798	119-00
22-27	RIGID FRAME BRIDGE 46'-5 1/4" O+C	D-505	120+43
28-29	4'x2' CULVERT EXTENSION	E-807	141+54
30	3'x1'-3/4" BOX CULVERT	S.C. 234	231-50
31-32	STD. HIGHWAY SIGNS	S-95	142
33-A	F.A.R. & R/W MARKERS	M-45	
33-B	SUPERELEVATE AND WIDEN CURVES	M-180	
33-C	STRUTTING FOR LARGE C.G.M.P.	M-18	
33-D	STD. R/W FENCE	M-46	
1-28	X-SECTIONS		

INDEX TO SHEETS S.P. 1633

SHEET NO.	DESCRIPTION	DWG. NO.	STATION
1	TITLE SHEET		
2	TYPICAL SECTION		
3	PLAN & PROFILE		
4-10	6'-10" O-D 5' STRGR. BRIDGE	C-318	72+41
11	STD. HANDRAIL DETAILS	SR 3-2	72+41
12	HEADWALL	V-609	68+64
13	"	V-632	78+57
14-16	STD. HIGHWAY SIGNS	B-95, 127, 3	
17	GUARD RAIL & GUIDE POSTS	B-137	
18-A	F.A. & R/W MARKERS	M-45	
18-B	R/W FENCE	M-46	

STATE ROAD COMMISSION OF UTAH
 RECOMMENDED FOR APPROVAL: NOV. 1958
R. J. Belland
 ASSISTANT DIRECTOR OF HIGHWAYS FOR ENGINEERING
 APPROVED: NOV. 1958
John R. Morgan
 DIRECTOR OF HIGHWAYS


DEPARTMENT OF COMMERCE
 BUREAU OF PUBLIC ROADS
 APPROVED: _____
 DIVISION ENGINEER DATE

Project: S-242(1)
 Route: 162
 Beg. Post: 162
 End Post: 162
 Sheets: 33
 Sheet No: 01

 No. 242-00

PARCEL NO.	OWNER	NET AC.
242:2	ARTHUR M. FERRIN, ET AL	0.18±
3	MARIA H. PARKINSON, ET AL	0.21±
4	ALBERT J. CARVER	0.14±
5	HYRUM S. CARVER	0.18±
6	AMBROSE A. SHAW, ET AL	0.02±
7	WM A. MONTGOMERY, ET AL	0.27±

FED. ROAD DIST. NO.	STATE	FED. AID PROJ. NO.	FISCAL YEAR	SHEET NO.	TOTAL SHEETS
UT	UTAH	S.242(0)	1946	4	33

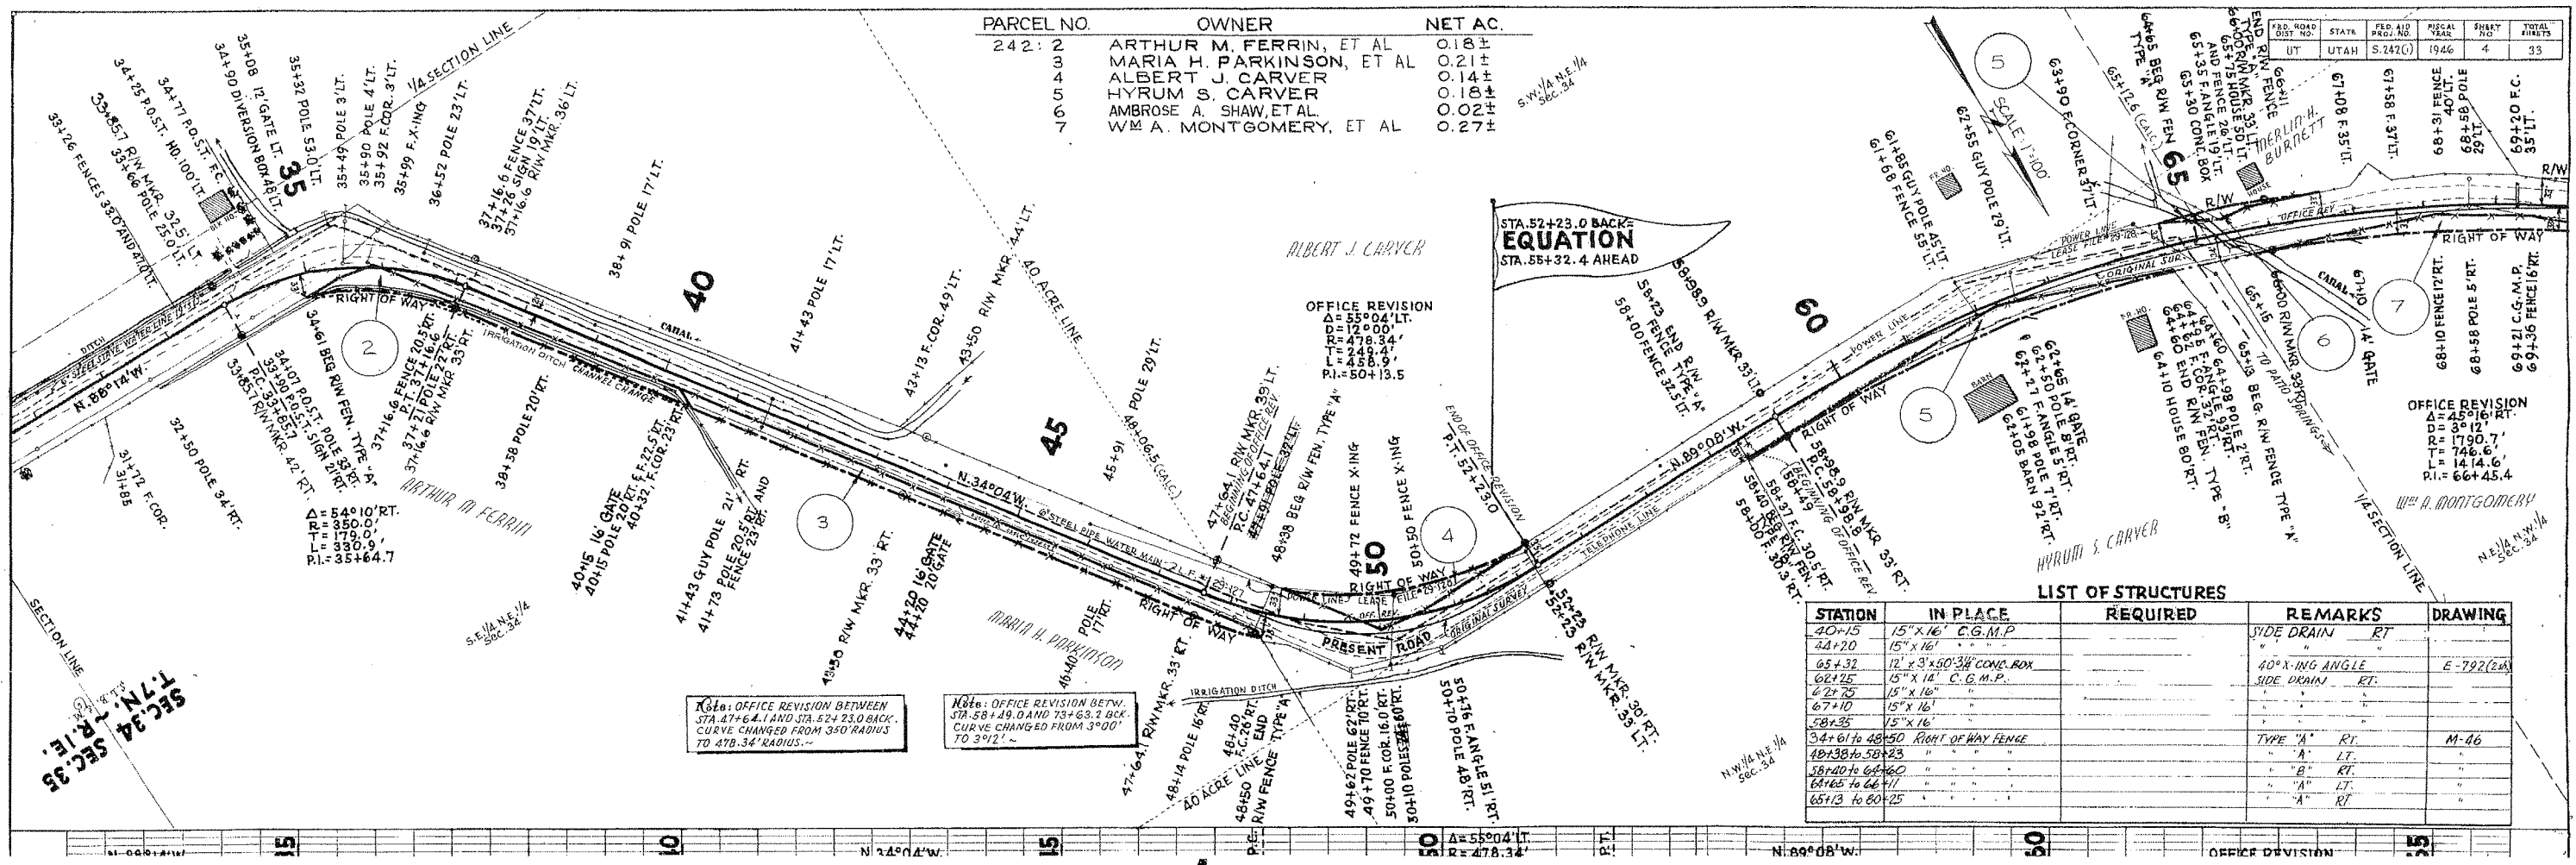

STATION	IN PLACE	REQUIRED	REMARKS	DRAWING
40+15	15" x 16" C.G.M.P.		SIDE DRAIN RT.	
44+20	15" x 16" "		"	
65+32	12" x 3" x 50' 3/4" CONE. BOX		40' X-ING ANGLE	E-792(28)
66+25	15" x 16" C.G.M.P.		SIDE DRAIN RT.	
67+75	15" x 16" "		"	
67+10	15" x 16" "		"	
58+35	15" x 16" "		"	
54+61 to 48+50	Right of Way Fence		TYPE "A" RT.	M-46
48+38 to 58+23	"		"A" LT.	
58+40 to 64+60	"		"B" RT.	
64+65 to 66+11	"		"A" LT.	
65+13 to 60+25	"		"A" RT.	

NOTE: OFFICE REVISION BETWEEN STA. 47+64.1 AND STA. 52+23.0 BACK. CURVE CHANGED FROM 350' RADIUS TO 478.34' RADIUS.


NOTE: OFFICE REVISION BETWEEN STA. 58+49.0 AND 73+63.2 BACK. CURVE CHANGED FROM 3°00' TO 3°12'.

SEC. 34
 T. 7N. R. 1E.
 SEC. 35


FED. ROAD DIST. NO.	STATE	FED. AID PROJ. NO.	FISCAL YEAR	SHEET NO.	TOTAL SHEETS
UT	UTAH	S. 242(0)	1946	4	33



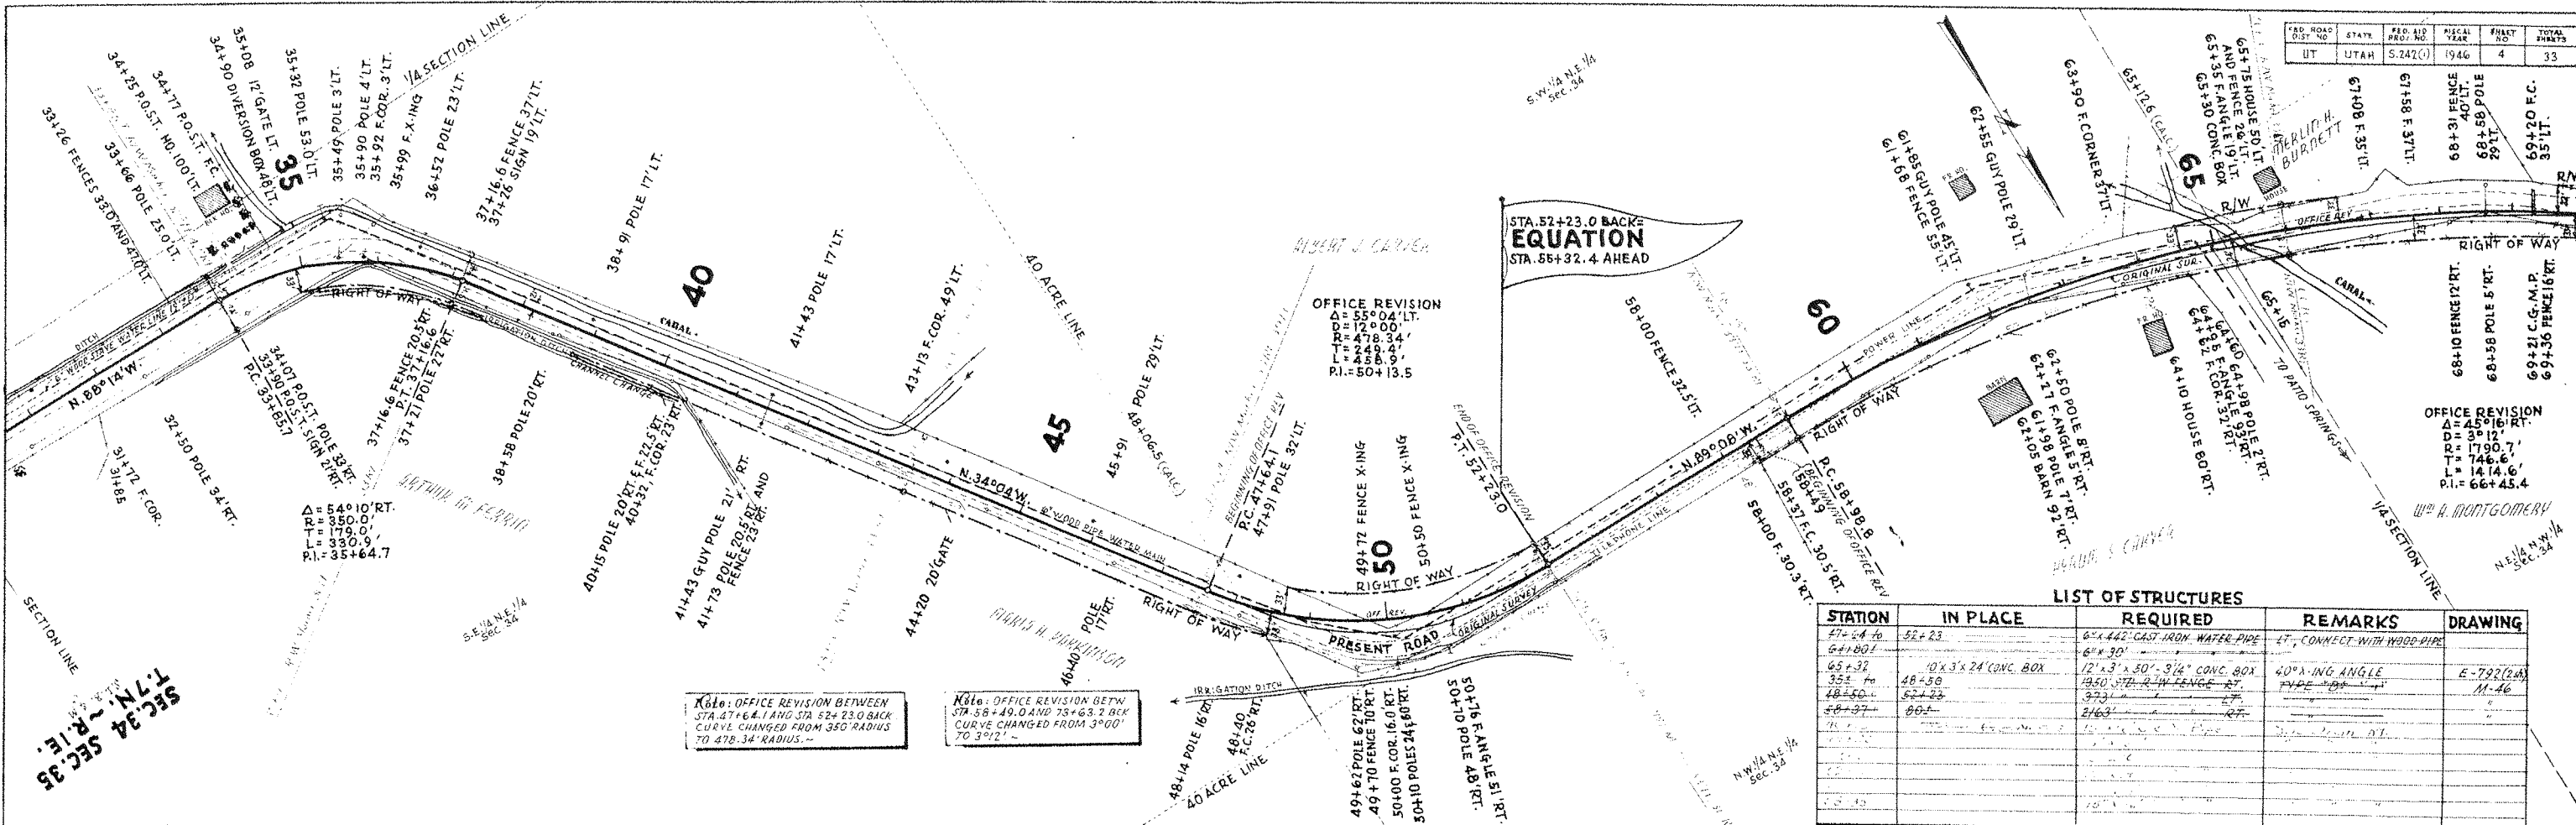

STATION	IN PLACE	REQUIRED	REMARKS	DRAWING
52+23	52+23	6" x 44" CAST IRON WATER PIPE	LT. CONNECT WITH HOOD PIPE	
52+23	52+23	6" x 30"		
52+23	52+23	10' x 3' x 24" CONC. BOX	40° ANGLE	E-792(24)
52+23	52+23	12' x 3' x 50' - 3/4" CONC. BOX	PIPE	M-46

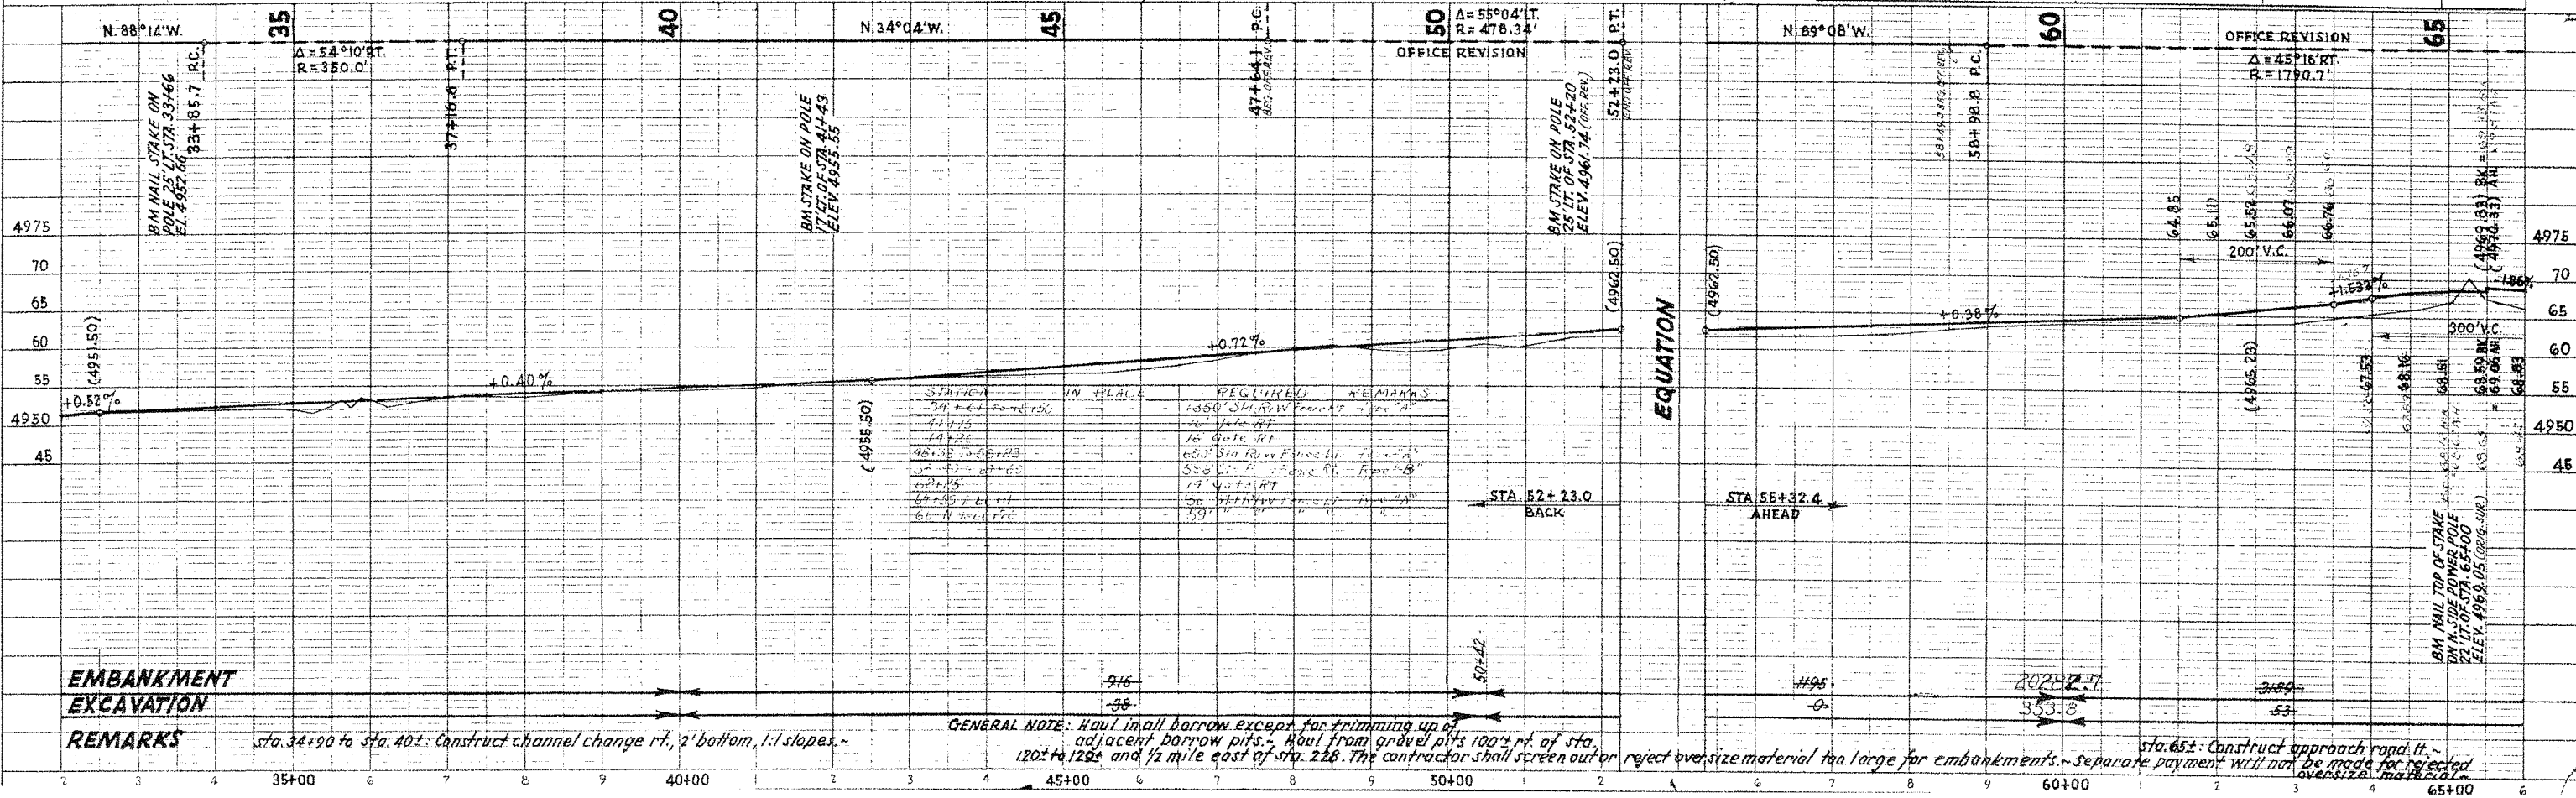


GENERAL NOTE: Haul in all borrow except for trimming up of adjacent borrow pits. Haul from gravel pits 100' rt. of sta. 120' to 125' and 1/2 mile east of sta. 228. The contractor shall screen out or reject oversize material too large for embankments. Separate payment will not be made for rejected oversize material.

sta. 34+90 to sta. 40±: Construct channel change rt., 2' bottom, 1:1 slopes.

sta. 65±: Construct approach road ft. ~


EMBAKMENT
EXCAVATION
REMARKS

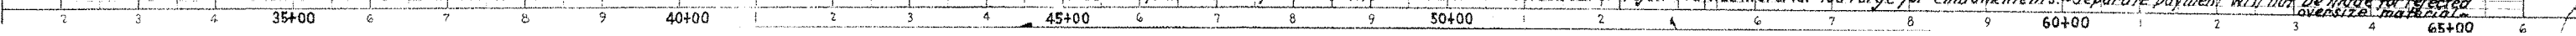

SCALE: 1"=100'


PLAN
 NOTE BOOK
 No. 242

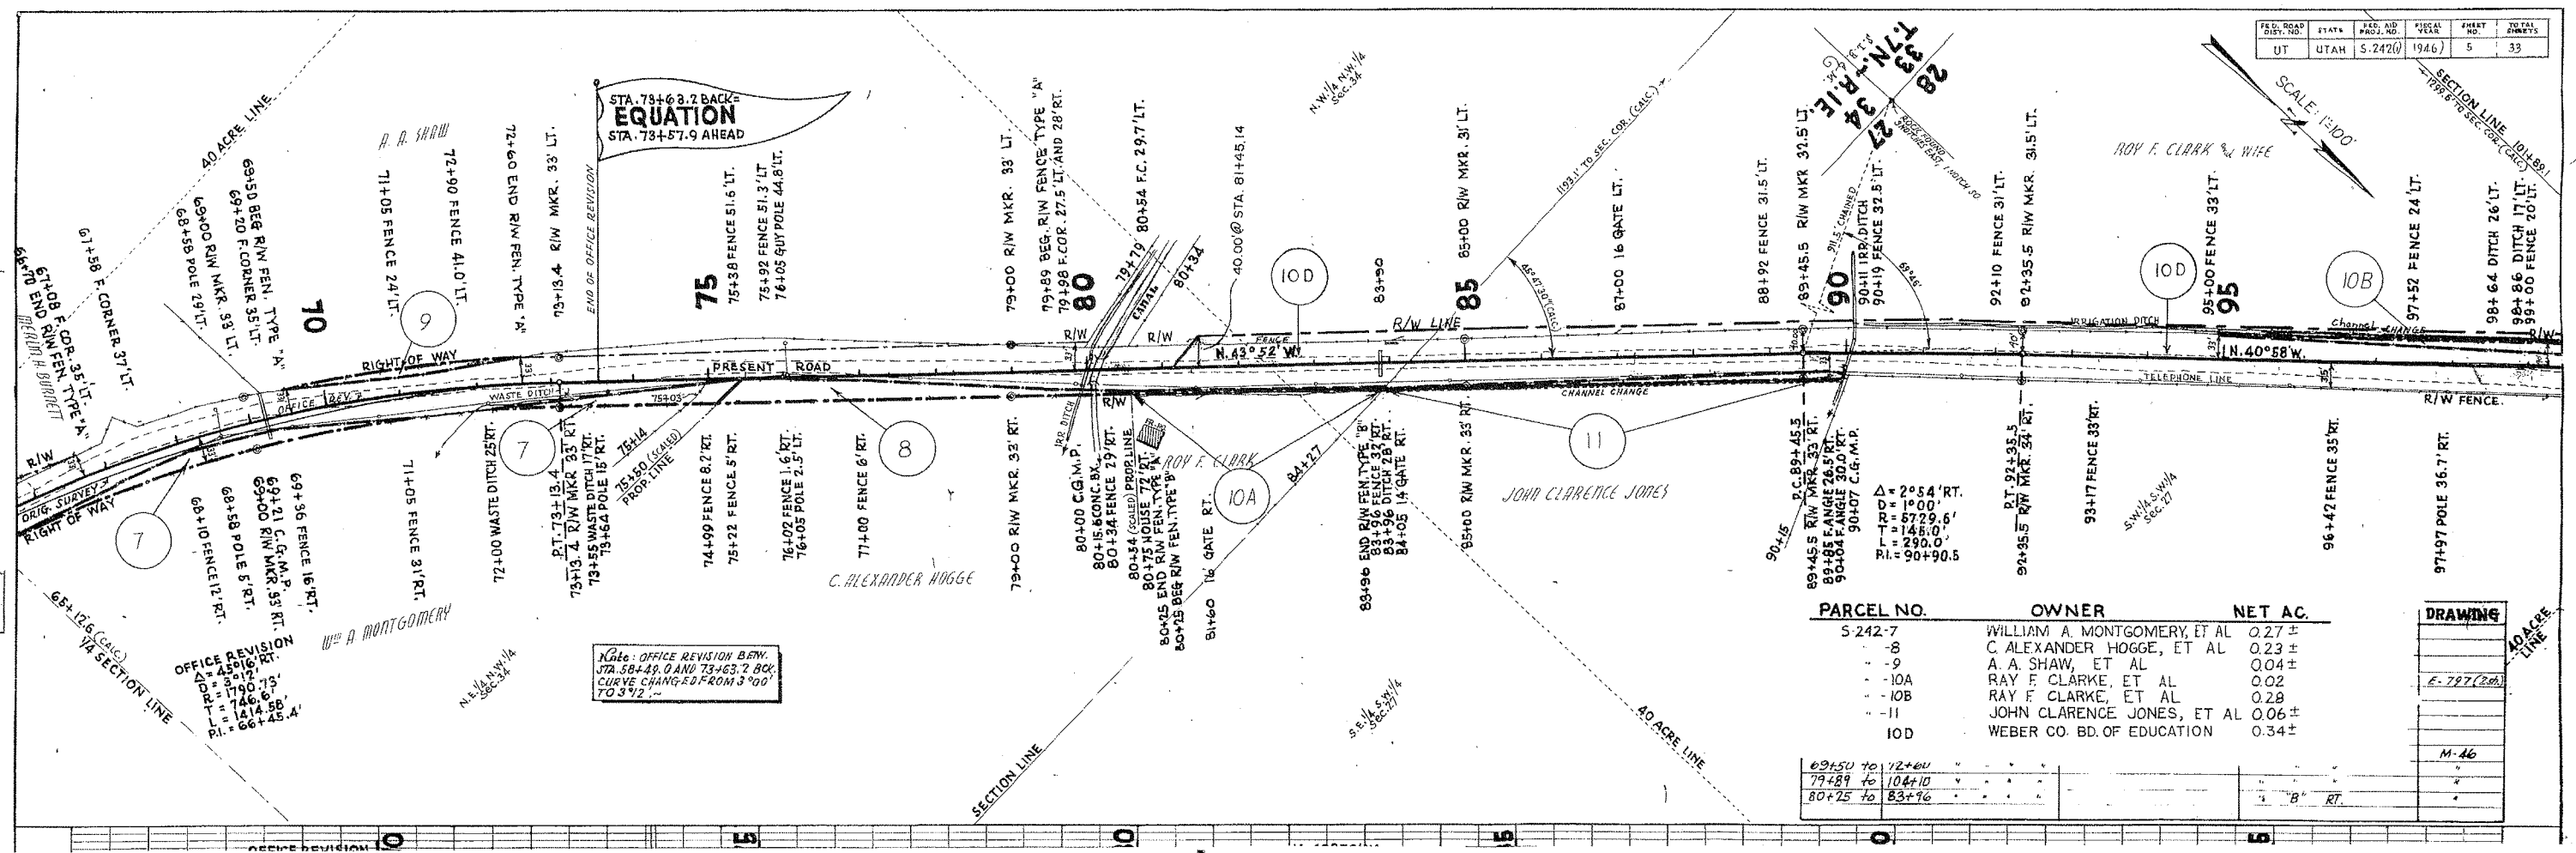

Note: OFFICE REVISION BEW.
 STA. 58+49.0 AND 73+63.2 BCK.
 CURVE CHANGE FROM 3°00'
 TO 3°42'


PARCEL NO.	OWNER	NET AC.
S-242-7	WILLIAM A. MONTGOMERY, ET AL	0.27 ±
-8	C. ALEXANDER HOGGE, ET AL	0.23 ±
-9	A. A. SHAW, ET AL	0.04 ±
-10A	RAY F. CLARKE, ET AL	0.02
-10B	RAY F. CLARKE, ET AL	0.28
-11	JOHN CLARENCE JONES, ET AL	0.06 ±
IOD	WEBER CO. BD. OF EDUCATION	0.34 ±

69+50 to 72+60			
79+89 to 104+10			
80+25 to 83+96			

DRAWING
E-727 (2nd)
M-16


FED. ROAD DIST. NO.	STATE	FED. AID PROJ. NO.	FISCAL YEAR	PROJECT NO.	TOTAL SHEETS
UT	UTAH	S. 2420	1946	5	33

PLAN
 REVISIONS
 NO. 1
 DATE
 BY
 CHECKED
 DATE
 BY

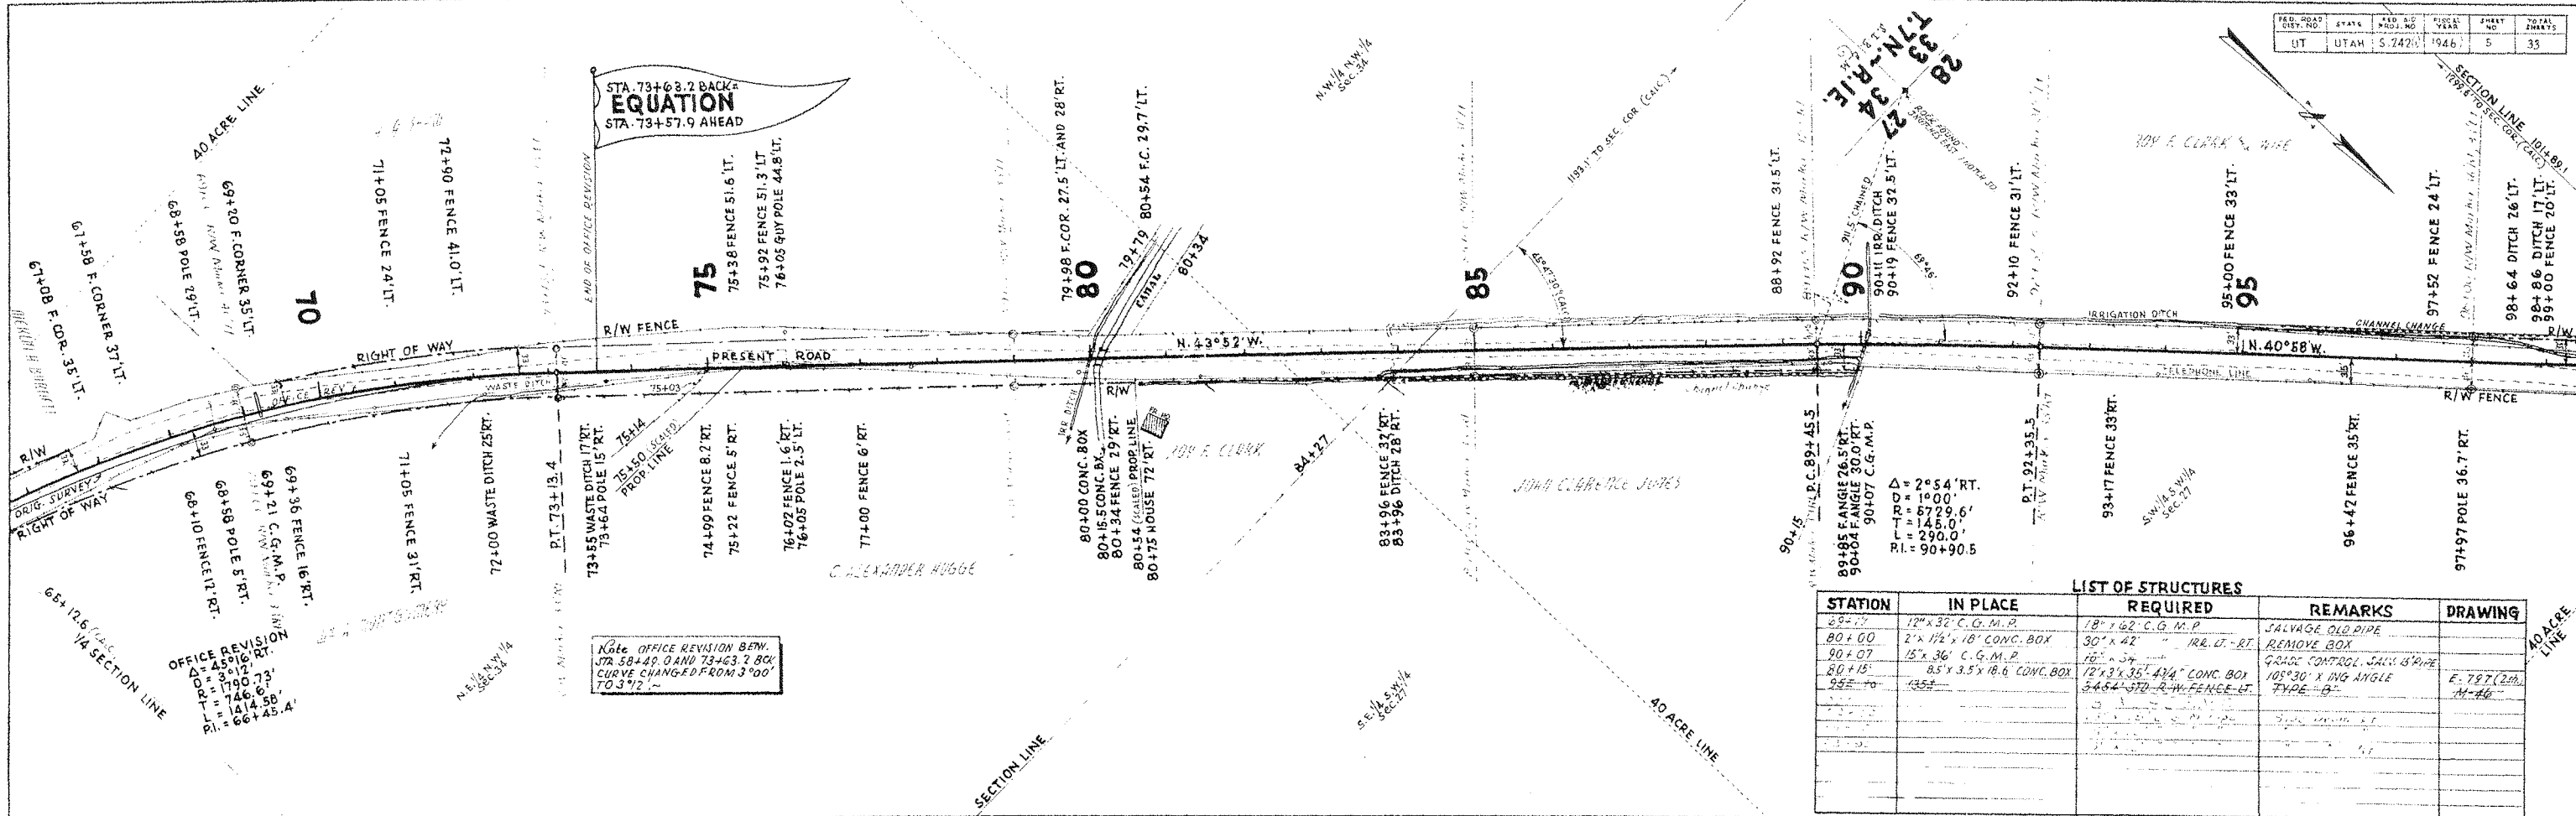

LIST OF STRUCTURES

STATION	IN PLACE	REQUIRED	REMARKS	DRAWING
83+96	12" x 37" C.G.M.P.	18" x 62" C.G.M.P.	SALVAGE OLD PIPE	
80+00	2" x 1/2" x 18" CONC. BOX	30" x 42" " " " "	REMOVE BOX	
90+07	18" x 36" C.G.M.P.	18" x 36" " " " "	GRADE CONTROL S&W PIPE	
80+15	8.5' x 3.5' x 18.6" CONC. BOX	12' x 3' x 35" 424" CONC. BOX	105° 30' x 110° ANGLE TYPE "B"	E. 797 (200) M-46
95+00	135' "	346.6' STD. R.W. FENCE LT.		

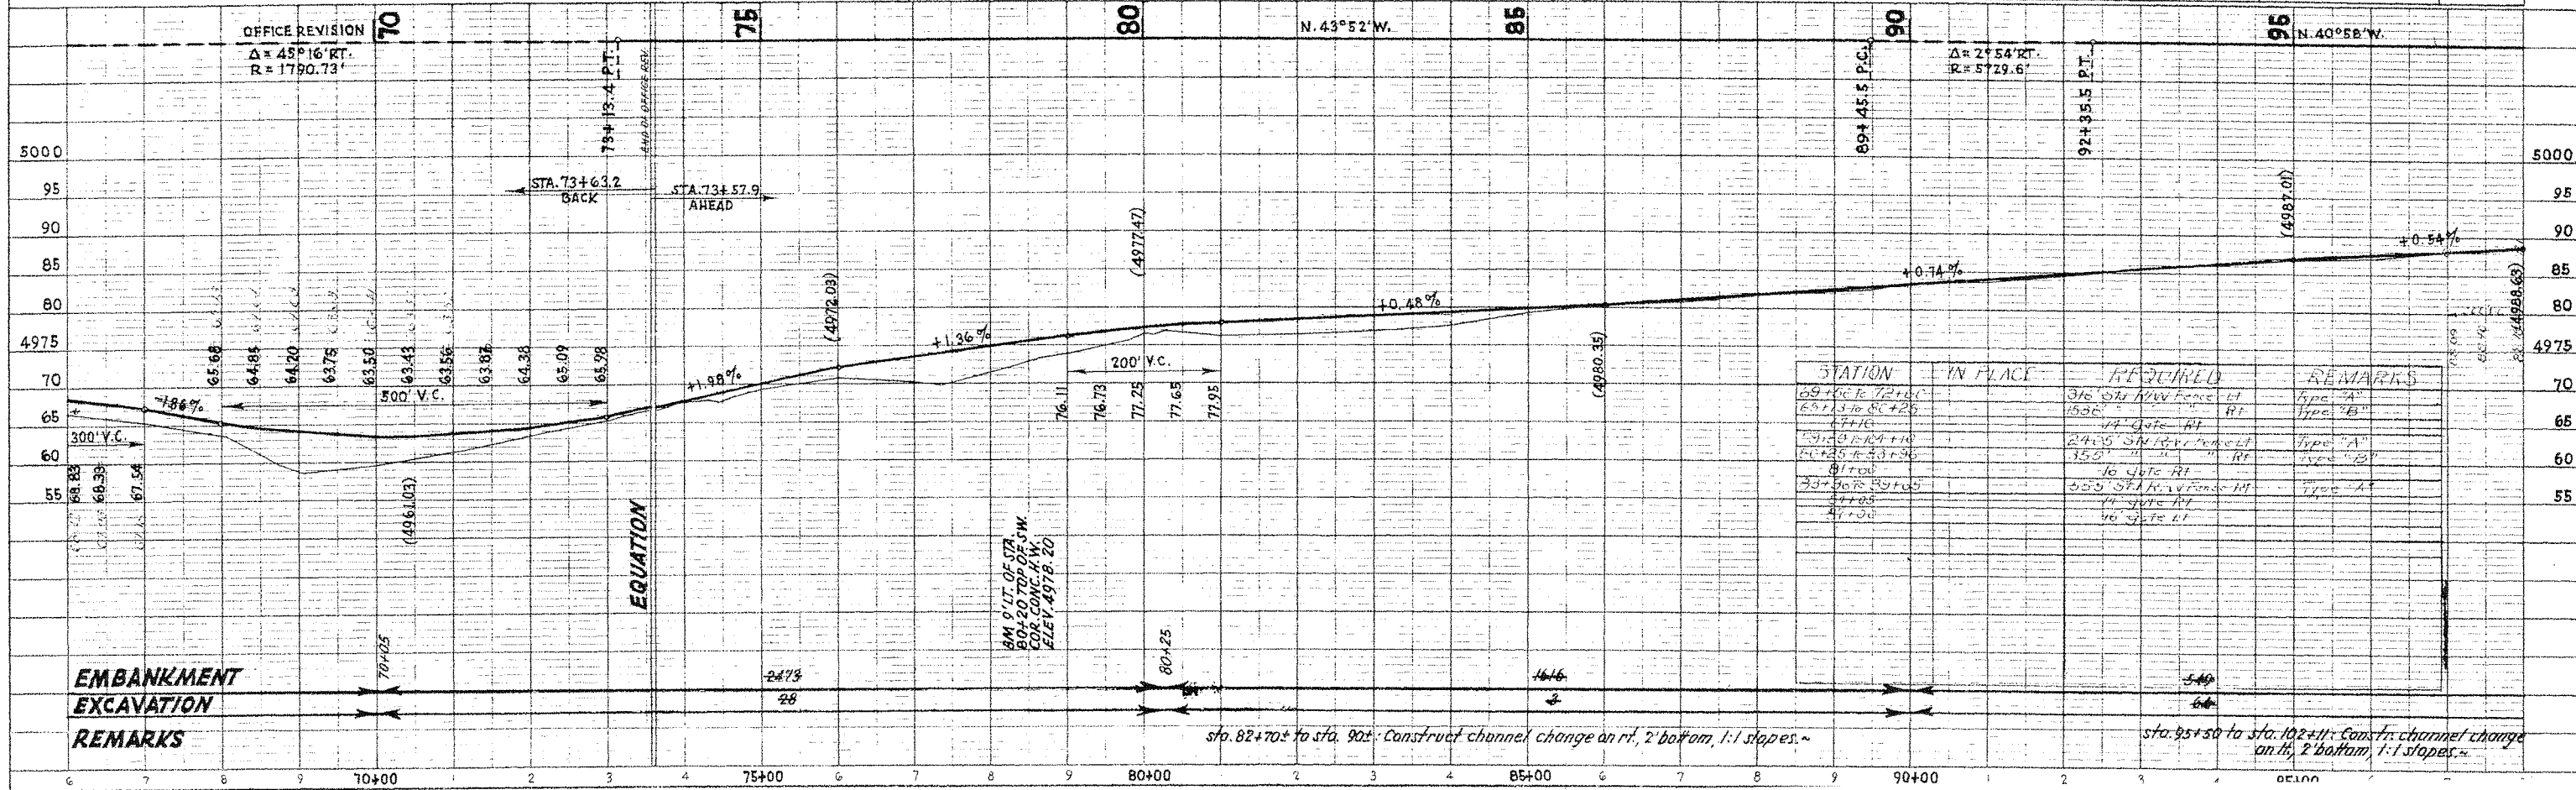


STATION	IN PLACE	REQUIRED	REMARKS

PROF. REVISIONS
 NO. 1
 DATE
 BY
 CHECKED
 DATE
 BY

EMBANKMENT
EXCAVATION
REMARKS

sta. 82+70.4 to sta. 90+ Construct channel change on rd, 2' bottom, 1:1 slopes.
 sta. 95+50 to sta. 102+11: Construct channel change on rd, 2' bottom, 1:1 slopes.



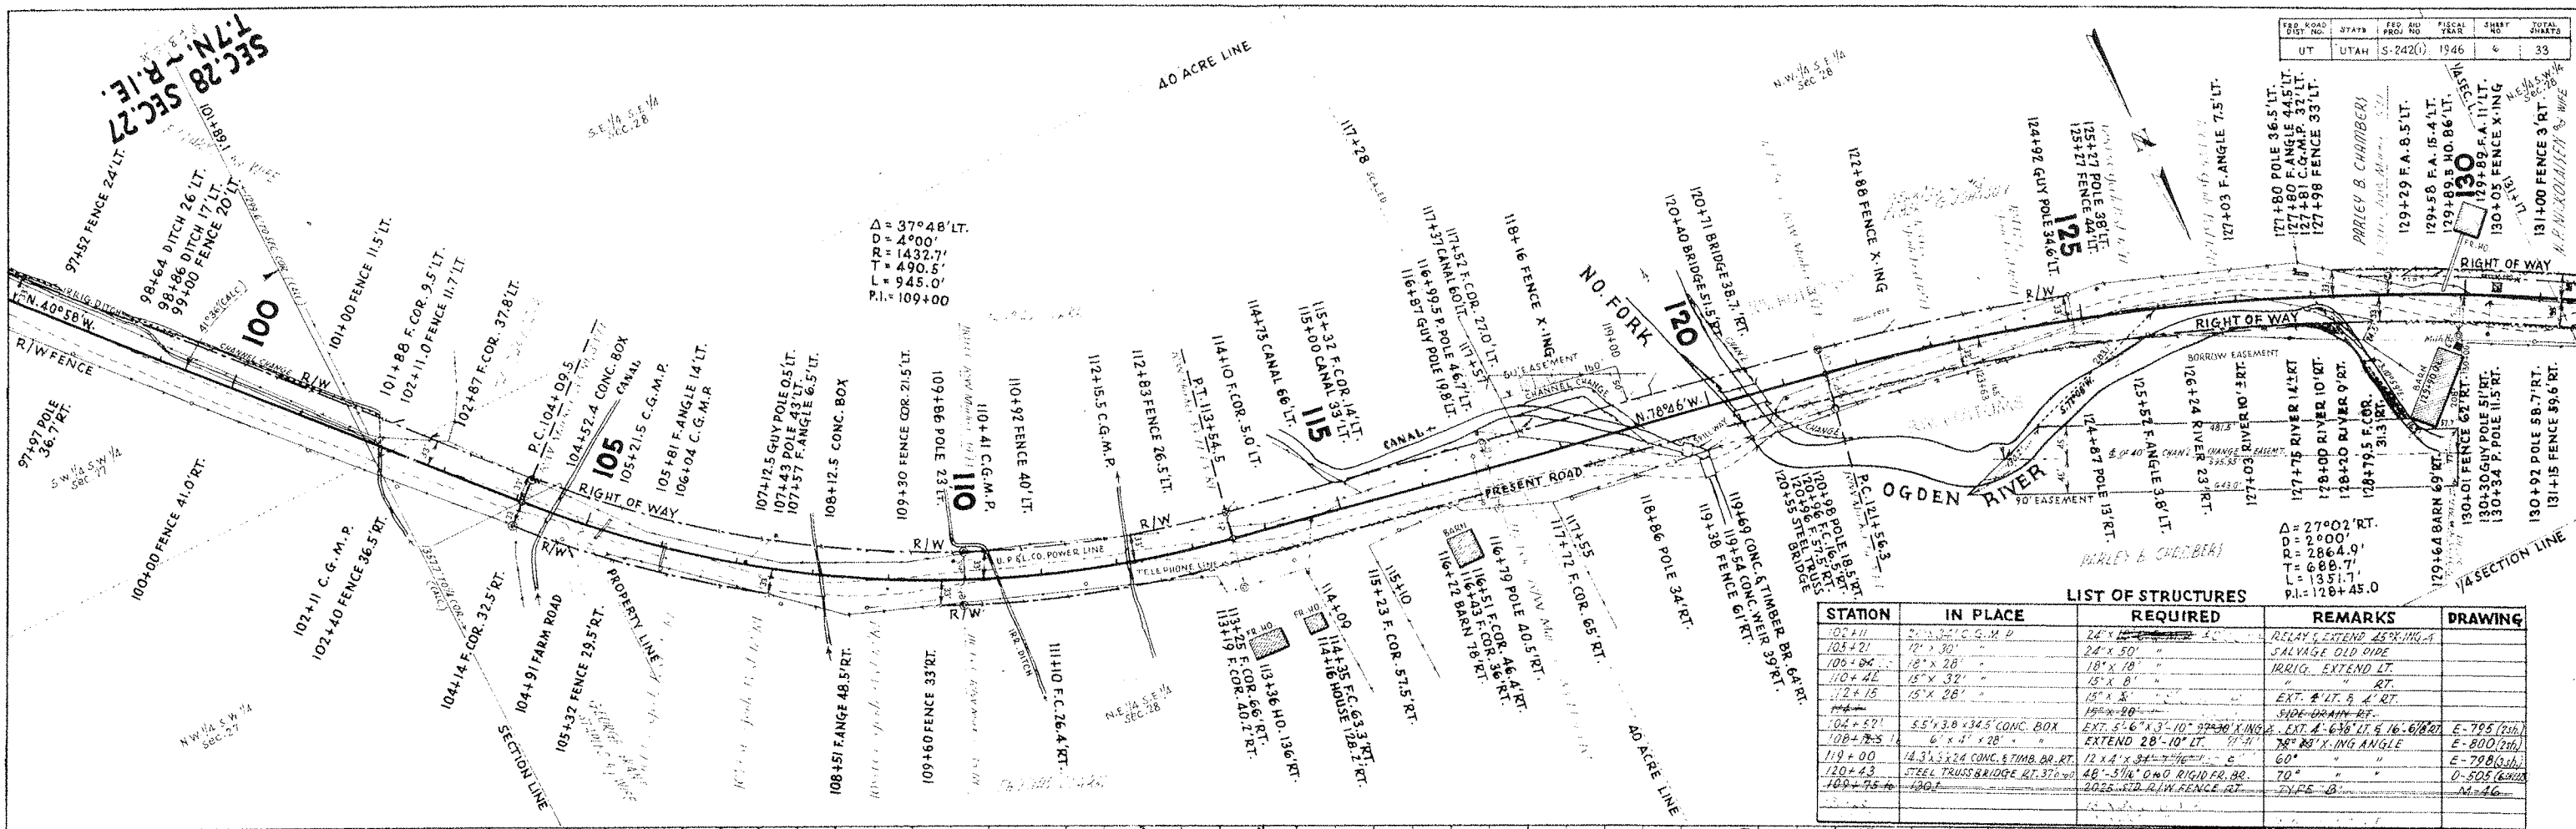

LIST OF STRUCTURES

STATION	IN PLACE	REQUIRED	REMARKS	DRAWING
104+52	5.5' x 3.8' CONC. BOX	EXT. 5'-6" x 3'-10" 99' x 36' KING-A	EXT. A-6' x 16'-6" RT. E-795 (2th)	
108+75	6' x 5' x 28'	EXTEND 28'-10" LT.	78' x 33' KING ANGLE E-800 (2th)	
119+00	14.3' x 5.2' CONC. & TIMB. BR. RT.	12' x 4' x 34'-4" 116' x 6'	60' E-798 (3th)	
120+43	STEEL TRUSS BRIDGE RT. 37' W.	48'-3 1/2' O.M.G. RIGID BR. 80'	70' D-505 (6th)	
109+75	120'	202' RT. R/W FENCE RT.	TYPE-B	M-46


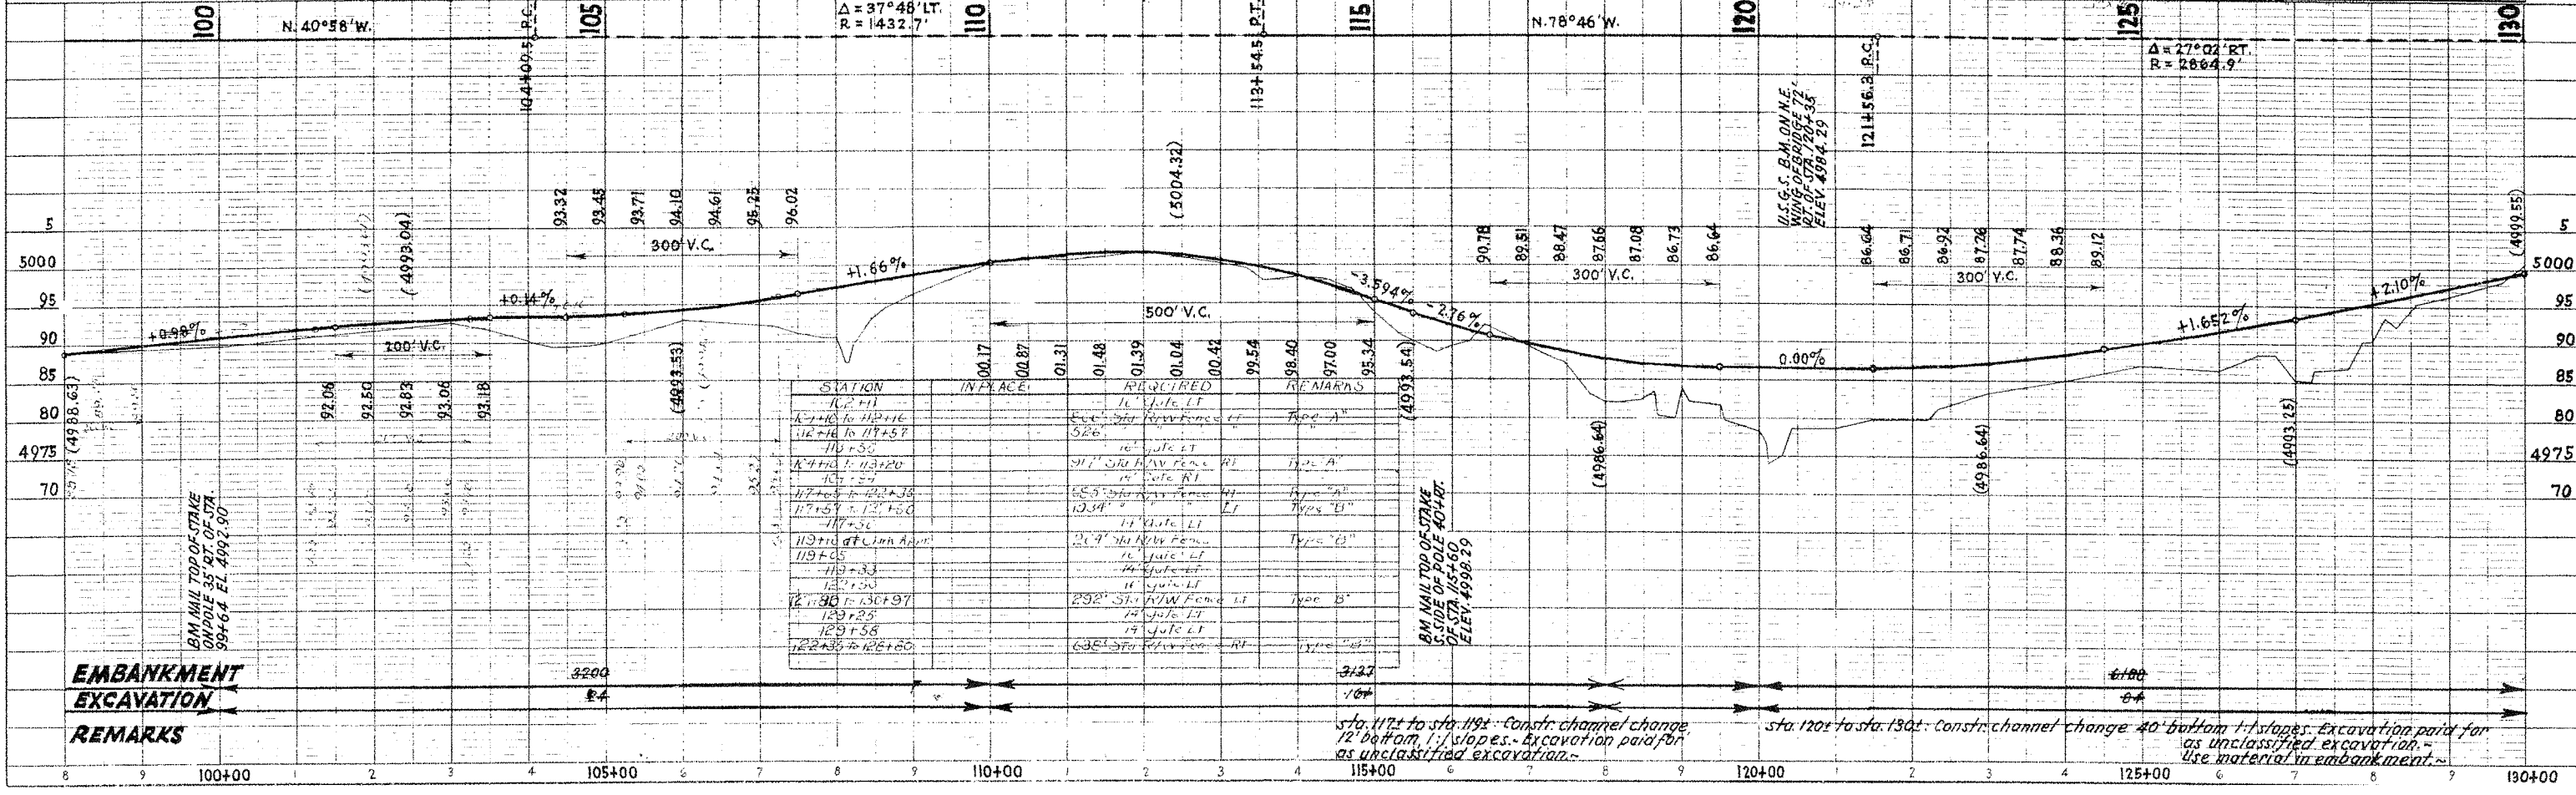


STATION	IN PLACE	REQUIRED	REMARKS

EMBANKMENT
EXCAVATION
REMARKS

sta. 112 to sta. 119: Constr. channel change 1/2 bottom, 1/2 slopes. Excavation paid for as unclassified excavation.

sta. 120 to sta. 130: Constr. channel change 40' bottom, 1/2 slopes. Excavation paid for as unclassified excavation. Use material in embankment.

Project: S-242(1)
 Sheet No. 7 of 33

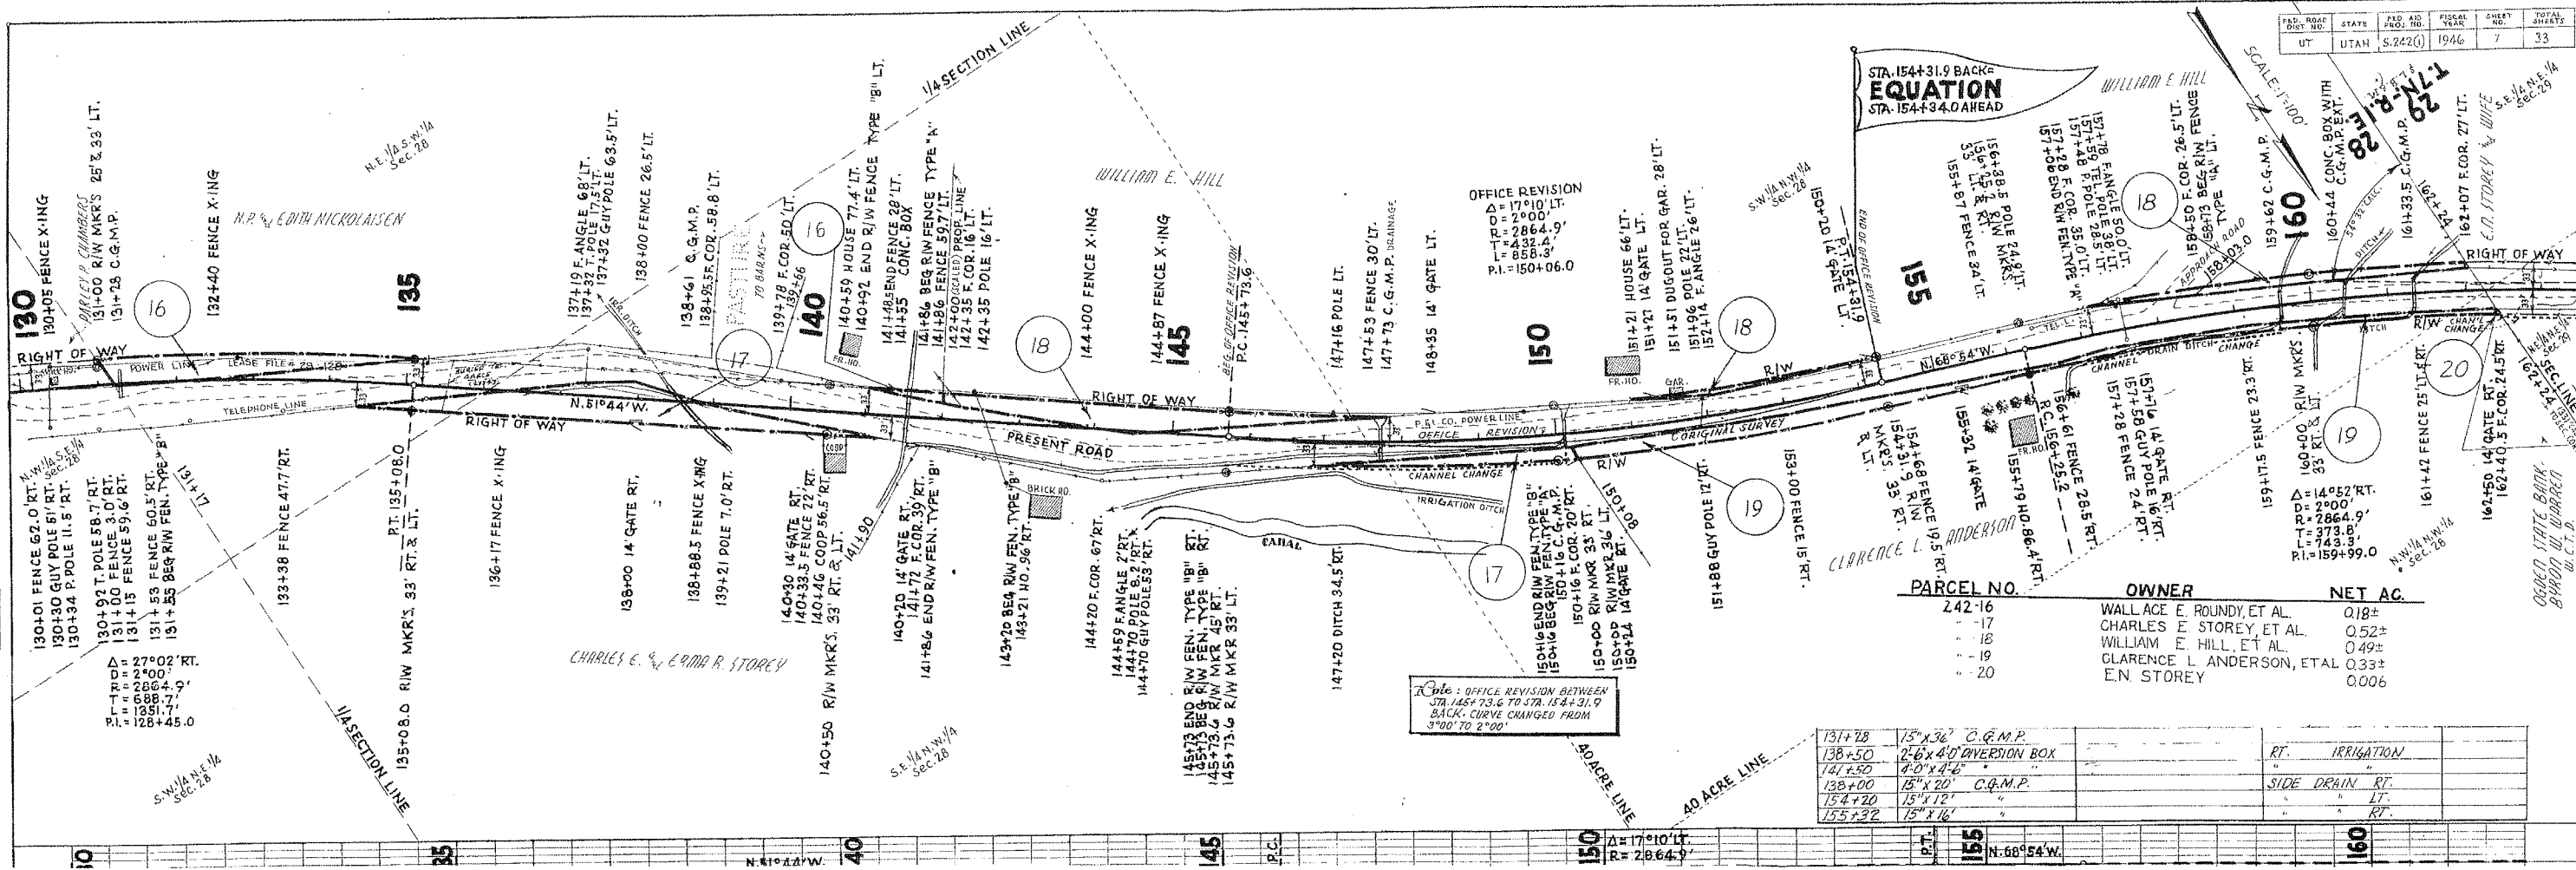

PARCEL NO.	OWNER	NET AC.
242-16	WALLACE E. ROUNDY, ET AL.	0.18±
-17	CHARLES E. STOREY, ET AL.	0.52±
-18	WILLIAM E. HILL, ET AL.	0.49±
-19	CLARENCE L. ANDERSON, ET AL.	0.33±
-20	E.N. STOREY	0.006

STATION	DESCRIPTION	RT.
131+28	15" x 36" C.G.M.P.	
138+50	2' 6" x 4' 0" DIVERSION BOX	IRRIGATION
141+50	4' 0" x 4' 0"	
138+00	15" x 20" C.G.M.P.	SIDE DRAIN RT.
154+20	15" x 12"	LT.
155+32	15" x 16"	RT.



EQUATION
 STA. 154+31.9 BACK
 STA. 154+34.0 AHEAD

SCALE: 1"=100'





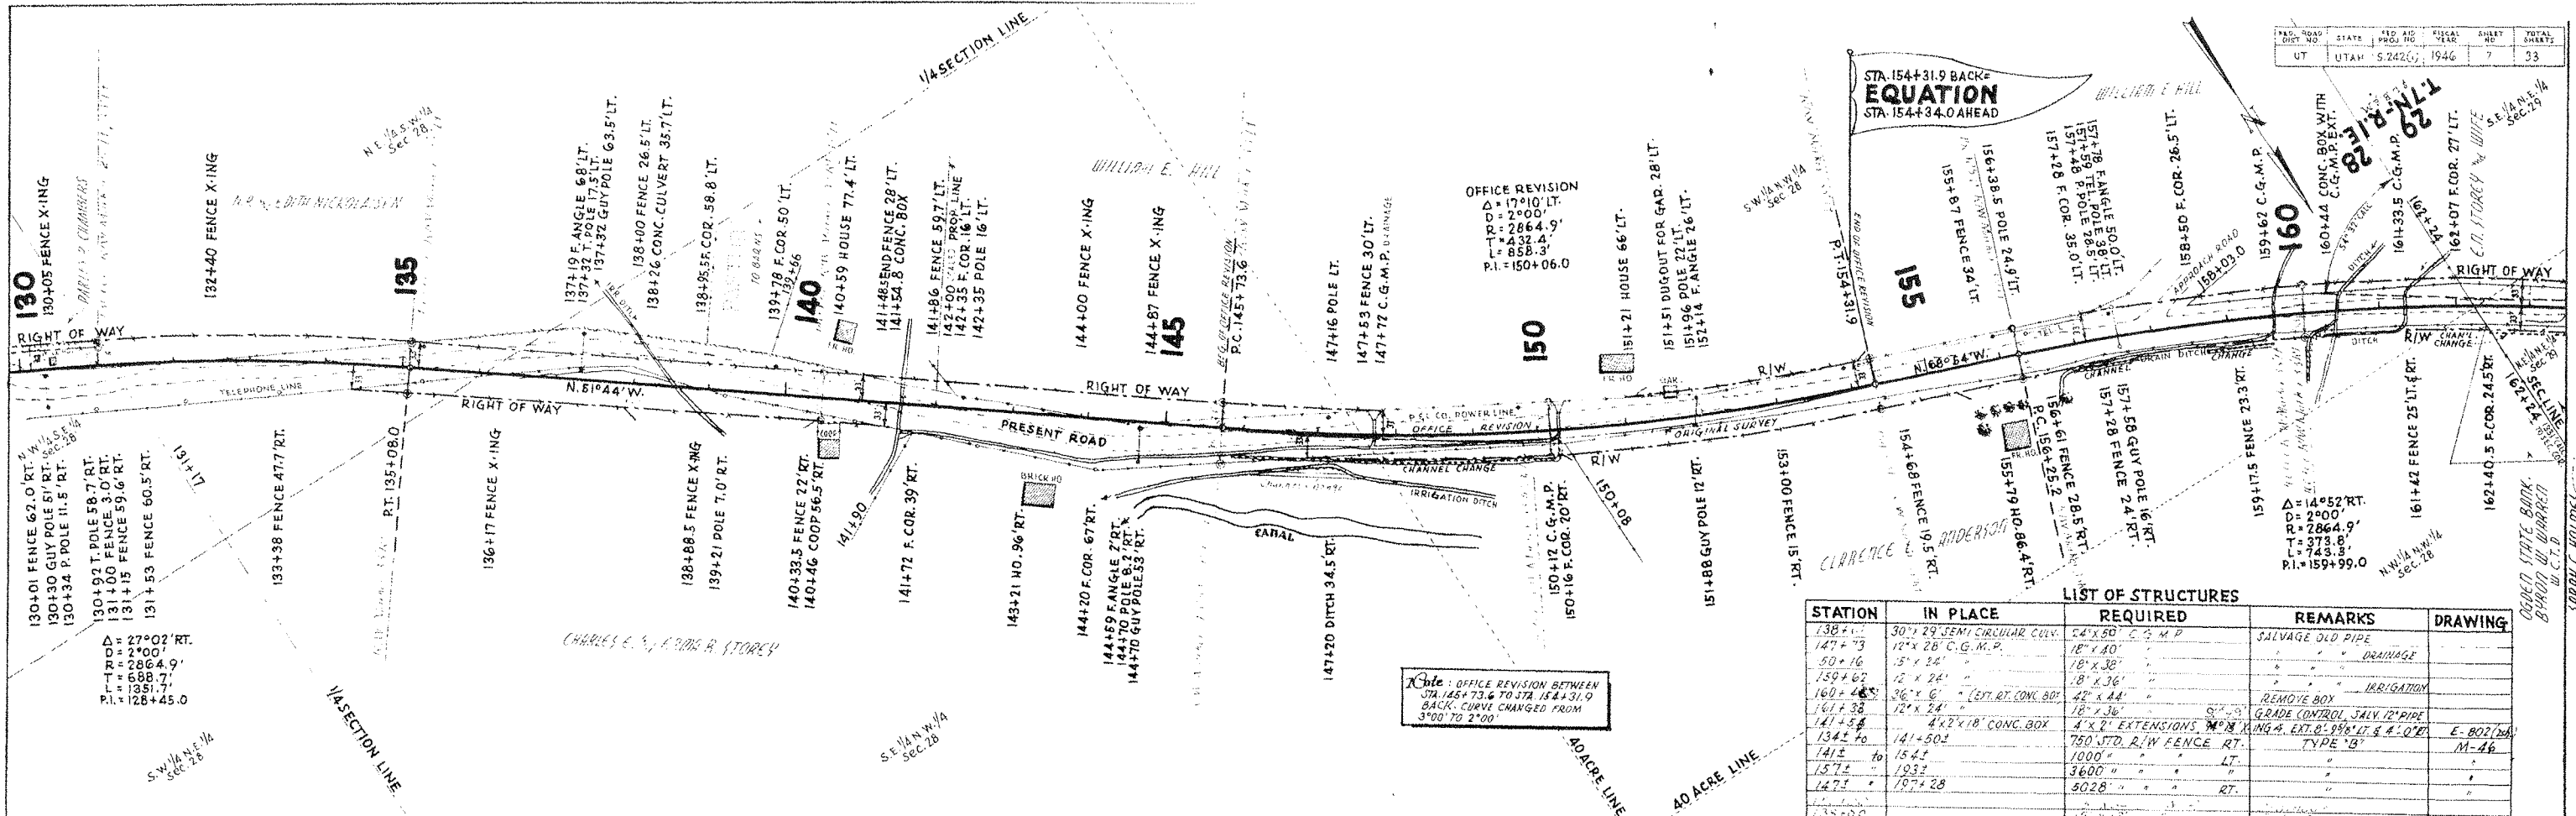


STATION	IN PLACE	REQUIRED	REMARKS	DRAWING
138+00	30" x 29" SEMI CIRCULAR CULV.	24" x 30" C.G.M.P.	SALVAGE OLD PIPE	
147+73	12" x 28" C.G.M.P.	18" x 30"	"	
50+16	15" x 24"	18" x 30"	"	
159+67	12" x 24"	18" x 36"	"	
160+48	36" x 6"	42" x 44"	REMOVE BOX	
161+38	12" x 24"	18" x 36"	"	
141+58	4' x 2' CONC. BOX	4' x 2' EXTENSIONS	GRADE CONTROL JAW 12" PIPE	E-802/26
134+00	141+50	750 STD. R/W FENCE RT.	" TYPE 'B'	M-46
141+00	154+50	1000 "	"	
157+00	1937	3600 "	"	
147+00	197+28	5028 "	"	
135+00		18" x 12"	"	

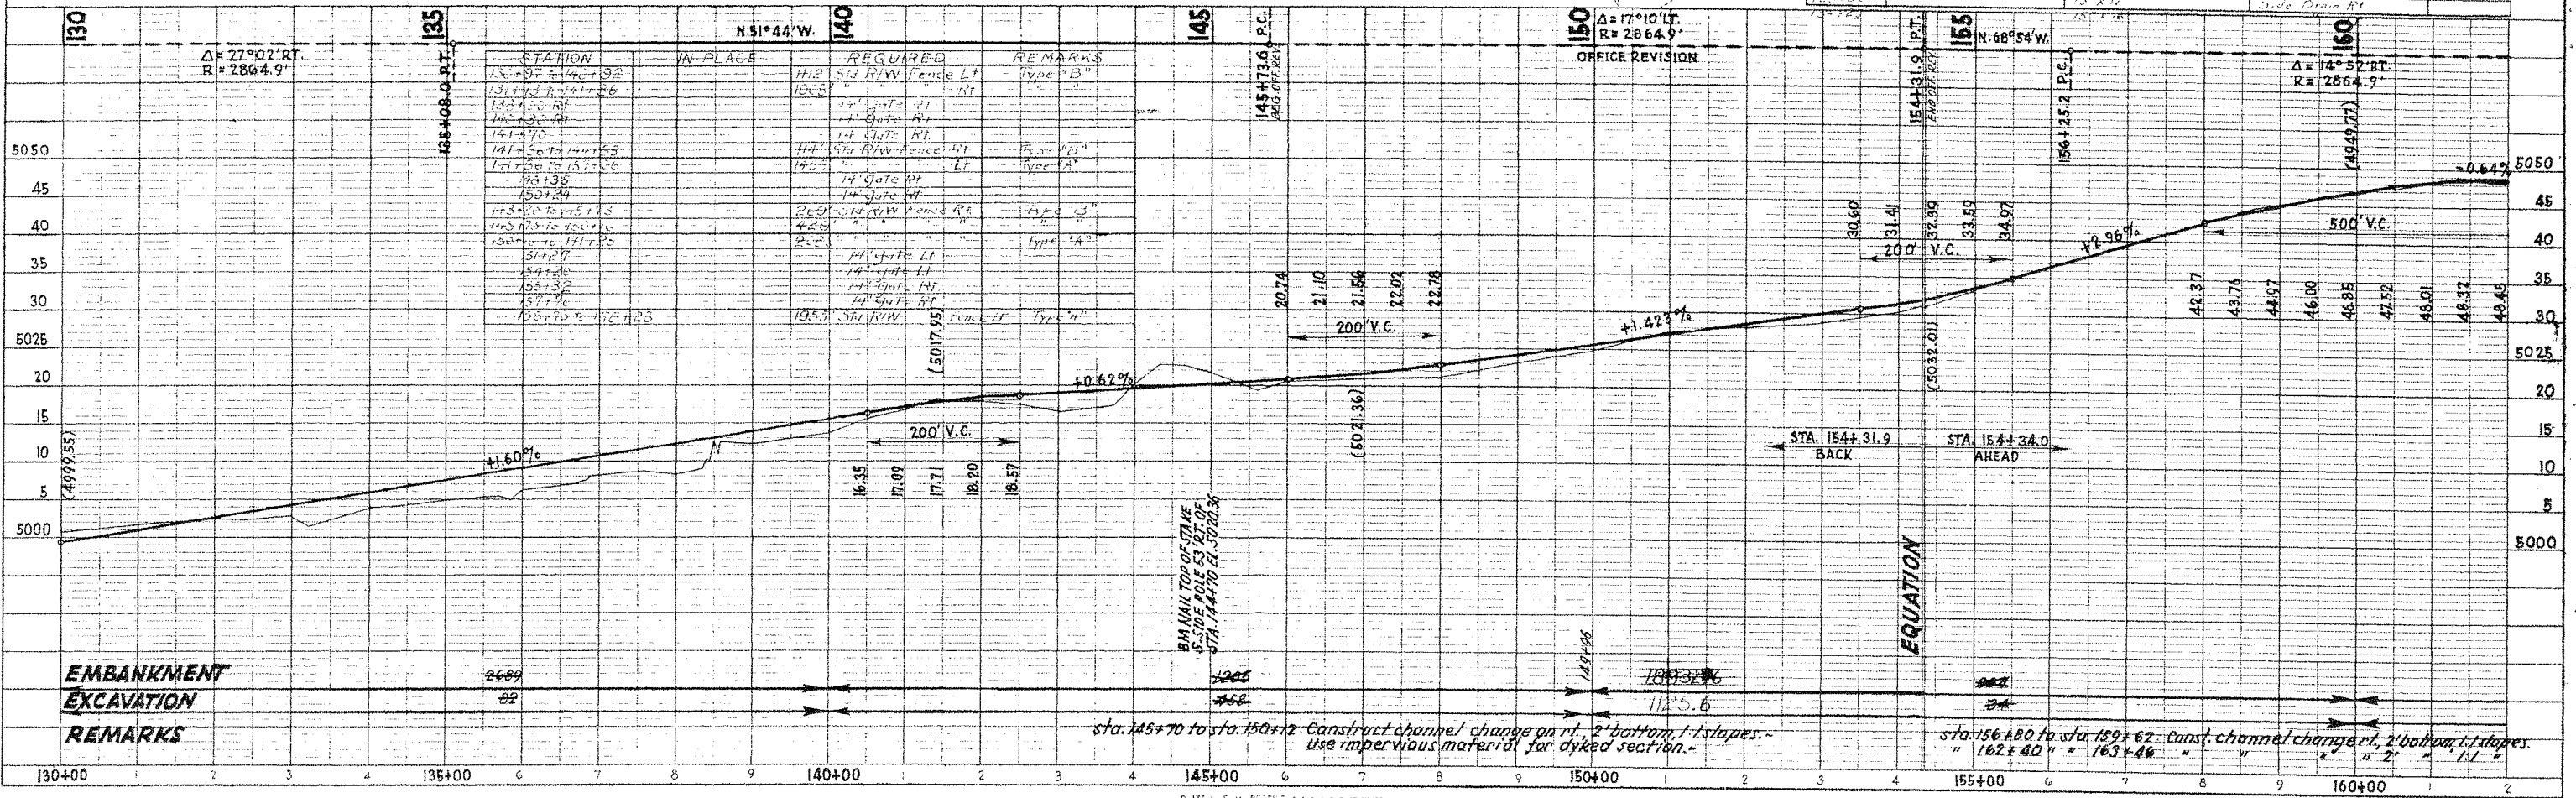

FED. ROAD DIST. NO.	STATE	FED. AID PROJ. NO.	FISCAL YEAR	EMBL. NO.	TOTAL SHEETS
UT	UTAH	5-242(0)	1946	8	33

SCALE: 1"=100'

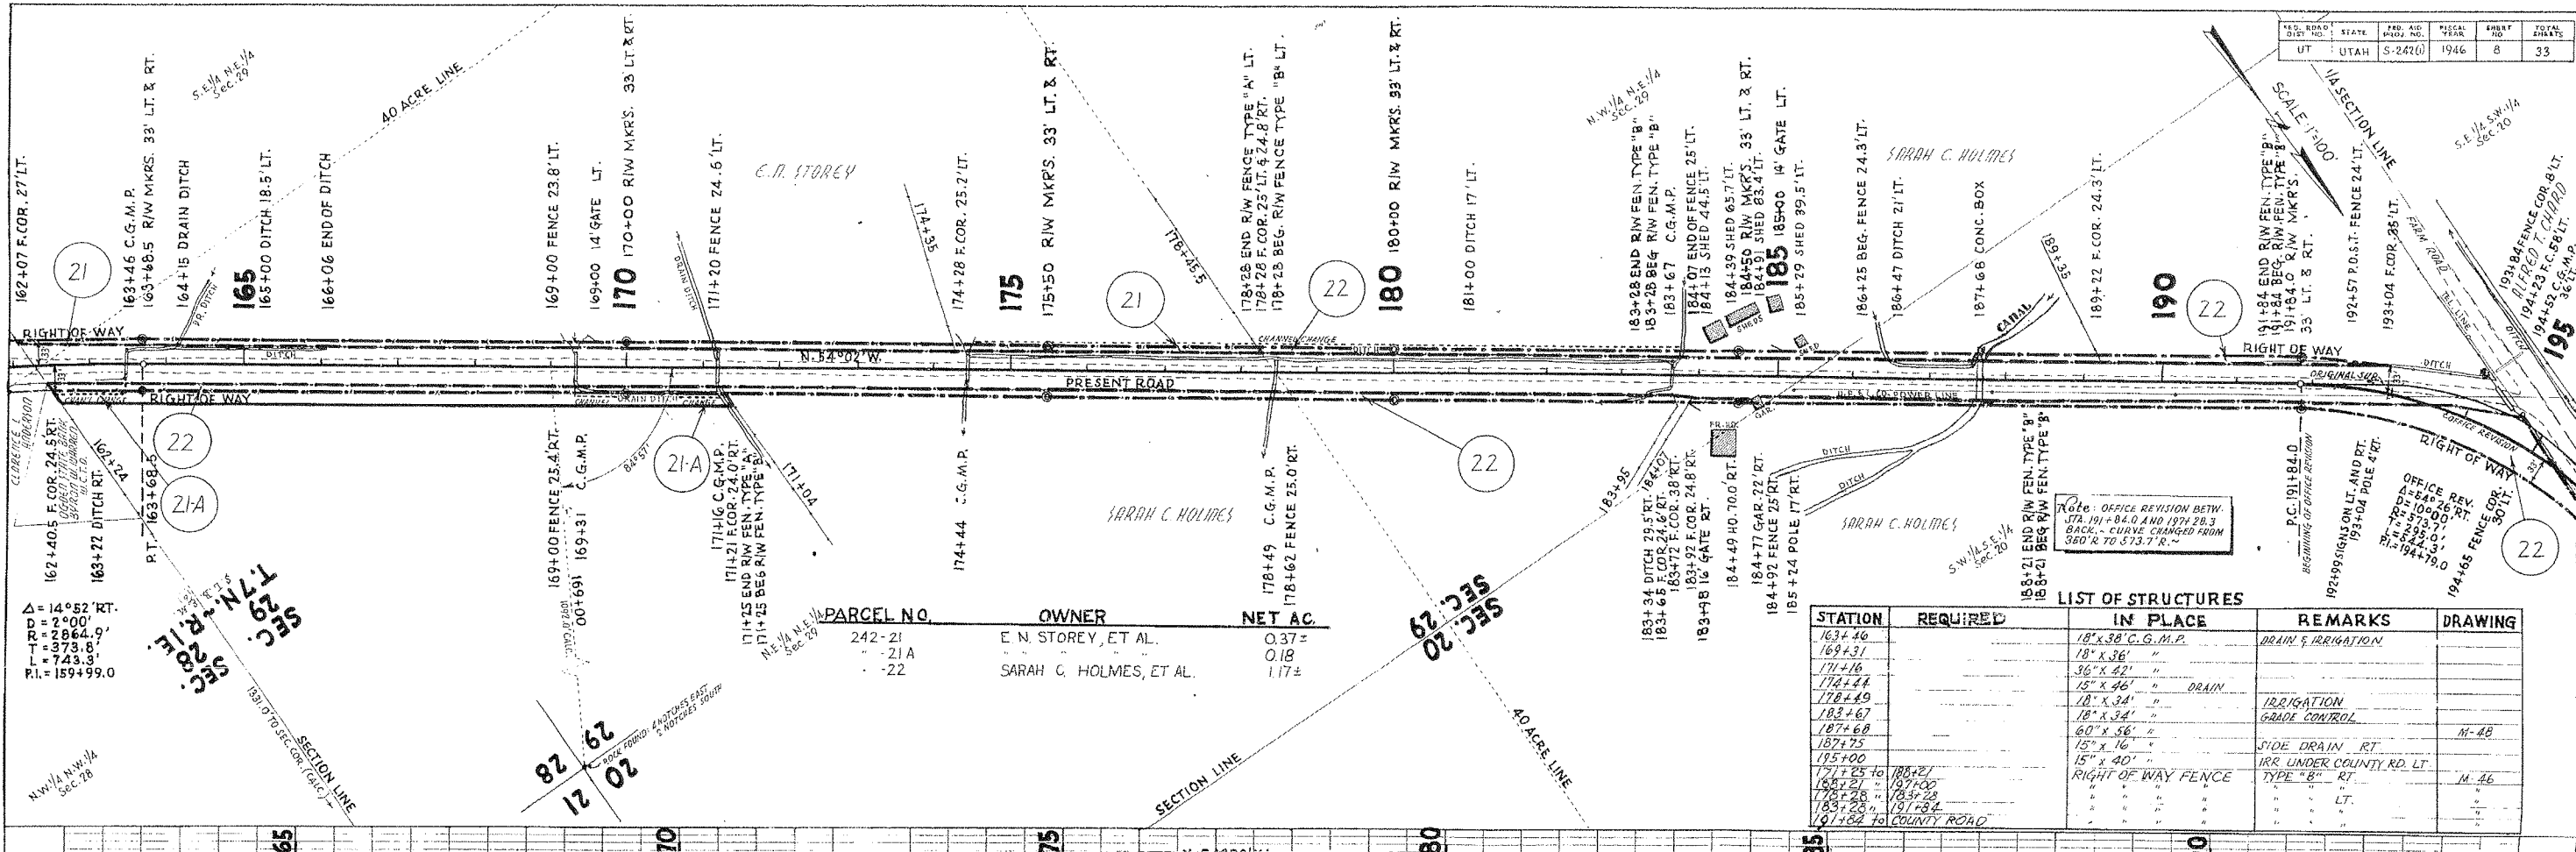

Product: S-242 (1)
 County: 972
 Route: 162
 Plan: PLAN
 Note Book: NO. 3, 4, 5, 6, 7, 8, 9
 Sheet: 9

Δ = 14° 52' RT.
 D = 2900'
 R = 2664.9'
 T = 373.8'
 L = 743.3'
 P.I. = 159+99.0

PARCEL NO.	OWNER	NET AC.
242-21	E. N. STOREY, ET AL.	0.37±
-21A	"	0.18
-22	SARAH C. HOLMES, ET AL.	1.17±

STATION	REQUIRED	IN PLACE	REMARKS	DRAWING
163+46		18" x 30" C.G.M.P.	DRAIN & IRRIGATION	
169+31		18" x 36" "	"	
171+16		36" x 42" "	"	
174+44		15" x 46" "	DRAIN	
178+49		18" x 34" "	IRRIGATION	
183+67		18" x 34" "	GRADE CONTROL	
187+68		60" x 56" "	"	M-48
187+75		15" x 16" "	SIDE DRAIN RT	
185+00		15" x 40" "	IRR. UNDER COUNTY RD. LT.	
191+84 to COUNTY ROAD		" " " "	" " " "	"


NOTE: OFFICE REVISION BETW. STA. 191+84.0 AND 197+28.3 BACK - CURVE CHANGED FROM 360' R TO 573.7' R.

OFFICE REV. 4-5-46 26 RT. D=1000' T=273.0' L=524.3' P.I.=194+79.0

FED. ROAD DIST.	STATE	FED. AID YEAR	FISCAL YEAR	SHEET NO.	TOTAL SHEETS
UT	UTAH	5-242(0)	1946	8	33


PLAN
 CURVES
 NOTED
 REVISIONS
 CHECKED
 DATE

PROFILE
 CHECKED
 DATE
 REVISIONS
 CHECKED
 DATE

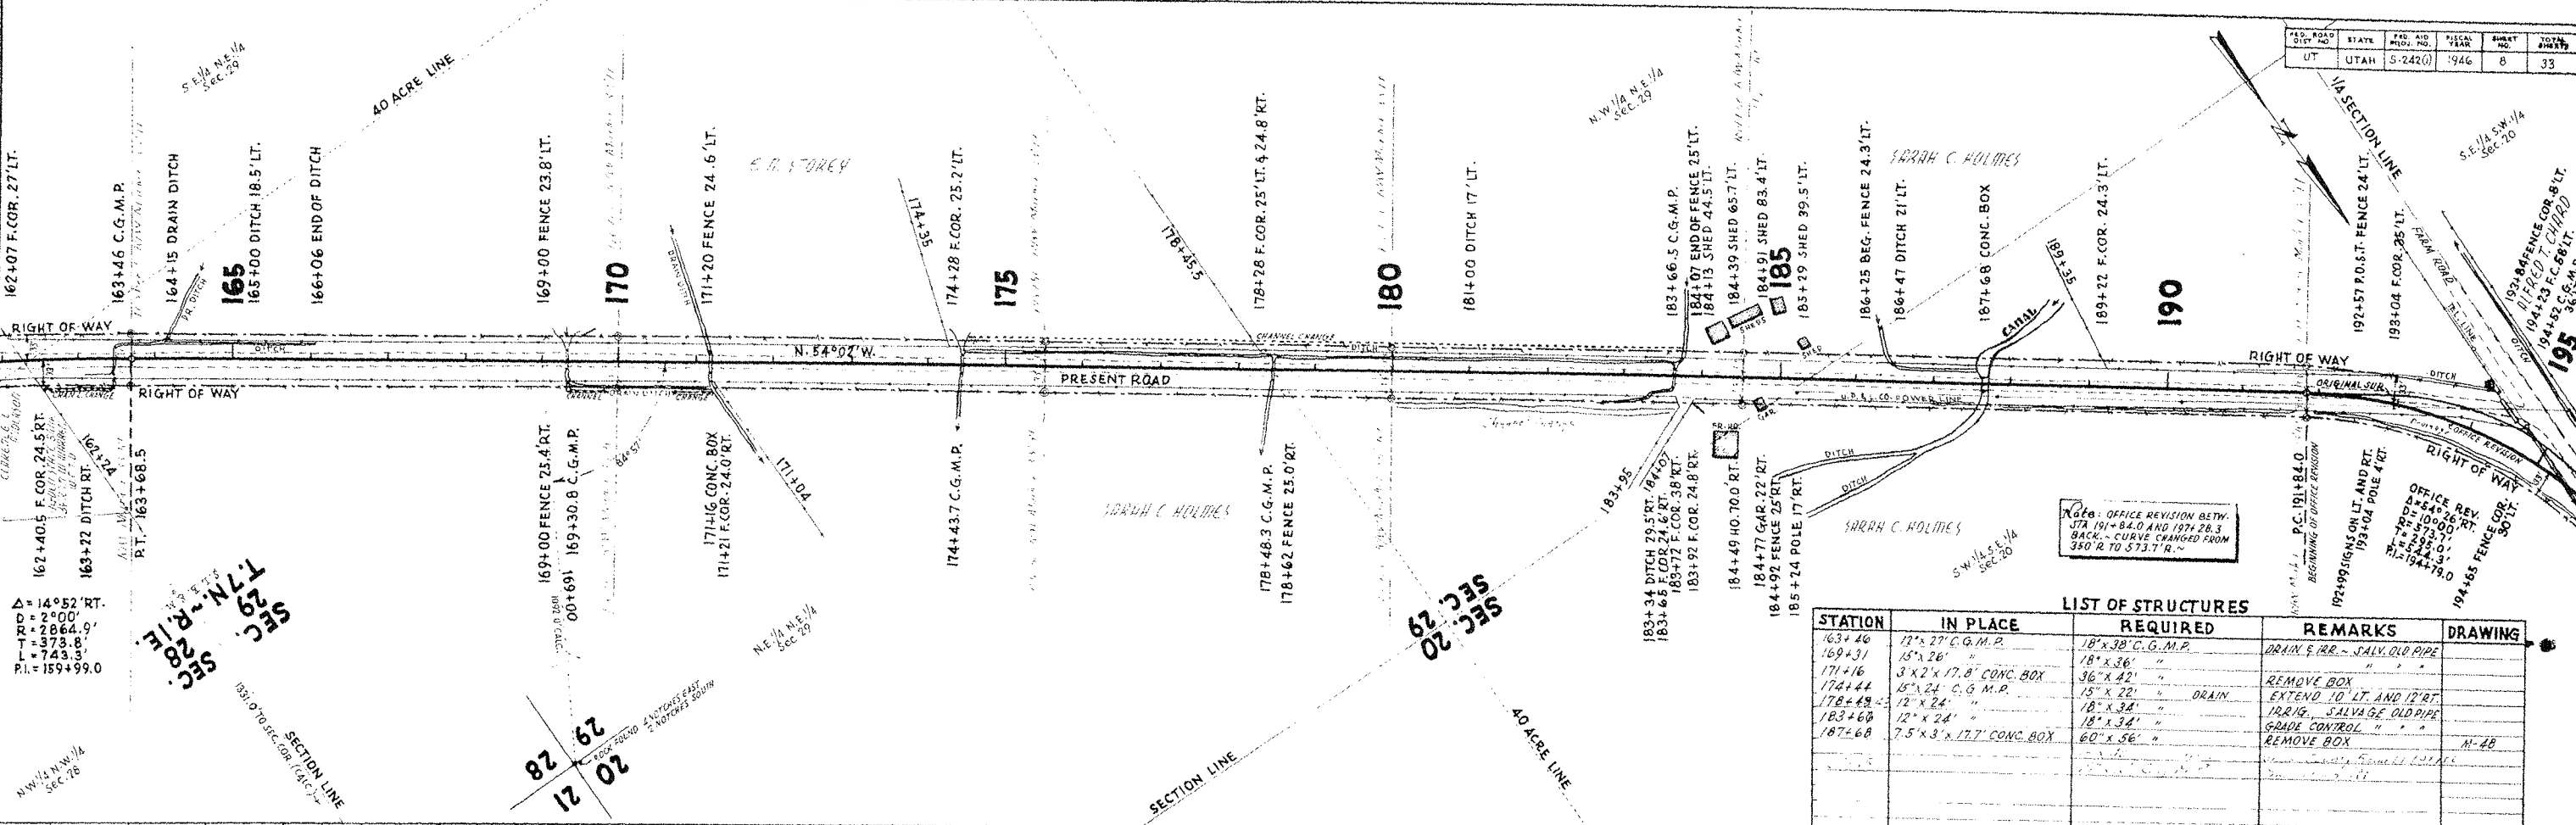


LIST OF STRUCTURES

STATION	IN PLACE	REQUIRED	REMARKS	DRAWING
163+46	12" x 27" C.G.M.P.	18" x 38" C.G.M.P.	DRAIN & RR - SALV. OLD PIPE	
169+31	15" x 26"	18" x 36"	"	
171+16	3' x 2' x 17.8' CONC. BOX	36" x 42"	REMOVE BOX	
174+44	15" x 24" C.G.M.P.	15" x 22"	EXTEND 10' LT. AND 12' RT.	
178+49	12" x 24"	18" x 34"	RR 1/2" SALVAGE OLD PIPE	
183+68	12" x 24"	18" x 34"	GRADE CONTROL "	
187+68	7.5' x 3' x 17.7' CONC. BOX	60" x 56"	REMOVE BOX	M-48

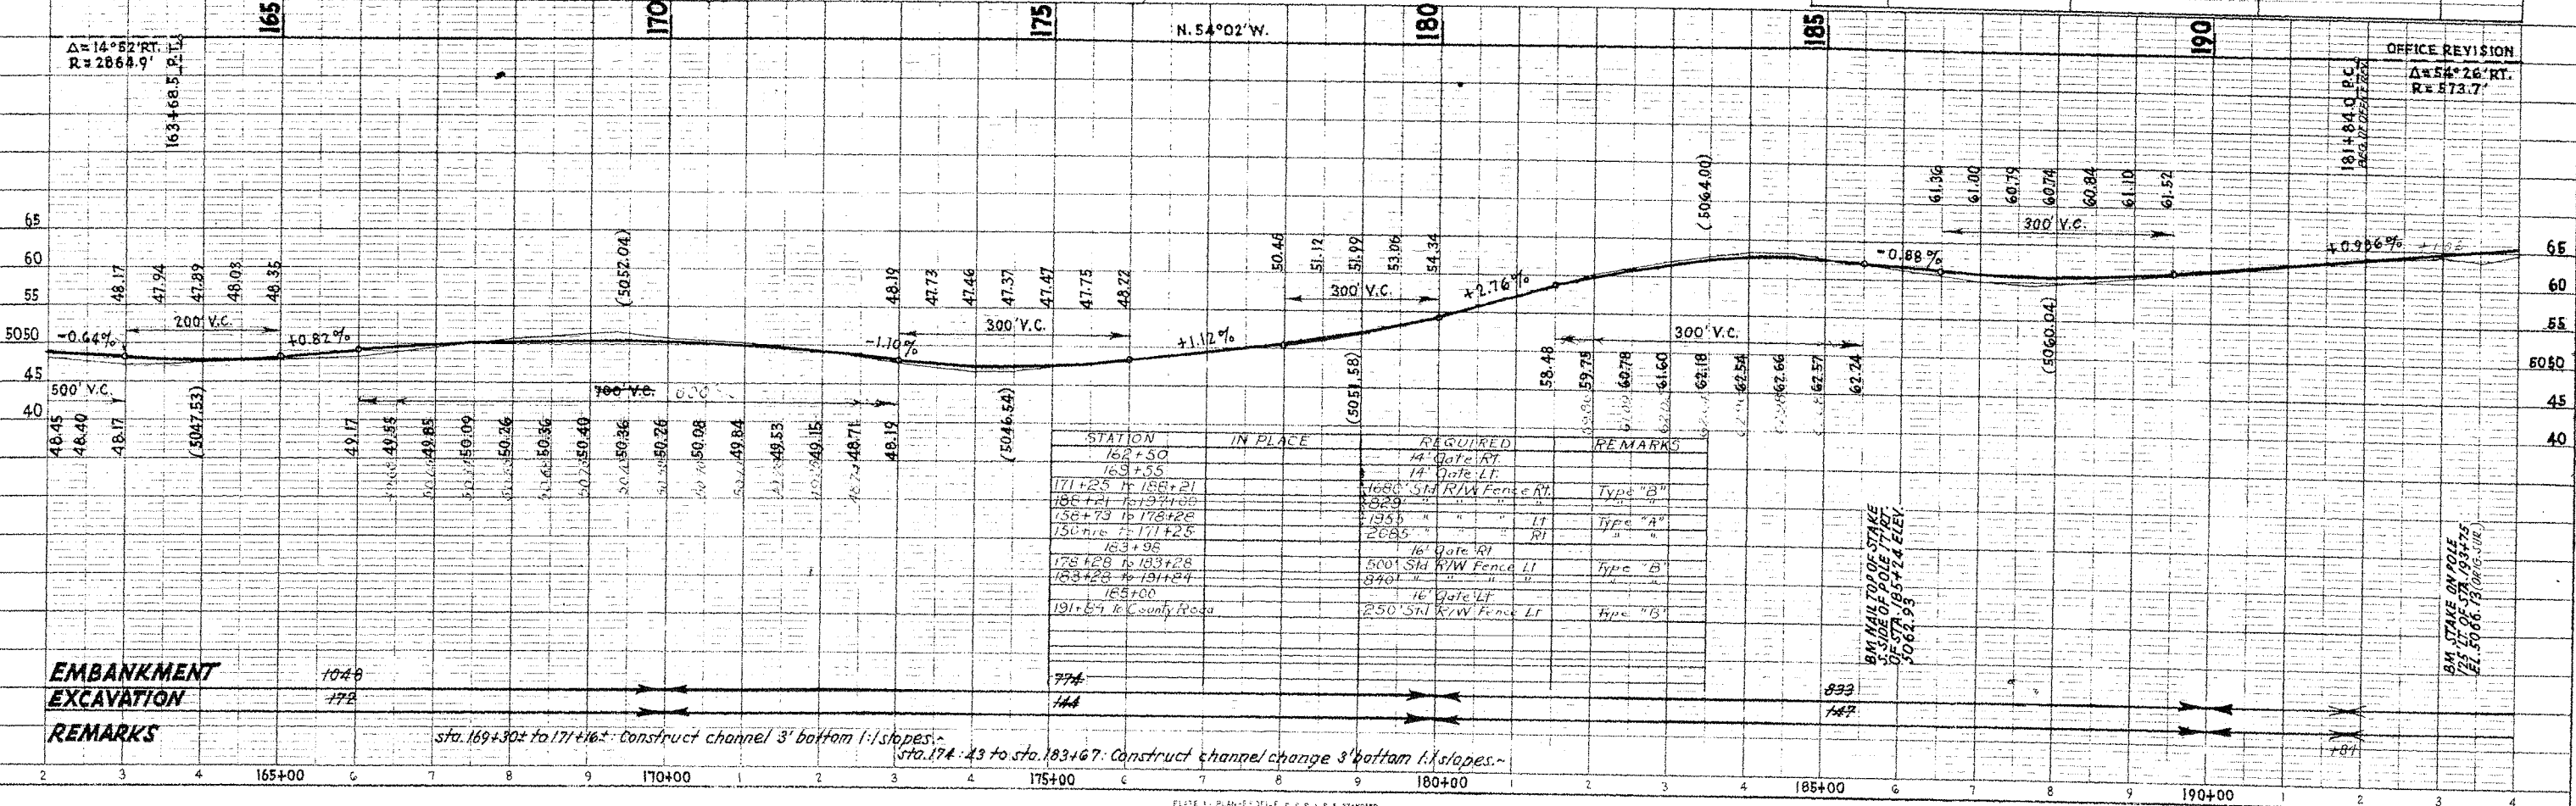

Project: S-242 (17)
 County: 057
 Assessor: 1/12
 Note Book: 5632
 Sheet: 9

PLAN
 NO. 5632

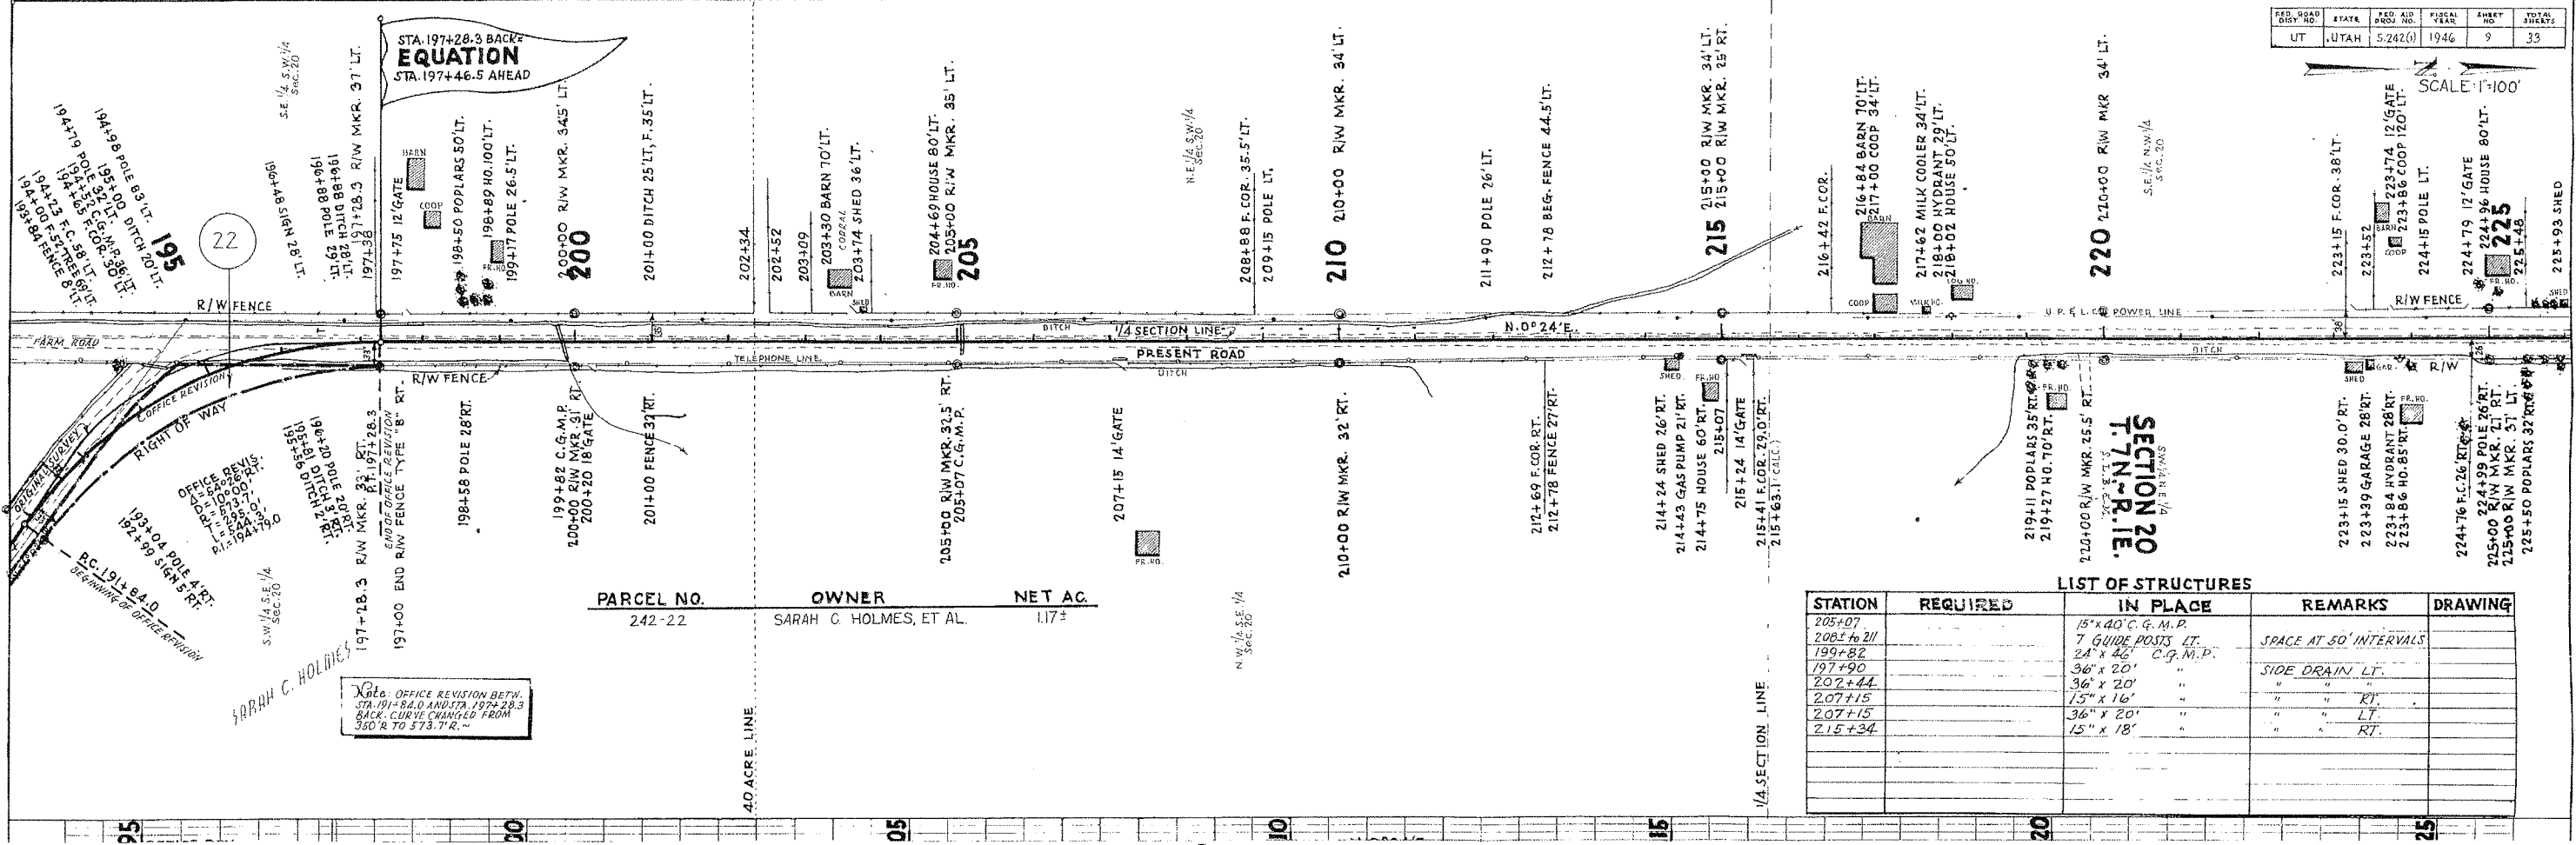

PARCEL NO.	OWNER	NET AC.
242-22	SARAH C. HOLMES, ET AL.	1.17±

SECTION 20 T.N.-R.I.E.

LIST OF STRUCTURES

STATION	REQUIRED	IN PLACE	REMARKS	DRAWING
205+07		15' x 40' C.G.M.P.		
208± to 211		7 GUIDE POSTS LT.	SPACE AT 50' INTERVALS	
199+82		24' x 46' C.G.M.P.		
197+90		36' x 20'	SIDE DRAIN LT.	
202+44		36' x 20'	" " RT.	
207+15		15' x 16'	" " RT.	
207+15		36' x 20'	LT.	
215+34		15' x 18'	" " RT.	



FED. ROAD DIST. NO.	STATE	FED. AID PROJ. NO.	FISCAL YEAR	SHEET NO.	TOTAL SHEETS
UT	UTAH	5-242(6)	1946	9	33

SCALE 1"=100'

PLAN
 SURVEYED BY C. M. LEONARD
 PLOTTED BY C. M. LEONARD
 CHECKED BY H. M. ERBRIEL
 DATE 10/15/45
 NO. 5432, 1764 CD


PROFILE
 SURVEYED BY C. M. LEONARD
 PLOTTED BY C. M. LEONARD
 CHECKED BY H. M. ERBRIEL
 DATE 10/15/45
 NO. 5432, 1764 CD

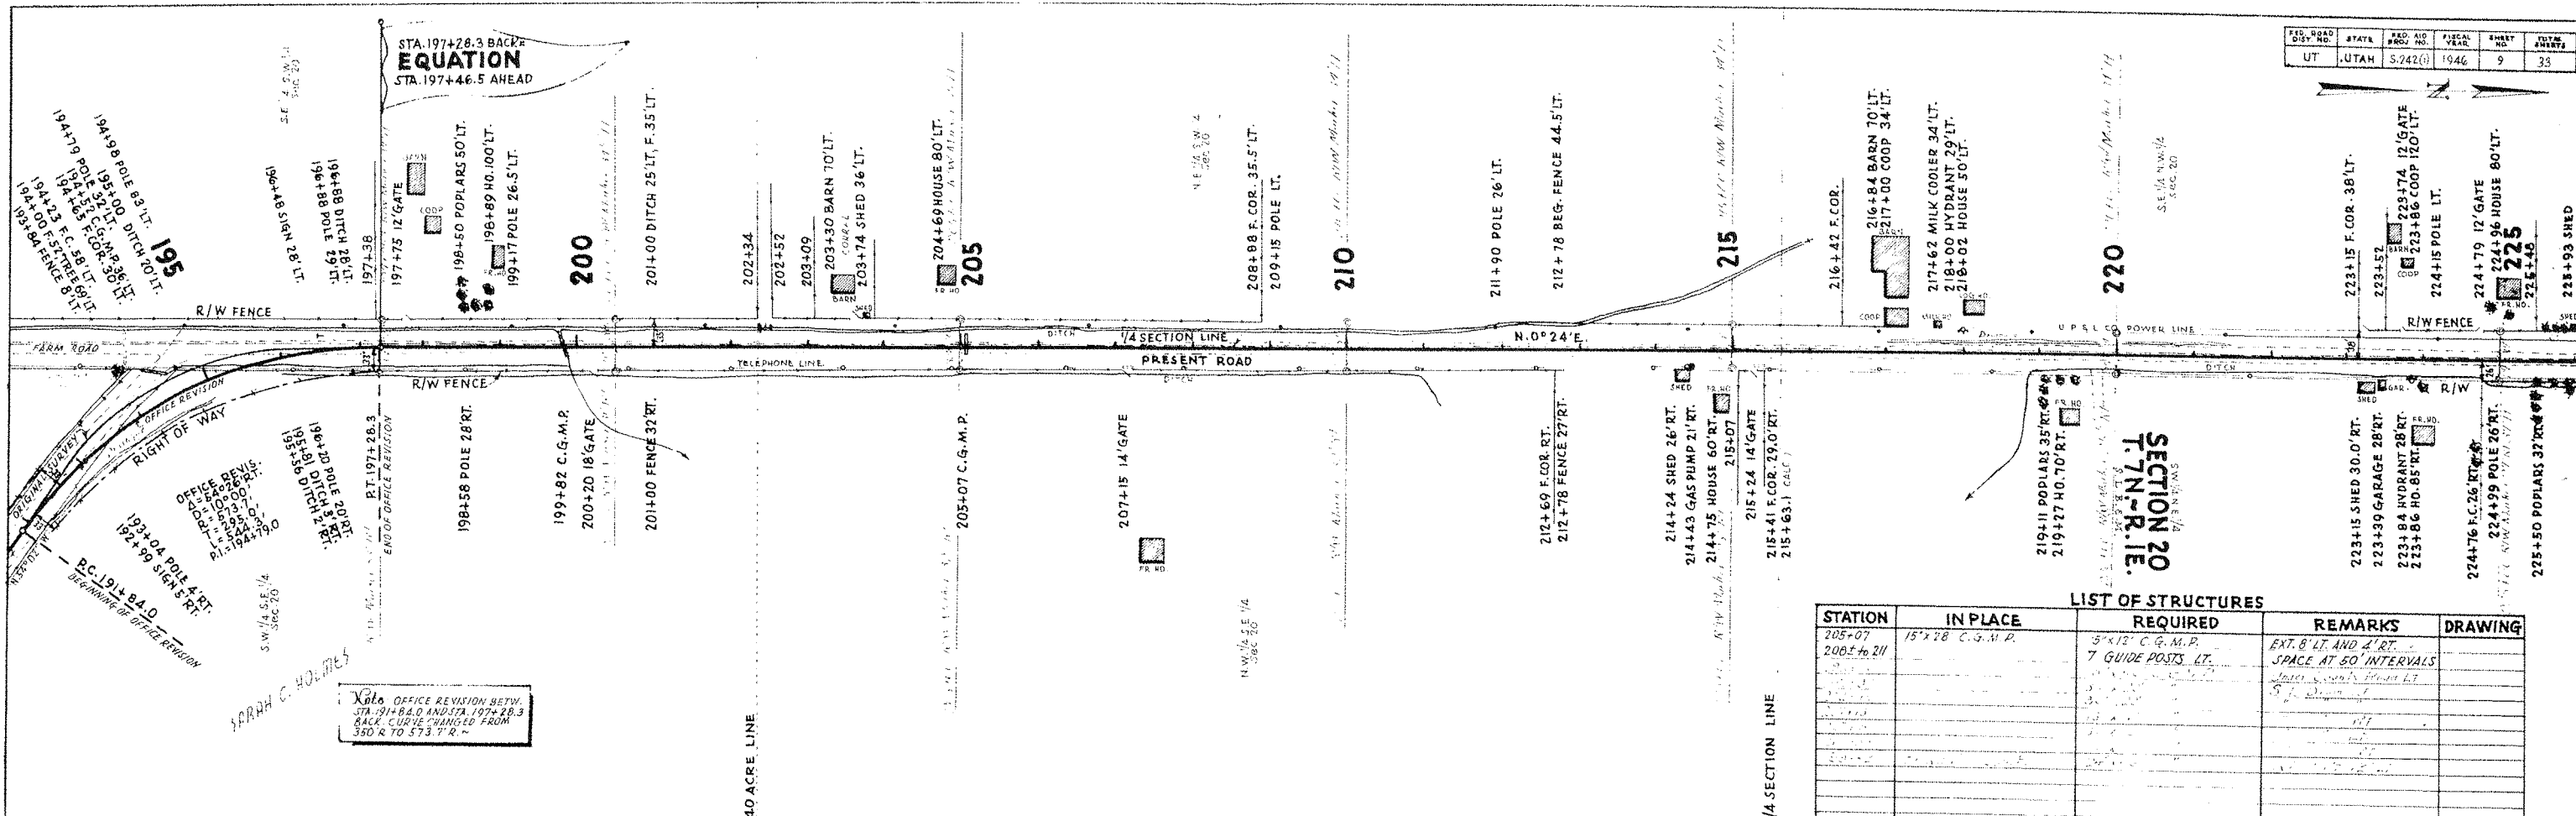

**SECTION 20
T. 7N., R. 1E.**

LIST OF STRUCTURES

STATION	IN PLACE	REQUIRED	REMARKS	DRAWING
205+07	15'x28' C.G.M.P.	5'x12' C.G.M.P.	EXT. 8' LT. AND 4' RT.	
			UNDER EXISTING FENCE LT.	
			5' FROM	

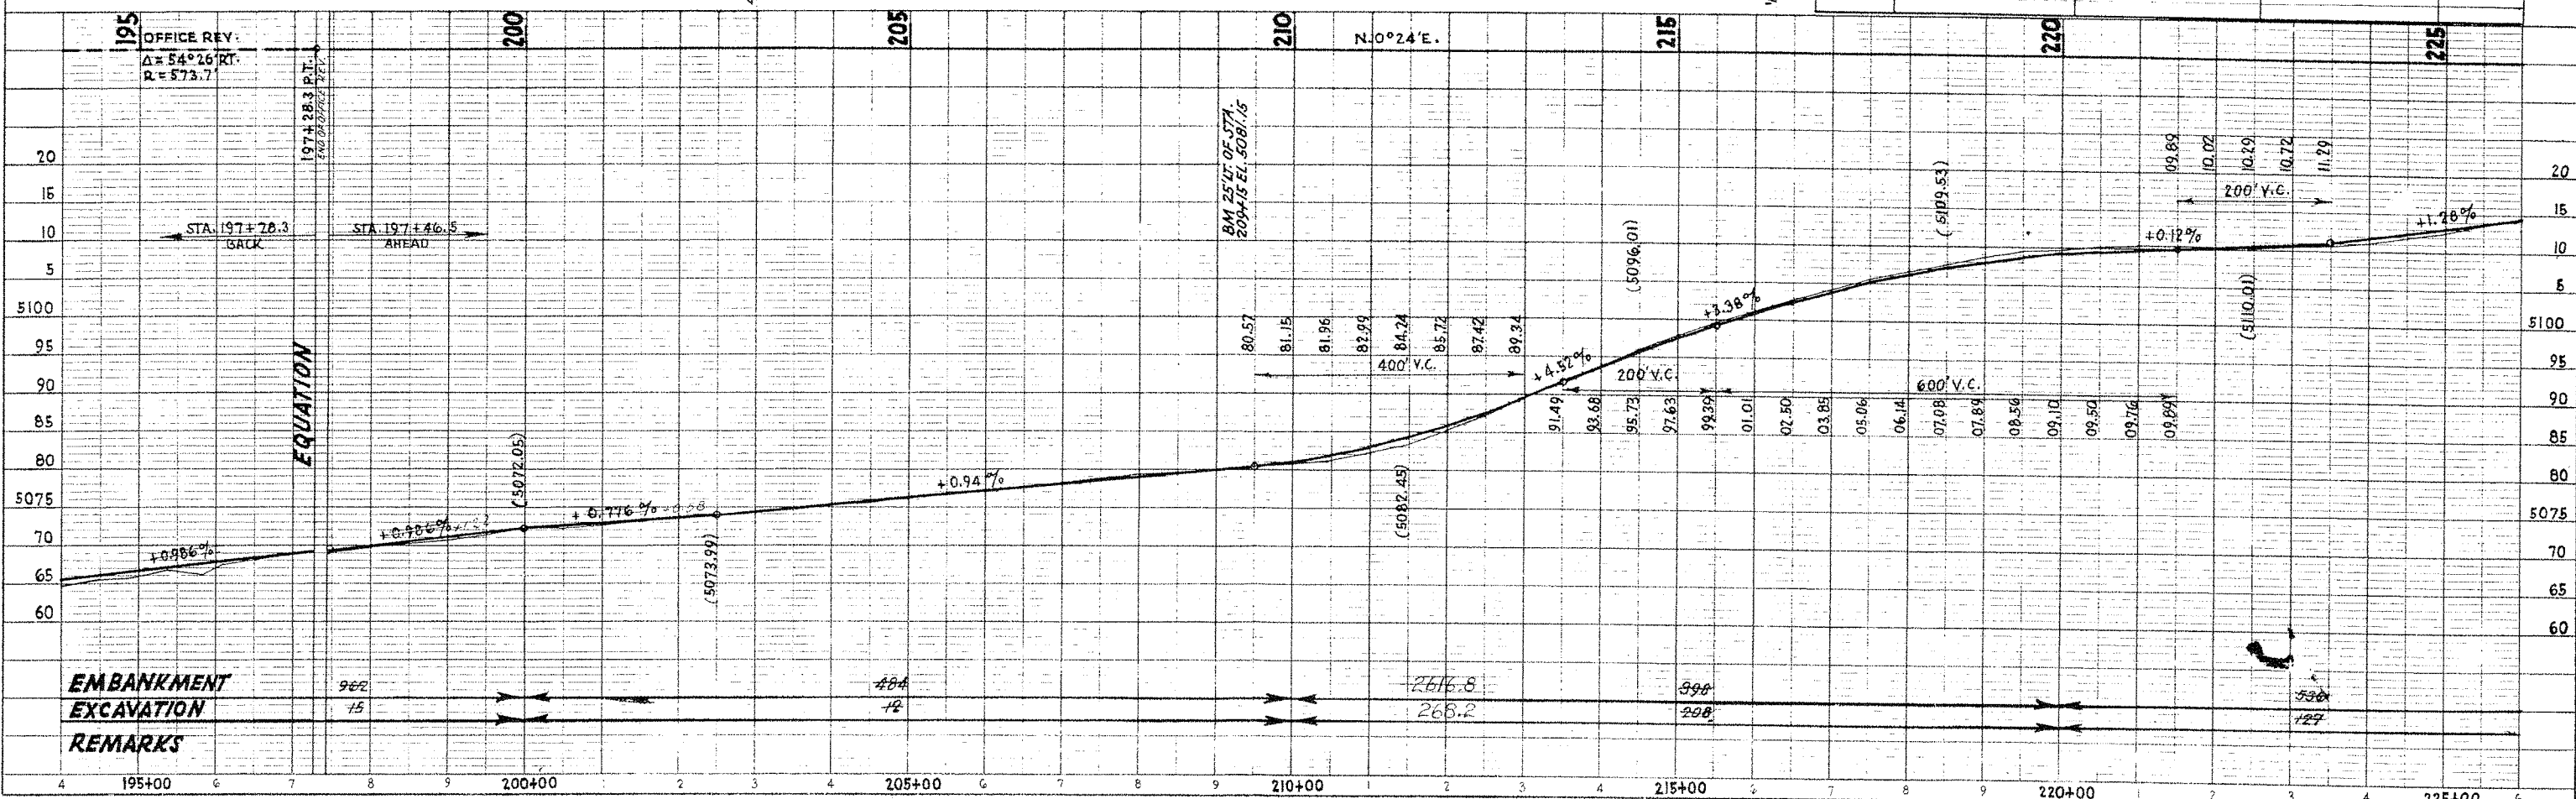


EMBANKMENT
EXCAVATION
REMARKS

FED. ROAD DIST. NO.	STATE	FED. AID PROJ. NO.	FISCAL YEAR	SHEET NO.	TOTAL SHEETS
UT	UTAH	S-242(1)	1946	10	33

SCALE 1"=100'

PARCEL NO.	OWNER	NET AC.
242-23-E	JOHN S. WHITELY, ET AL	0.025
-24-E	EVERETT E. CANTLIN, ET AL.	0.025

LIST OF STRUCTURES				
STATION	REQUIRED	IN PLACE	REMARKS	DRAWING
236+74		18" x 36" C.G.M.P.		
241+22		30" x 56"	GRADE CONTROL	
231+50		3' x 1.3' x 30.0' CONC. BOX		SC 234-1-20
232+47		3' x 1' x 18' CONC. BOX	ABANDON	
232+71		18" x 36" C.G.M.P.	IRRIGATION	
232+50		15" x 12"	SIDE DRAIN RT.	
234+20		15" x 18"	"	
235+06		15" x 8"	"	
235+60		15" x 60"	"	
236+50		15" x 20"	" LT.	
236+45		15" x 14"	" RT.	
241+41		PROJECT MARKER	LEFT	

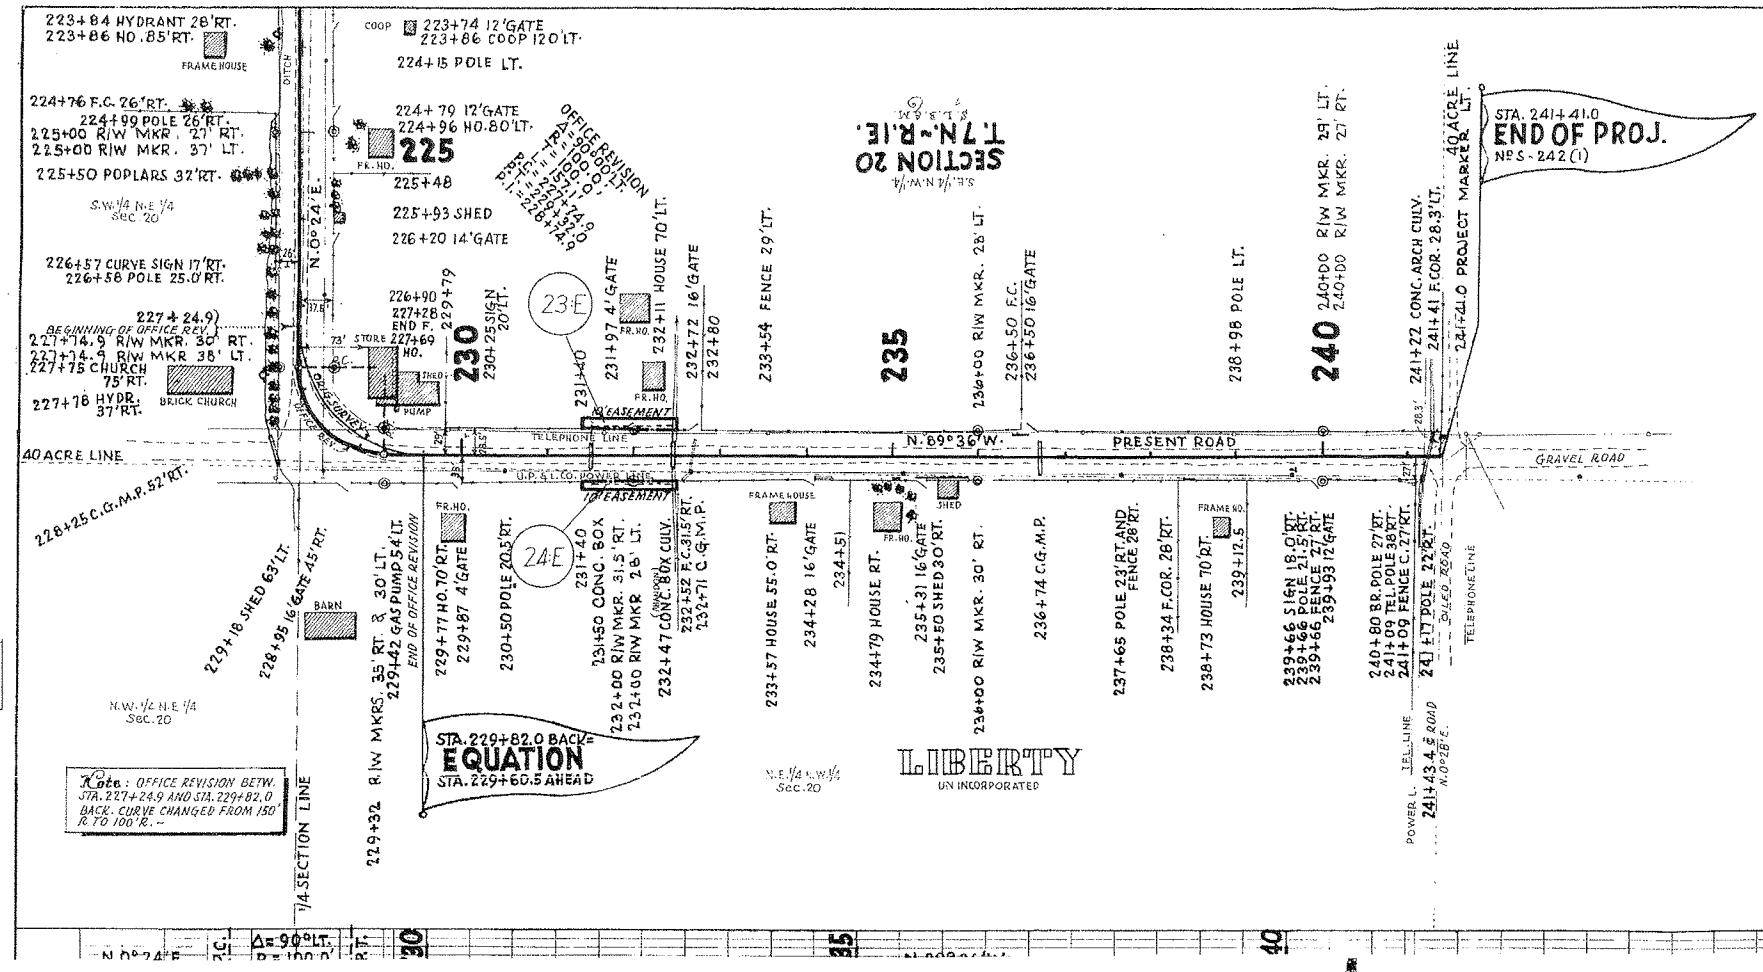

Project: S-242 (1)
 County: 957
 Note Book: 762
 No. 2420

Note: OFFICE REVISION BETW. STA. 227+24.9 AND STA. 229+82.0 BACK CURVE CHANGED FROM 150 R. TO 100 R.