



DATE 10-48
 BY J.P. THORNTON
 CHECKED
 ALIGNED
 PLANNED
 REVISIONS

PROFILE
 NO. 5223
 BY C.M. FOSBERG
 DATE 10-48
 CHECKED J.P. THORNTON
 REVISIONS

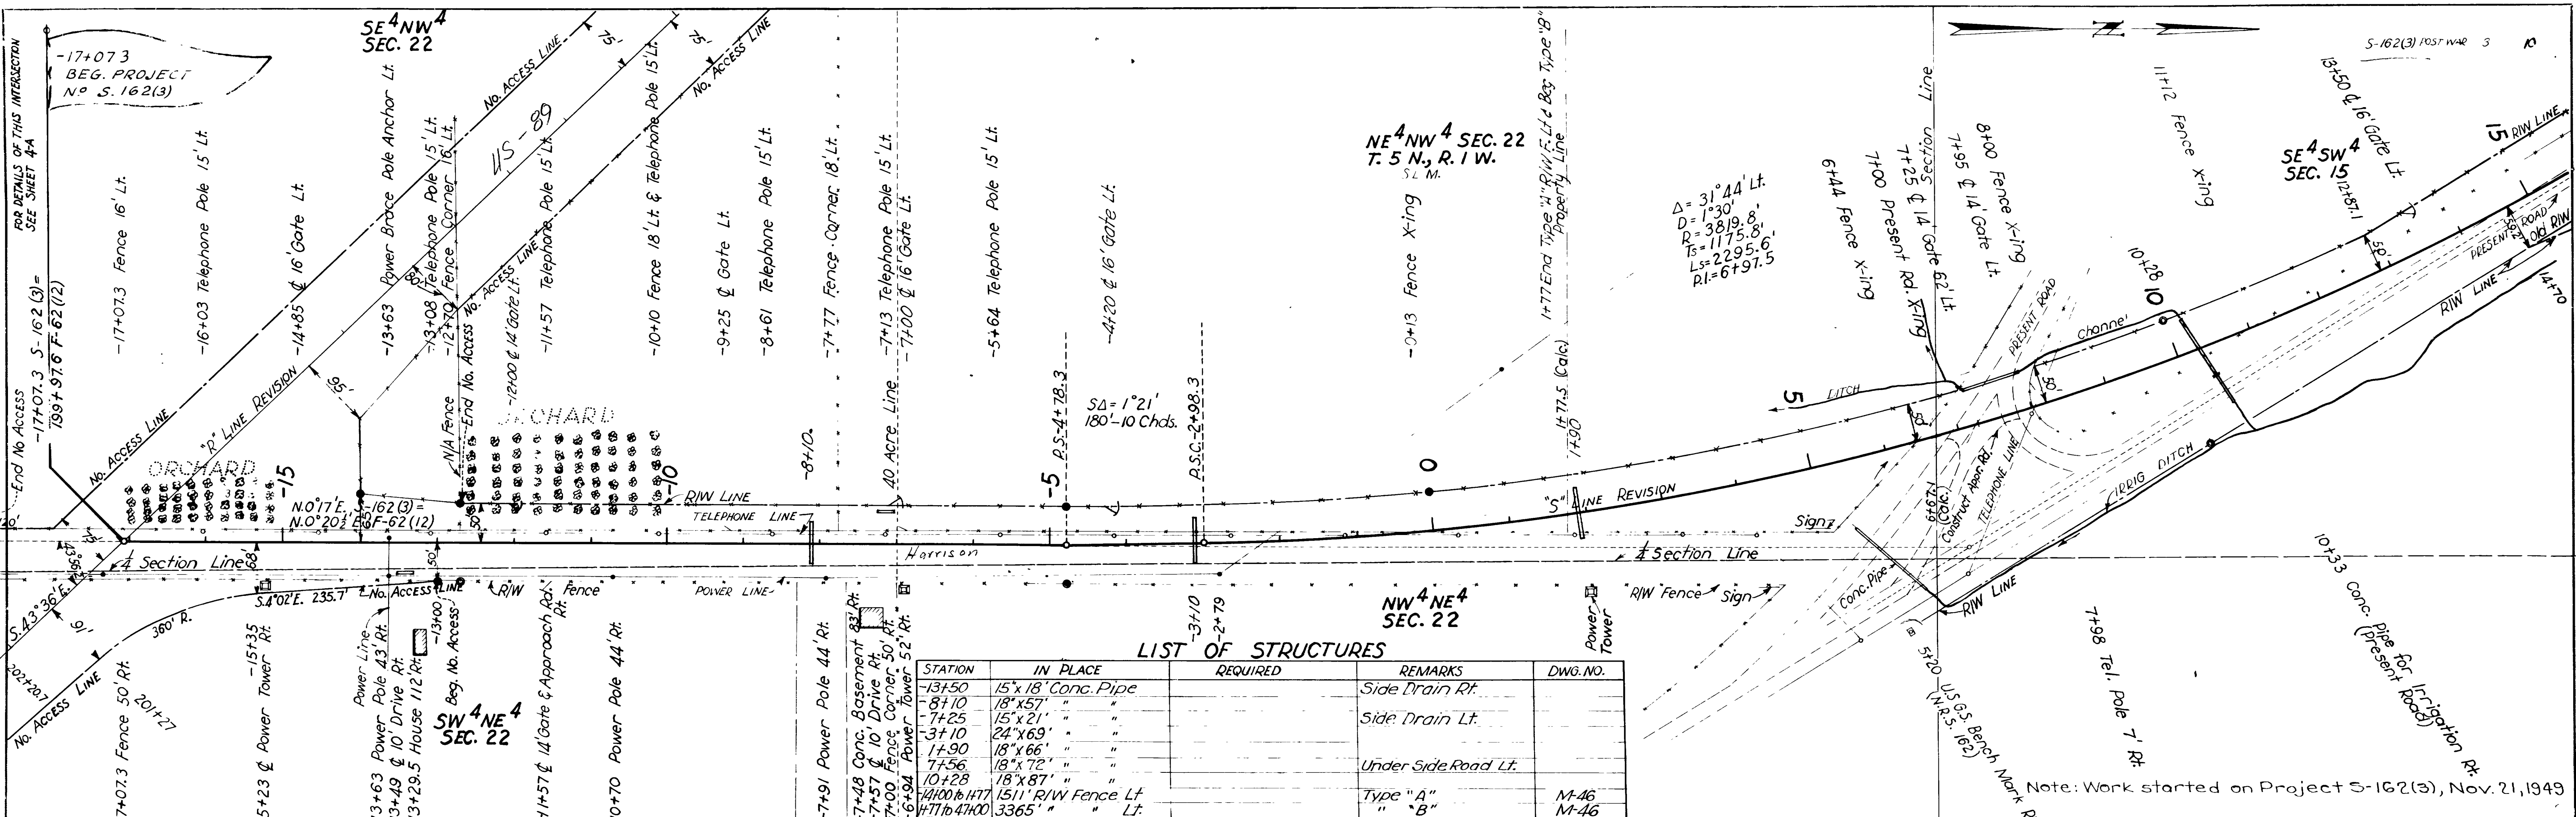

LIST OF STRUCTURES

STATION	IN PLACE	REQUIRED	REMARKS	DWG. NO.
-13+50	15' x 18' Conc. Pipe		Side Drain Rt.	
-8+10	18' x 57' "		Side Drain Lt.	
-7+25	15' x 21' "			
-3+10	24' x 69' "			
1+90	18' x 66' "			
7+56	18' x 72' "		Under Side Road Lt.	
10+28	18' x 87' "			
14+00 to 14+17	1511' R/W Fence Lt.		Type "A"	M-46
14+17 to 14+100	3365' " Lt.		" B"	M-46

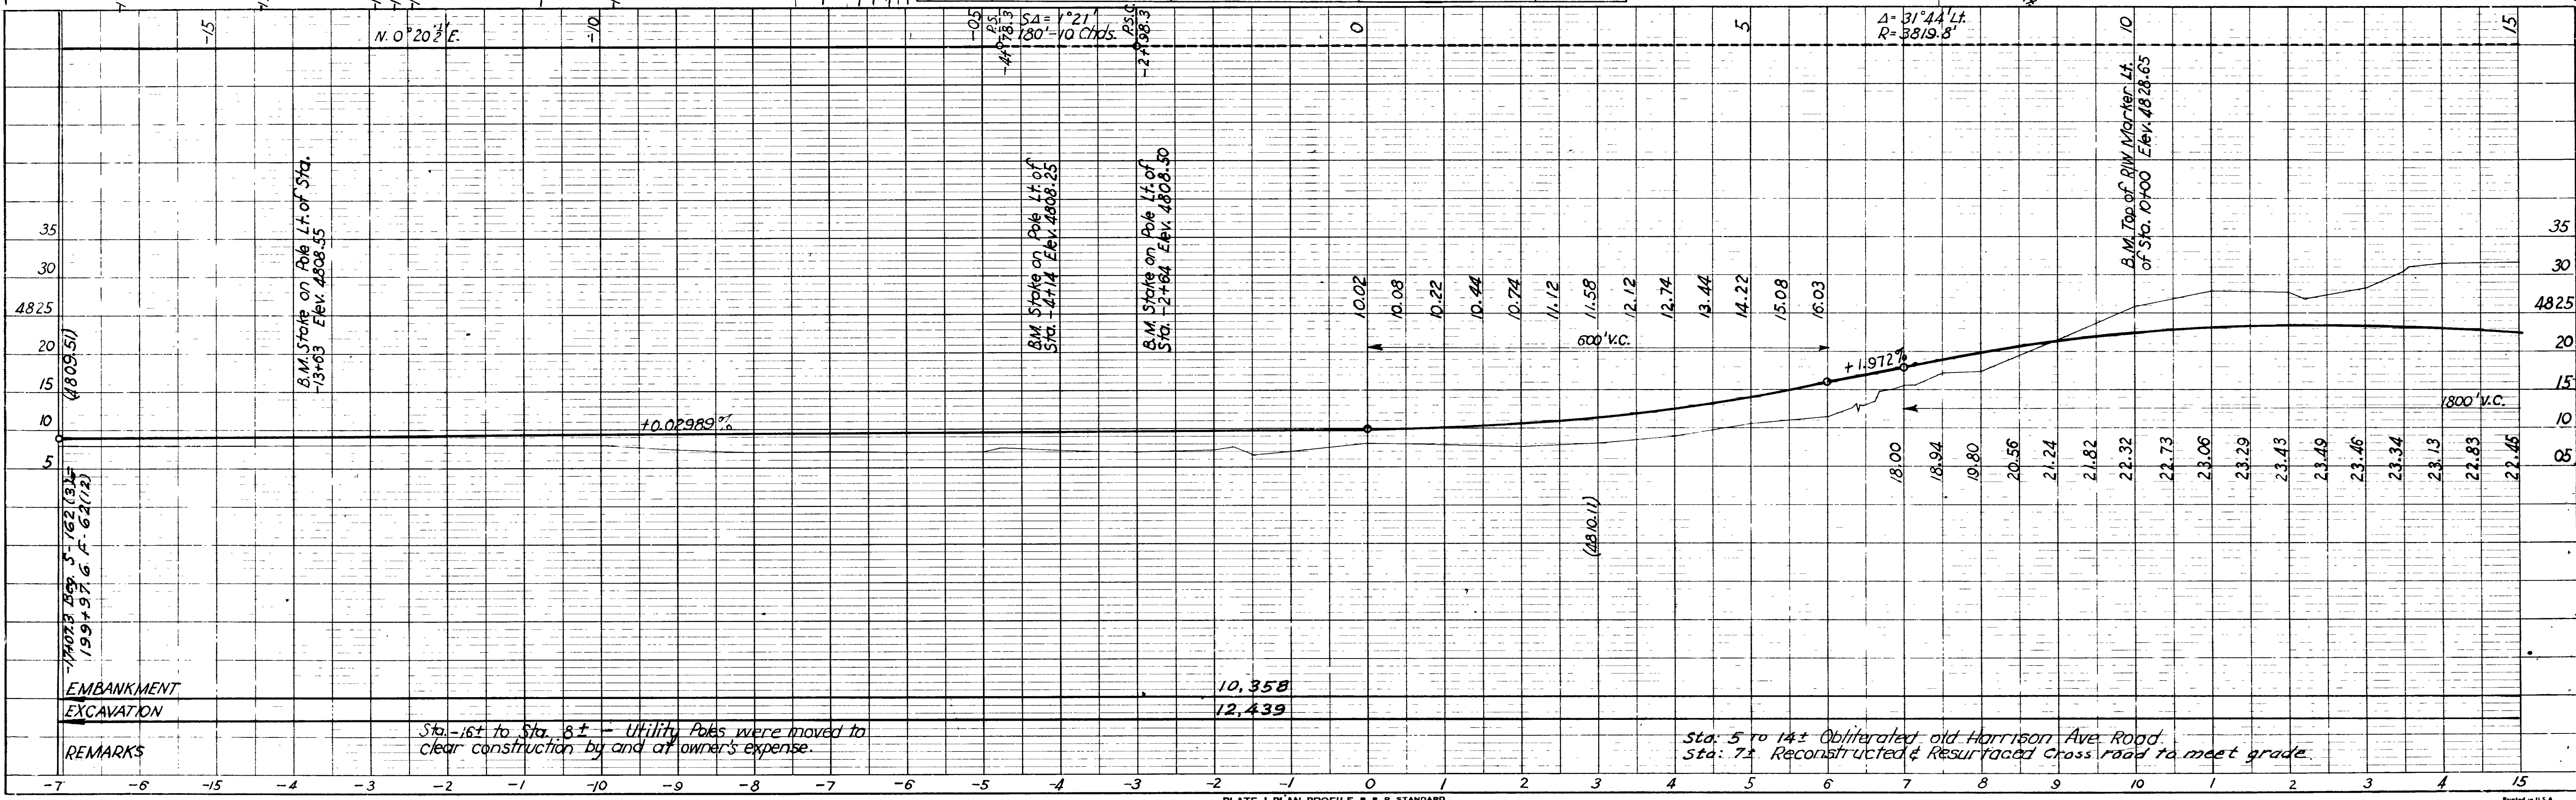


Sta. -16± to Sta. 8± - Utility Poles were moved to clear construction by and at owner's expense.

Sta. 5 to 14± Obliterated old Harrison Ave. Road
 Sta. 7± Reconstructed & Resurfaced Cross road to meet grade.


PLAN	DATE
SURVEY	BY
NOTED	BY
ALIGNED	BY
CHECKED	BY
RT. OF WAY	BY
TRACKED	BY
NO.	1943

PROFILE	DATE
SURVEY	BY
NOTED	BY
GRADES	BY
CHECKED	BY
S. M. S. NOTED	BY
STRUCTURE INDICATING CHRG.	BY
NO.	1943

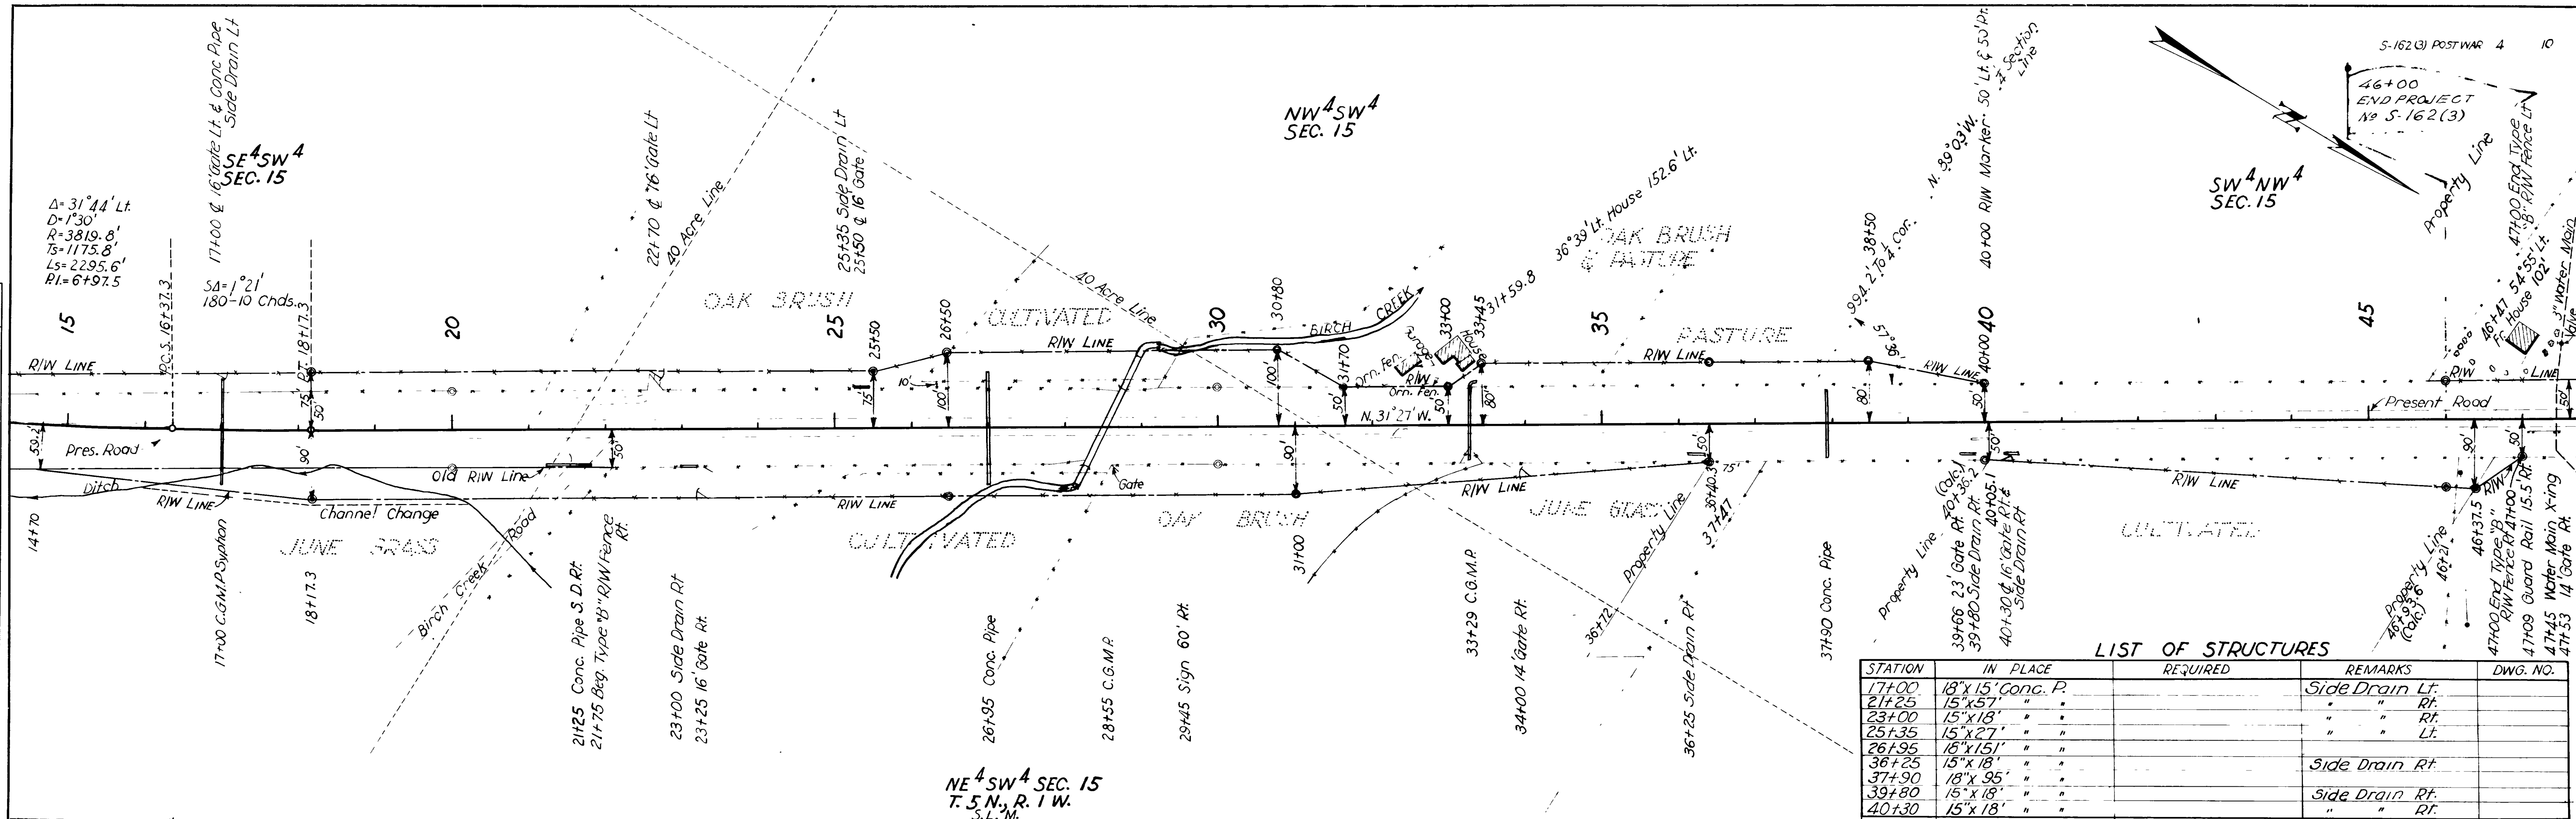


LIST OF STRUCTURES


STATION	IN PLACE	REQUIRED	REMARKS	DWG. NO.
17+00	18" x 15' Conc. P.		Side Drain Lt.	
21+25	15" x 57' "		" " Rt.	
23+00	15" x 18' "		" " Rt.	
25+35	15" x 27' "		" " Lt.	
36+25	15" x 18' "		Side Drain Rt.	
37+90	18" x 95' "		" " "	
39+80	15" x 18' "		Side Drain Rt.	
40+30	15" x 18' "		" " Rt.	
17+00	18" x 143' C.G.M.P. Syphon		Soldered Joints	V-411
28+55	12" x 18' C.G.M.P. 7' x 40' C.G.M.P. Elbow			
33+29	42" x 96' " 42" x 4' "			
21+56-4+00	2187' R/W Fence Rt		Type "B"	M-46

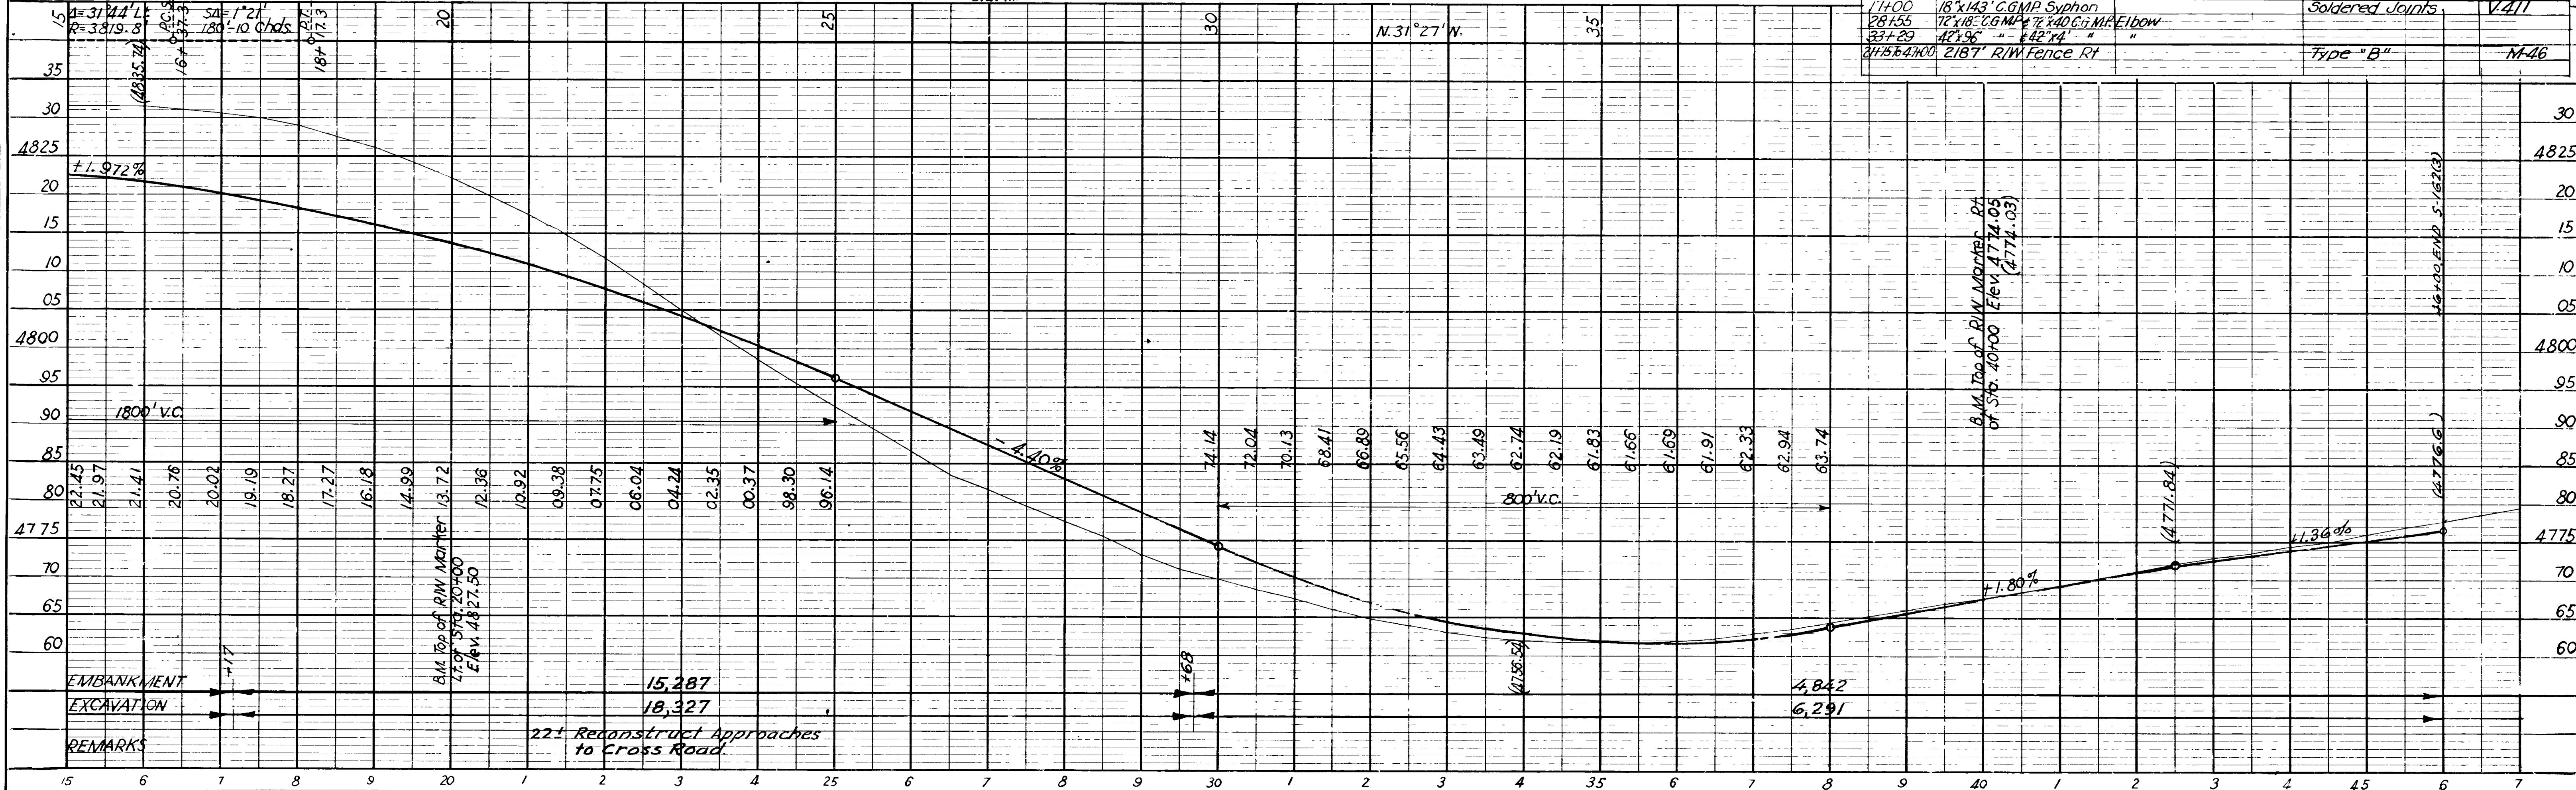


FED. ROAD DIST. NO.	STATE	PROJ. NO.	FILE NO.	SHEET NO.	TOTAL SHEETS
UT.	UTAH	F-62 (12)	POSTWAR	12	17
UT.	UTAH	S-162 (3)	POST WAR	4A	10

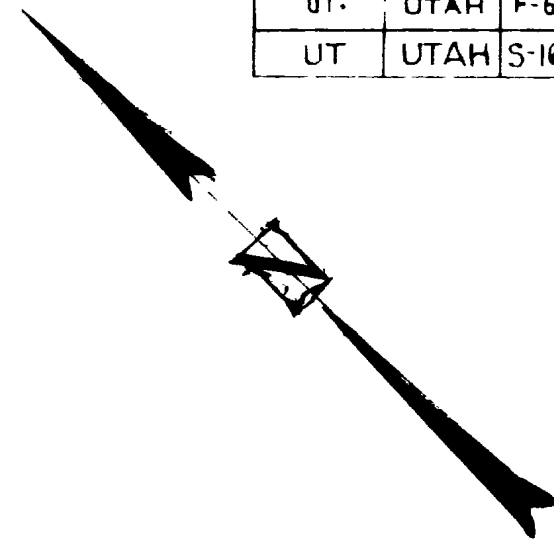

NO.	DATE	DESCRIPTION
1		
2		
3		
4		
5		
6		
7		
8		
9		
10		

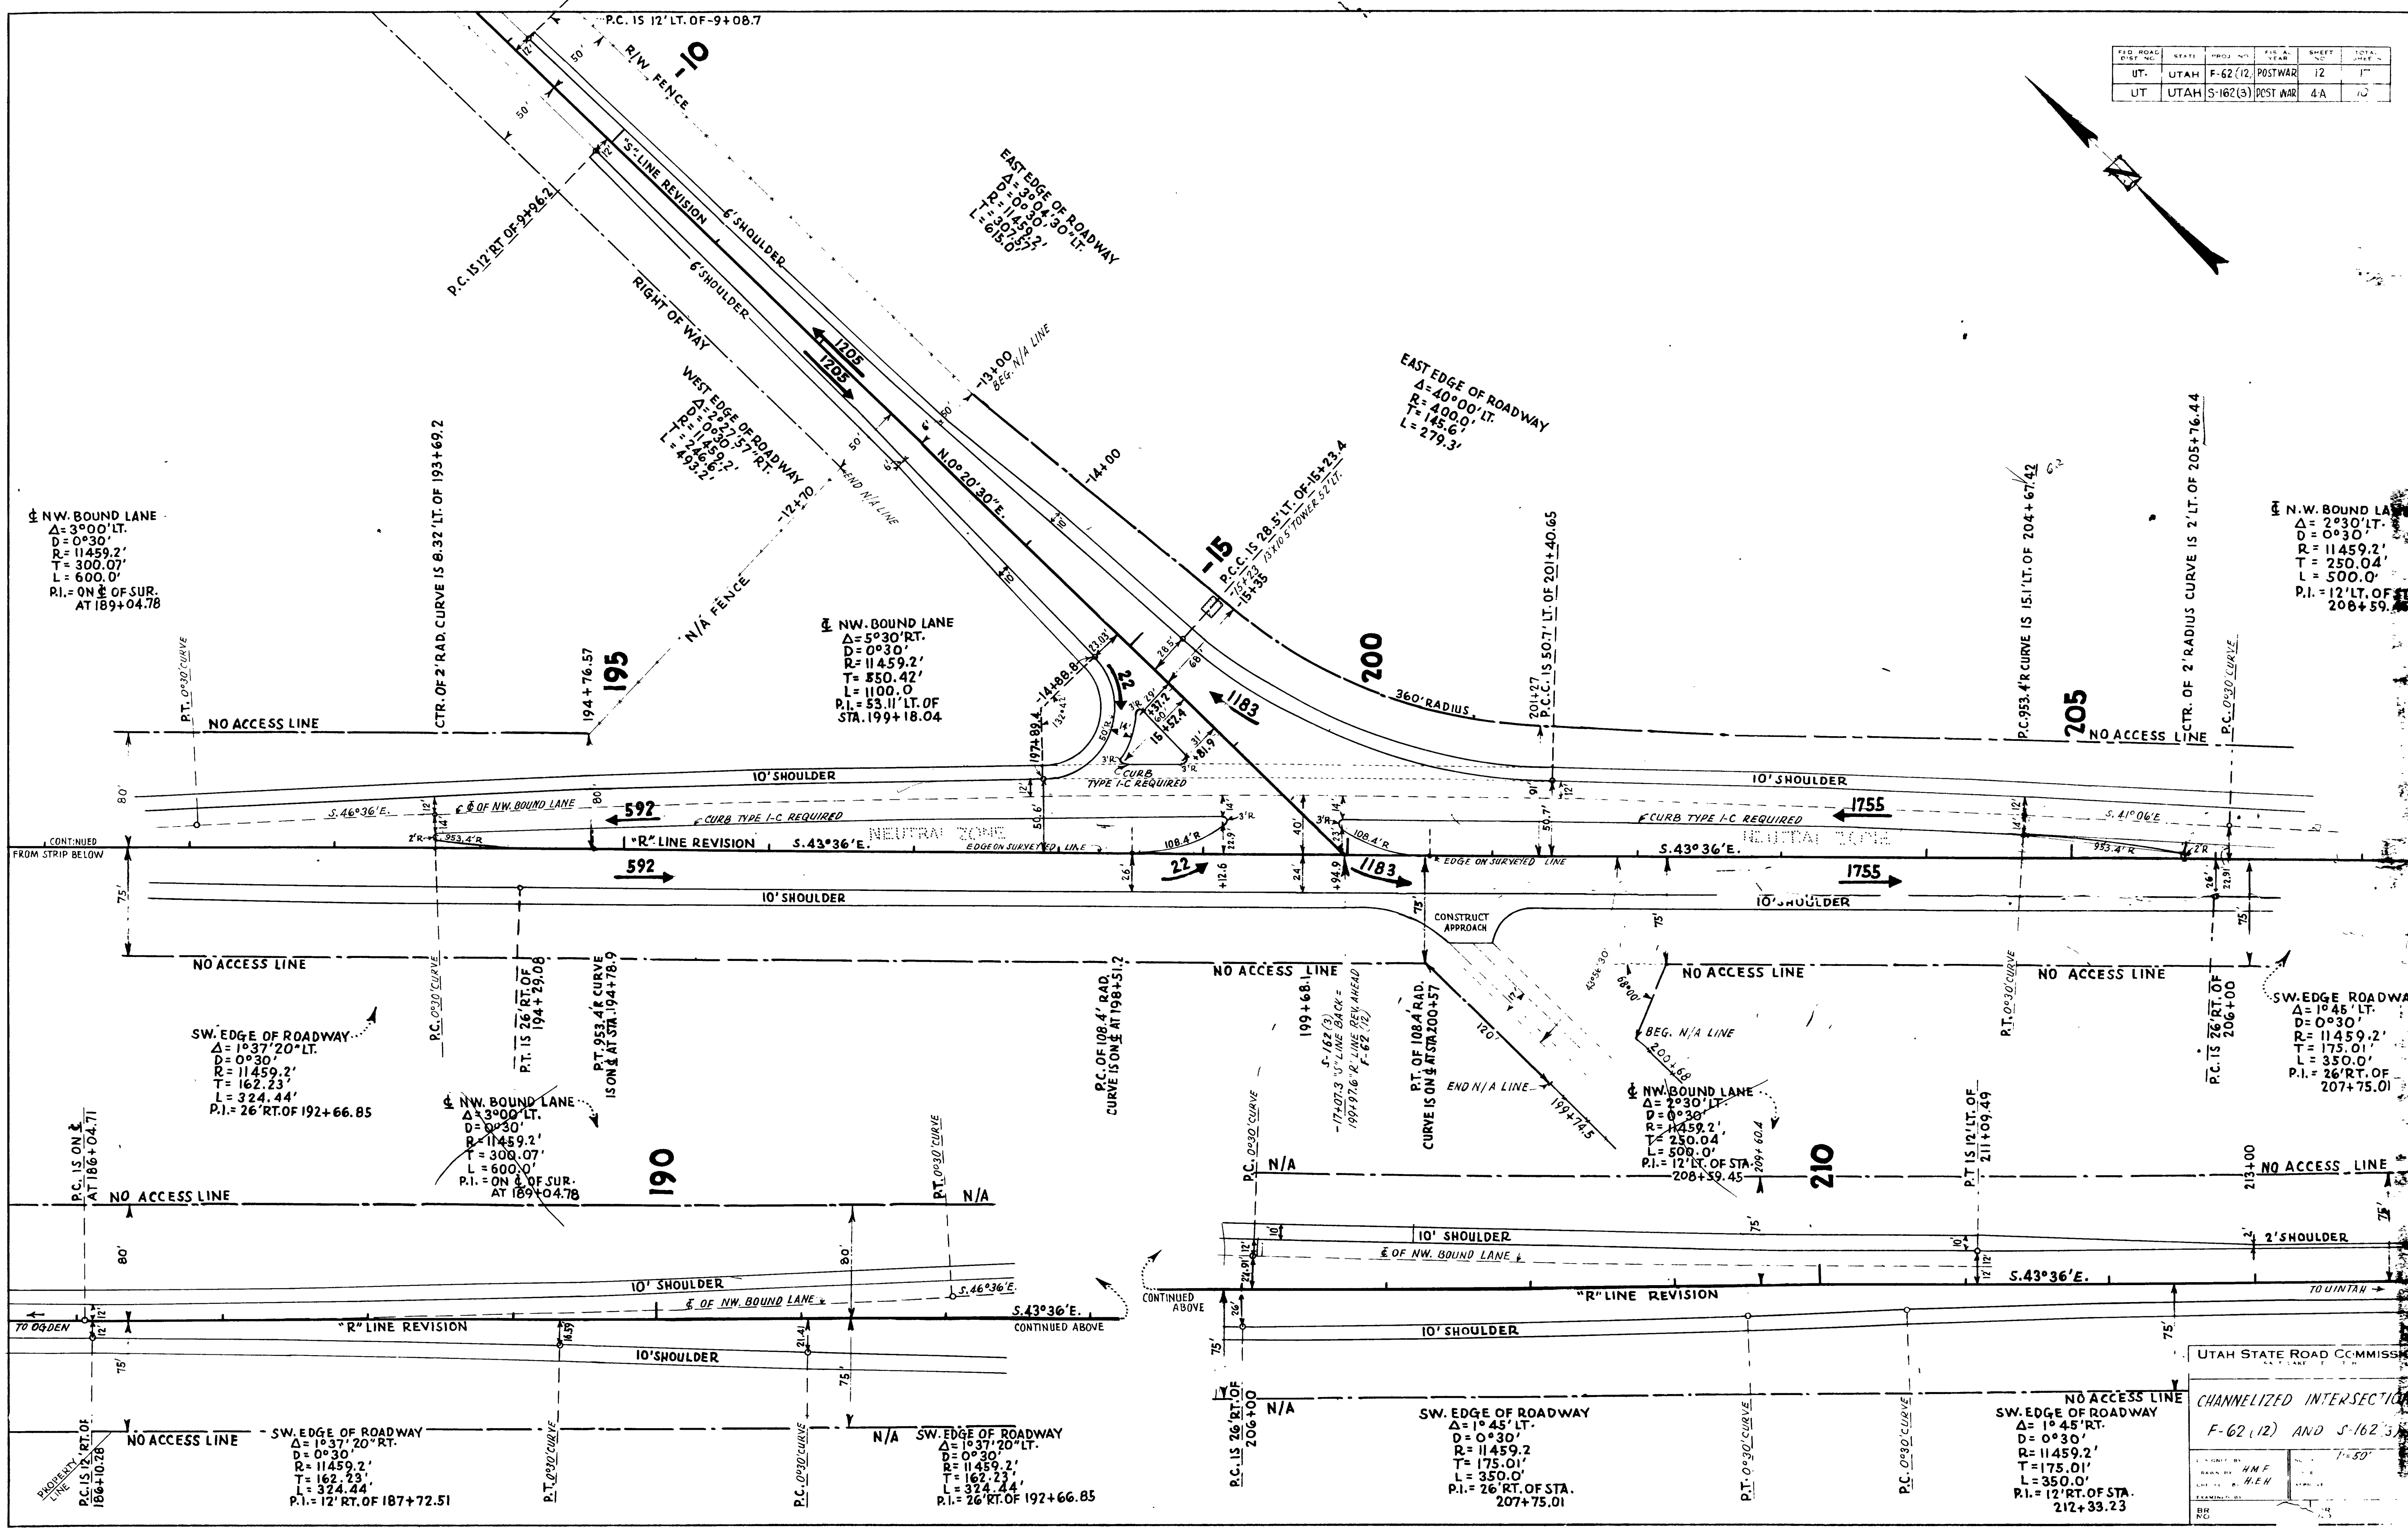

UTAH STATE ROAD COMMISSION
 CHANNELIZED INTERSECTION
 F-62 (12) AND S-162 (3)
 1"=50'

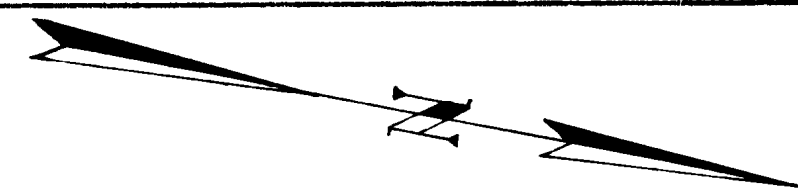

PLAN	SURVEYED	DATE
NOTE BOOK	ALIGNED CHECKED	
NO. 5123	RT. OF WAY CHECKED	
	PLACED	
	BY J. D. FARRINGTON	

PROFILE	SURVEYED	DATE
NOTE BOOK	GRADES CHECKED	
NO. 5123	B. M.'S. NOTED	
	STRUCTURE NOTATION CHKD.	
	BY J. D. FARRINGTON	

