

Route 59

Updated: November 2011

Hurricane via Big Plain Junction to Arizona State line, 1914. Shortened to Big Plain Junction in 1927 and re-extended to Arizona State line May 13, 1941.

1953 Description:

From Hurricane on Route 17 southeasterly via Big Plain Junction to the Utah-Arizona State line.
**(*A) Scanned)

1963 Description:

This route was reversed and **approved by the Legislature.**

From the Utah-Arizona State line northwesterly to Hurricane on Route 17.

Approved by the 1963 Legislature:

Approved by the 1965 Legislature:

1967 Legislature:

1983 Legislature: Description remains the same.

1985 Legislature: Description remains the same.

1986 Legislature: Description remains the same.

1987 Legislature: Description remains the same.

1988 Legislature: Description remains the same.

1990 Legislature: Description remains the same.

1992 Legislature: Description remains the same.

1993 Legislature: Description remains the same.

1994 Legislature: Description remains the same.

1995 Legislative Description:

From the Utah-Arizona state line northwesterly to Route 9 in Hurricane.

1996 Legislature: Description remains the same.

1997 Legislature: Description remains the same.

1998 Legislature: Description remains the same.

1999 Legislature: Description remains the same.

2000 Legislature: Description remains the same.

2001 Legislature: Description remains the same.

2002 Legislature: Description remains the same.

2003 Legislature: Description remains the same.

2004 Legislature: Description remains the same.

2005 Legislature: Description remains the same.

2006 Legislature: Description remains the same.

2007 Legislature: Description remains the same.

2008 Legislature: Description remains the same.

2011 Legislature: Description remains the same.

* Refers to resolution index page following

**Refers to Scanned Computer Resolution index on following page.

Route 59

COUNTY/VOLUME & RESOLUTION NO.

A. Washington Co. 1/58

DESCRIPTION OF RESOLUTION CHANGE

(A). Relocation/New Alignment -

Route description reversed by legislature.
New alignment from Arizona-Utah state line
to Hurricane.

RECOMMENDED CHANGE IN STATE ROUTE SYSTEM


State Route 59

Whereas:

The construction of projects S-0410 from Hurricane southeasterly, to the Arizona State line near Short Creek has resulted in a complete realignment of this road. It has been requested by the Washington County Commission, and recommended by Mr. Earl Johnson, District Engineer, that the portion of roadway on the old alignment of State Route 59 from Hurricane southeasterly to Big Plain Junction be transferred to the Washington County road system.

THEREFORE, BE IT RESOLVED that the relocation of State Route 59 from Hurricane southeasterly, to the Arizona State line near Short Creek be added as an interim designation, subject to the approval of the legislature, and the old portion of this road from Hurricane southeasterly to Big Plain Junction be transferred to the jurisdiction of Washington County. It is anticipated that the remaining section of the old alignment from Big Plain Junction to the Arizona State line will be abandoned, and no mileage will be credited to Washington County for this section.

Approved 3/12/62

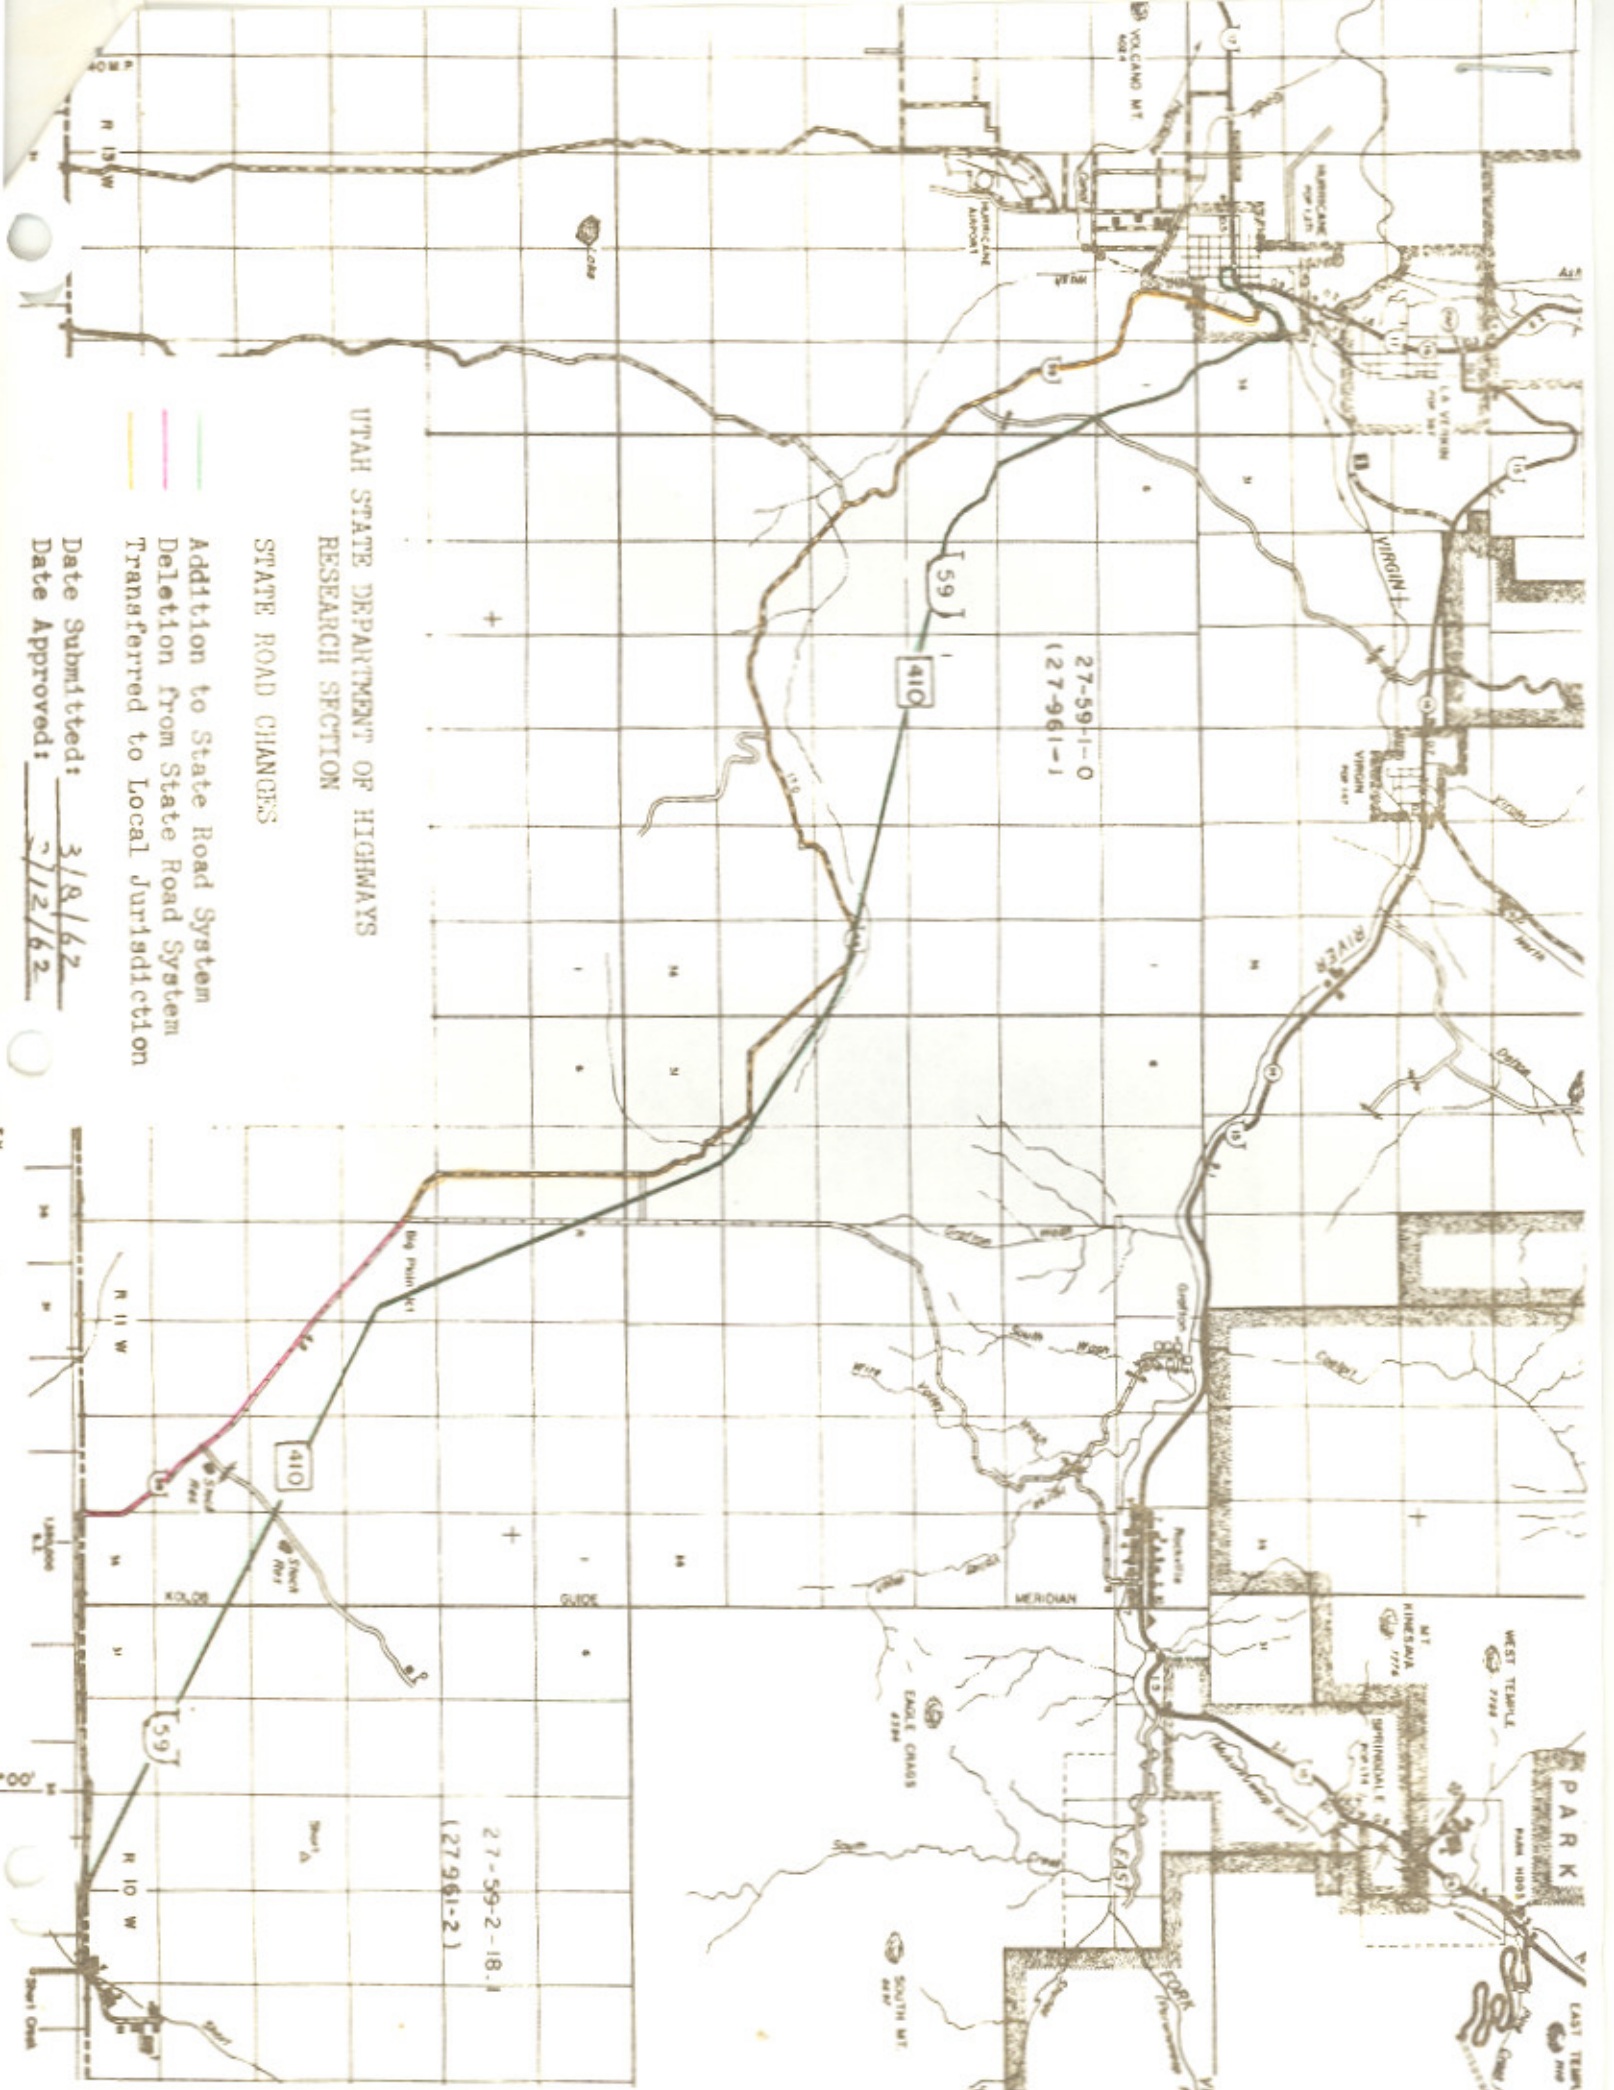

UTAH STATE DEPARTMENT OF HIGHWAYS
RESEARCH SECTION

STATE ROAD CHANGES

- Addition to State Road System
- Deletion from State Road System
- Transferred to Local Jurisdiction

Date Submitted: 3/8/62
Date Approved: 3/12/62

TY