

Route 183

Updated: December 2011

State Industrial School on Route 1 in Ogden, May 14, 1935. Description change 1953.

1953 Description:

State Industrial School on Route 235 in Ogden.

Approved by 1963 Legislature:

1965 Description:

From Route 235 to the State Industrial School in Ogden.

Approved by the 1965 Legislature:

1967 Legislature:

1969 Legislature:

Withdrawn as a State Route by the **1969 Legislature**. (Re-designated SR-286).

Forms 1, 2. Interim Designation and Deletion of
Federal-aid State Highways

Authority: Sec. 27-12-27, UCA 1953, as amended.

RESOLUTION

State Route 183-A

State Route 205

WHEREAS, Ogden City has requested the State Road Commission to place 12th Street in Ogden City, Weber County (from Washington Avenue easterly to Harrison Boulevard), on the State Highway System in exchange for the deletion of 7th Street (State Route 183-A) in Ogden City from the State Highway System; and

WHEREAS, such addition and deletion will comply with the minimum qualifying standards for such action as established by the State Road Commission; and

WHEREAS, such addition and deletion is felt to be in the best interest of the traveling public and the State of Utah;

NOW THEREFORE, pursuant to the authority of Sec. 27-12-27, UCA 1953, as amended, it is hereby resolved as follows:

1. That State Route 183-A (7th Street, Ogden, Utah) be deleted from the State Highway System, and jurisdiction thereover relinquished to Ogden City.
2. That 12th Street in Ogden City, from Washington Avenue (State Route 1) easterly to a connection with State Route 203 on Harrison Boulevard, be placed upon the State Highway System and designated as State Route 205.
3. That this action of addition and deletion to the State Highway System is interim only and direction is

herewith made that same be submitted to the next regular session of the State Legislature for approval or disapproval.

- 4. That as a result of this action the mileage on the State Highway System does not increase or decrease because this is a transfer of road mileage of the same length.
- 5. That Exhibit "A" attached herewith, illustrating the action taken herewith, is hereby incorporated as a part of this Resolution.

Dated this 2nd day of August, 1963.

STATE ROAD COMMISSION OF UTAH

Orrest W. Saffel
Chairman

Frank E. Todd
Commissioner


W. J. Smith
Commissioner

Amos K. Bagley
Commissioner

Elias Strong
Commissioner

ATTEST:

Clarence Alfred
Secretary

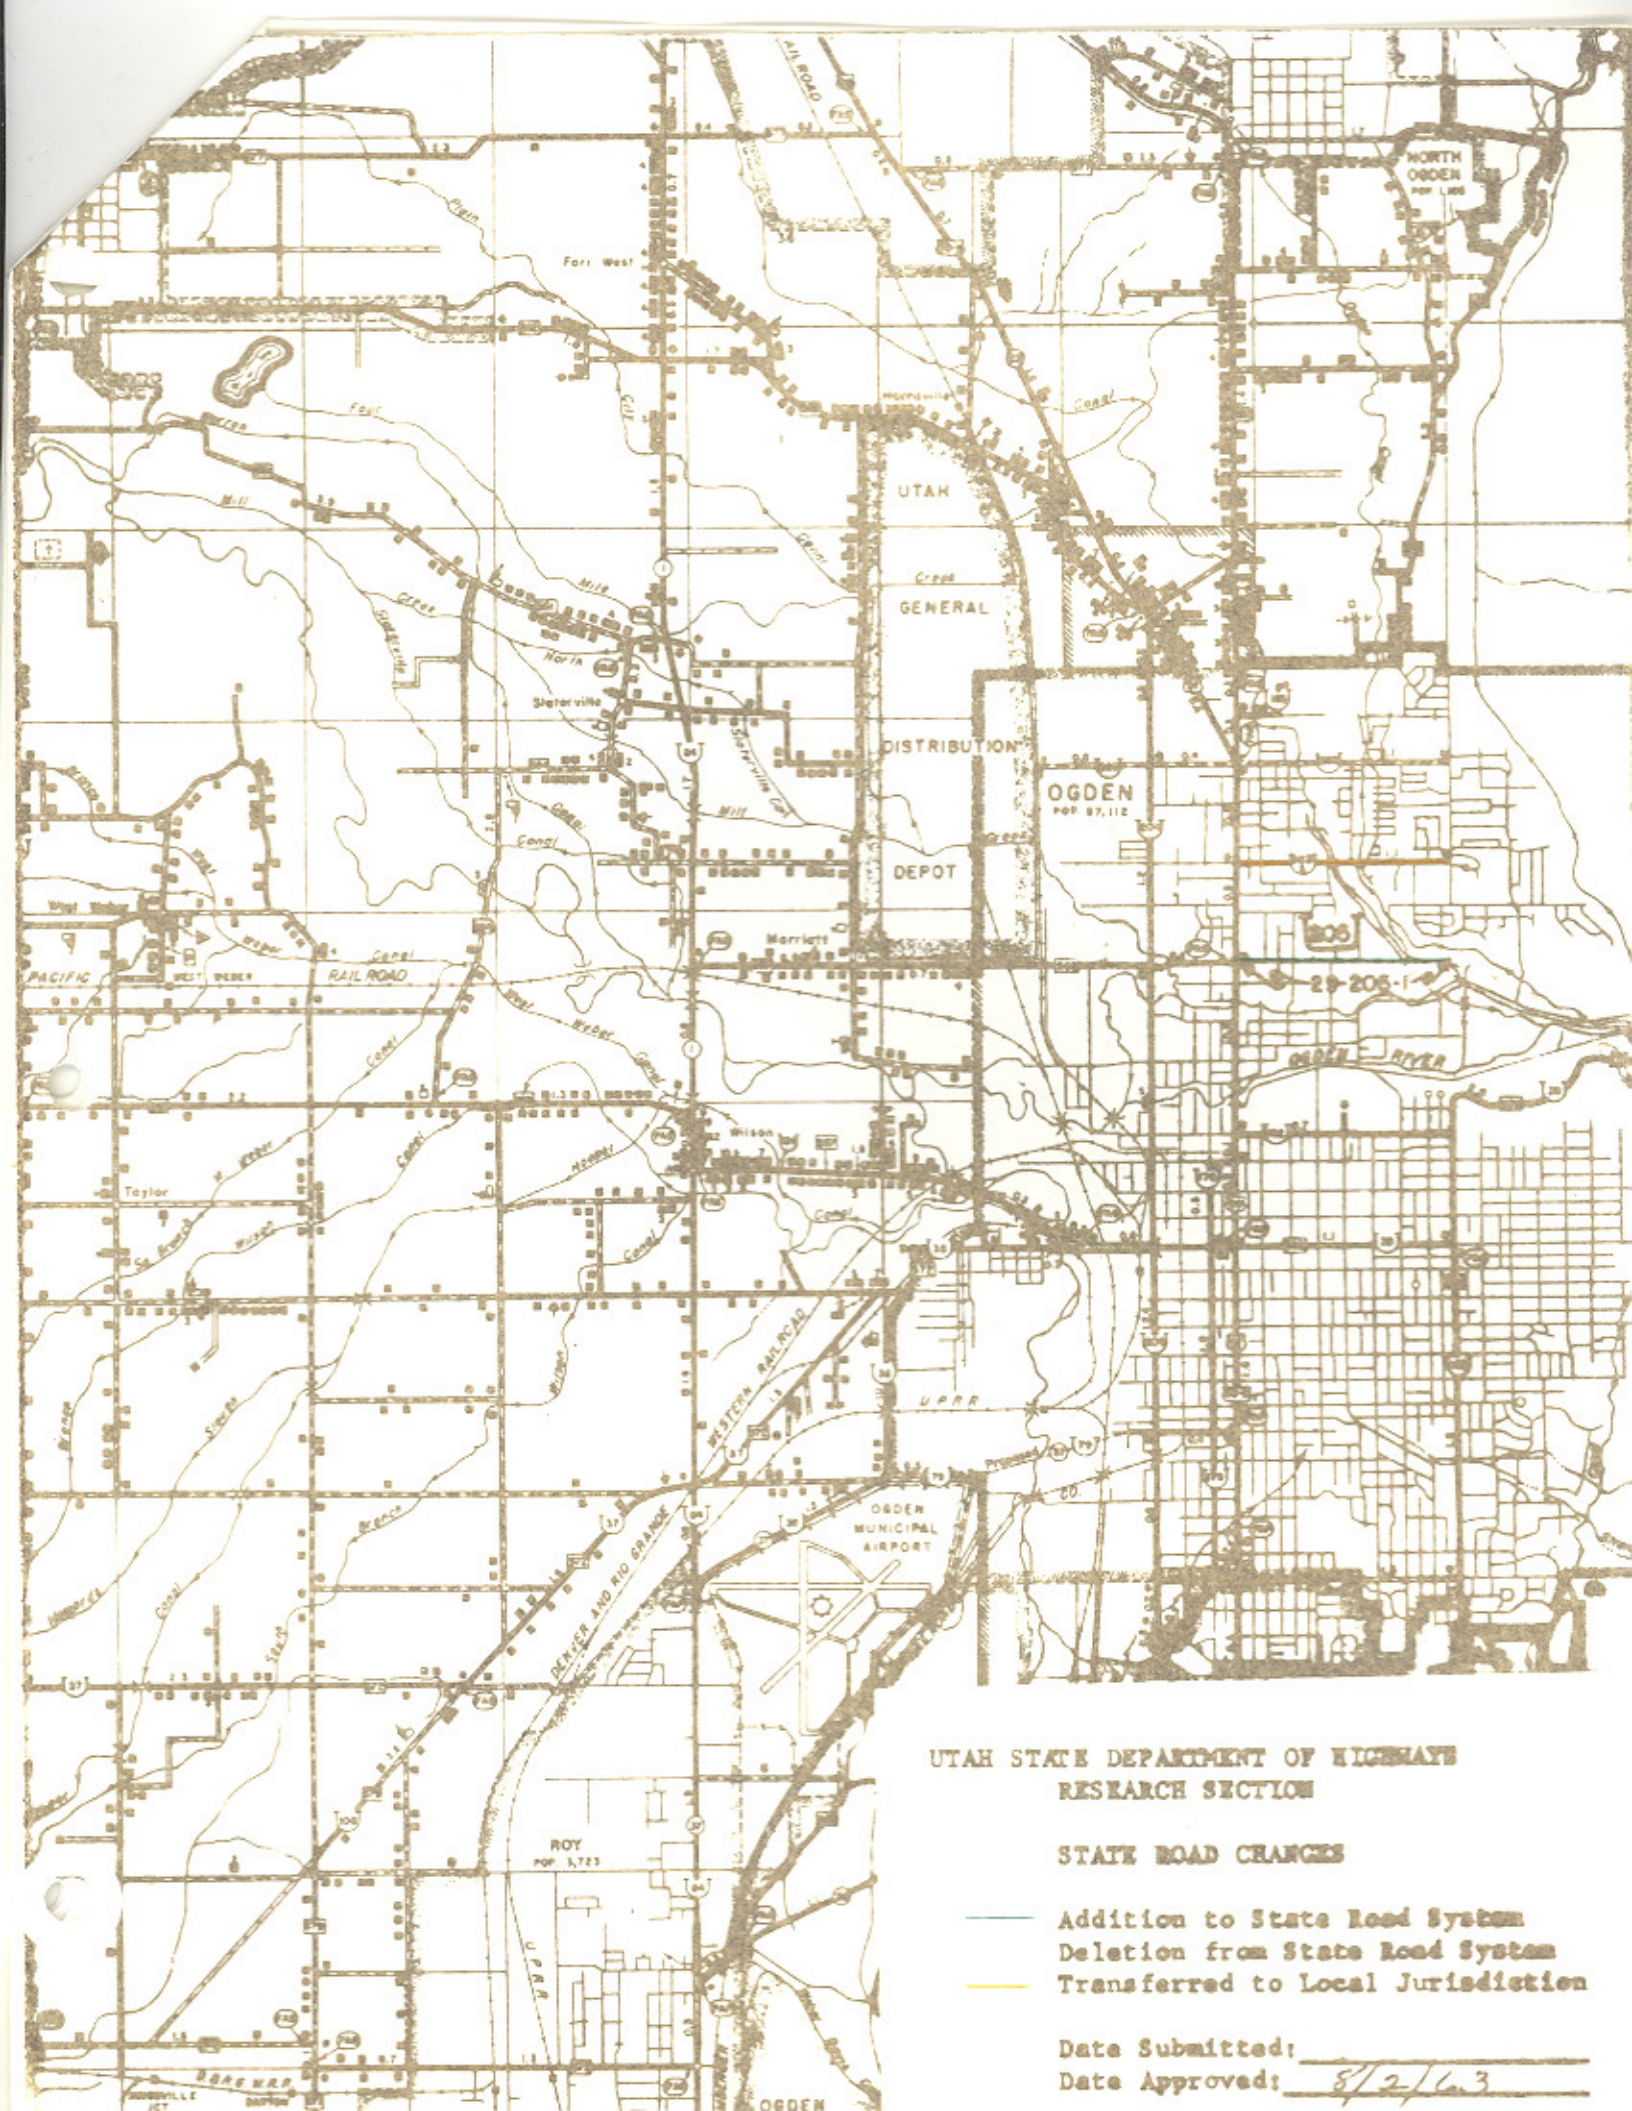

UTAH STATE DEPARTMENT OF HIGHWAYS
RESEARCH SECTION

STATE ROAD CHANGES

- Addition to State Road System
- Deletion from State Road System
- Transferred to Local Jurisdiction

Date Submitted: _____
Date Approved: 8/2/63