

## **Route 234**

*Updated: December 2011*

Junction with Route 1.in Payson south and west, to Route 1, 1910 in original designation of Route 1.

### 1953 Description:

From Route 1 in Payson south, via Main Street to Eighth South Street; thence north via Main Street to Route 1. This route was **approved by the Legislature.**

### 1965 Description:

From Route 26 in Payson east via Eighth South Street; thence north via Main Street to Route 26.

### **Approved by the 1965 Legislature:**

### **1967 Legislature:**

\* (A) Commission Action August 15, 1968:  
***Withdrawn*** as a State Route.

\* Refers to resolution index page following.

## **Route 234**

### **COUNTY/VOLUME & RESOLUTION NUMBER**

A. Utah Co. 2/44

### **DESCRIPTION OF RESOLUTION CHANGE**

(A). Deleted -

SR-234 deleted from the State System of Highways  
in its entirety.

Interim Designation and Deletion of Federal-aid Highways  
Authority: Sec. 27-12-27, UCA, 1953, as amended

R E S O L U T I O N

State Route 234

25 234-1

31  
234  
44

WHEREAS, it has been requested by the Payson City Corporation that State Route 234 in Payson be transferred to the jurisdiction of Payson City upon the completion of certain resurfacing work and installation of street lighting along the subject highway and,

WHEREAS, Mr. Edwin E. Lovelace, District Engineer, concurs with the Payson City request of transfer and indicates that there is already special authority approved for the resurfacing and lighting of the subject highway.

NOW THEREFORE, pursuant to the Authority of Sec. 27-12-27, UCA, 1953, as amended is hereby resolved as follows:

1. That State Route 234 in its entirety be deleted from the State System of Highways.

2. That this action becomes effective upon the completion of the following improvements on the subject highway:

- 1- Installation of Street lighting from U.S. 91 South to 800 South, thence West to U.S. 91 - (Under a street lighting agreement).
- 2- Resurfacing (Main Street from U.S. 91 South to 800 South, thence West to U.S. 91).
- 3- Make improvements (Change at intersection - 800 South and Main).

3. That by this action State Highway System mileage will decrease 1.1 + - miles and Payson City "C" mileage will increase 1.1 + - miles.

4. That the letter from the Payson City Corporation relating their desires concerning the aforementioned transfer of State Route 234, is hereby

incorporated as a part of this submission.

5. That the map illustrating the action taken herewith is hereby incorporated as a part of this submission.

Dated this 12<sup>th</sup> day of August, 1968.

STATE ROAD COMMISSION OF UTAH

*Newton S. Hamill*  
Chairman

*Paul H. [unclear]*  
Commissioner

*Frank [unclear]*  
Commissioner

*Henry H. [unclear]*  
Commissioner

*B. LaFawn Cox*  
Commissioner


ATTEST:

*Robert G. Moxieken*  
acting Secretary

UTAH STATE DEPARTMENT OF HIGHWAYS  
Systems Planning Division

STATE ROAD CHANGES  
UTAH COUNTY

Addition to State Road System  
Deletion from State Road System  
Transferred to Local Jurisdiction

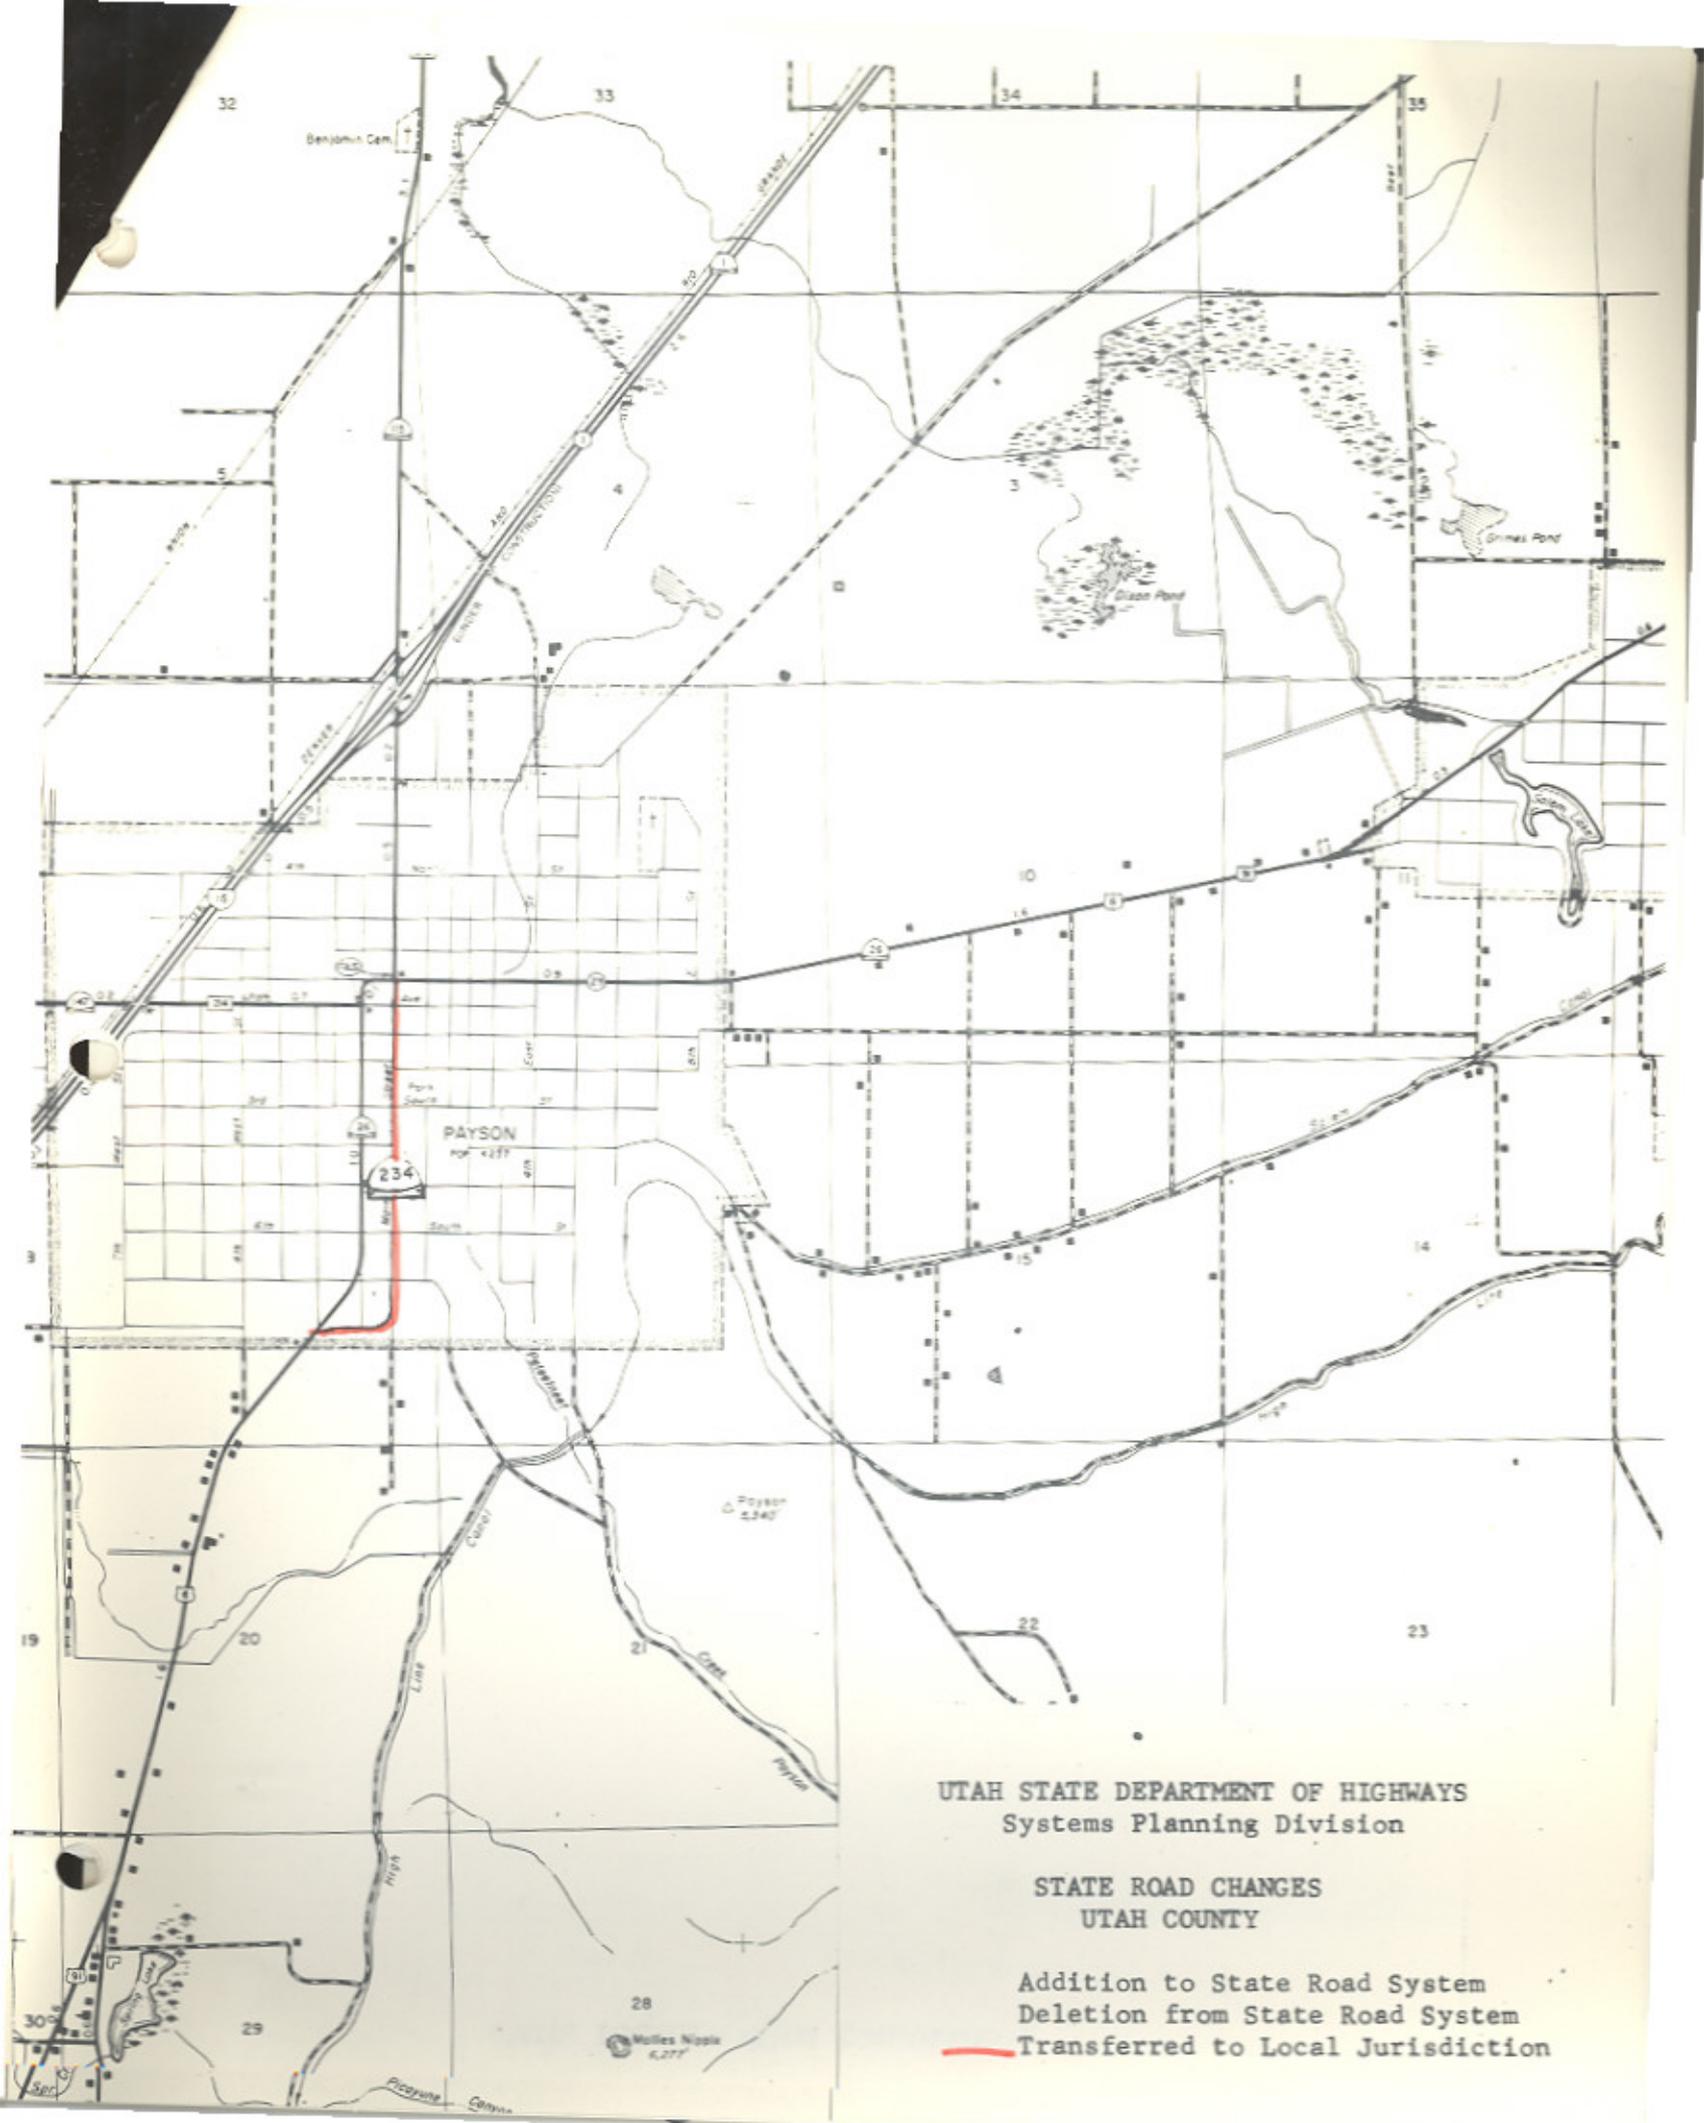

UTAH STATE DEPARTMENT OF HIGHWAYS  
Systems Planning Division

STATE ROAD CHANGES  
UTAH COUNTY

- Addition to State Road System
- Deletion from State Road System
- Transferred to Local Jurisdiction

# Memorandum

UTAH STATE DEPARTMENT OF HIGHWAYS

DATE: July 11, 1968

TO : Blaine J. Kay, State Highway Engineer

FROM : Edwin E. Lovelace, District Six Engineer *EEL*

SUBJECT: State Road 234 - Payson City Main Street

Attached is copy of letter from Payson City Corporation wherein they state that they will take over present SR-234 as a City street, when the work in which we are contemplating is completed. As you are aware, there is already a Special Authority approved for the resurfacing and improvements as noted under Numbers 2 and 3 of the letter. Also a street lighting agreement as mentioned in Number 1, has been approved or will be approved shortly.

Therefore we will continue to work with Payson City to accomplish these three items, and upon completion will prepare the necessary papers to turn the highway over to Payson City.

EELovelace/jcw  
attachment:

cc: D. L. Sargent  
Jim West  
Howard Leatham  
Dale Burningham  
Willard Kemp  
Maurice Roche



*Edwin E. Lovelace*  
*Blaine J. Kay*  
*Willard Kemp*  
*Maurice Roche*

"safe today - alive tomorrow"

MEMBERS  
LAWRENCE EWELL  
BERNON FINCH  
BRYCE H. JONES  
HOWARD RILEY  
D. ROY ROGERS

LaMAR LOSSER, Mayor

EDWARD H. BATES, Recorder  
VIONE E. REECE, Treasurer  
AMMON LANCE, Marshal  
DR. J. B. HOGAN, Physician  
DON J. MCCOY, Justice of Peace  
DAVE McMULLIN, Attorney

STATE OF UTAH

# PAYSON CITY CORPORATION

P. O. Box 188  
PAYSON, UTAH - 84651  
June 21, 1968

Utah State Department of Highways  
District #6 Engineers Office  
825 North 900 West  
Orem, Utah

Att: Edwin E. Lovelace  
District Engineer

Dear Sir:

At the regular meeting of the Payson City Council held on June 17, 1968 the Council approved acquiring from the Utah State Department of Highways SR 234.

(Payson Mainstreet- South from U.S. 91 to 800 South thence West to U.S. 91)

Acceptance of S.R. 234 as a Payson City Street subject to completion of the following improvements: by the State.

- 1- Installation of Street lighting from U.S. 91 South to 800 South Thence West to U.S. 91-( Under a street lighting agreement)
- 2-Resurfacing ( Main Street from U.S. 91 South to 800 South thence West to U.S. 91.
- 3- Make improvements ( Change at intersection- 800 South and Main)

Yours Truly,

LaMar Losser

Mayor of Payson City

COUNCILMEN

ATTEST: Edward H. Bates

UTAH STATE DEPARTMENT OF HIGHWAYS

bc: Howard B. Leatham, Engineer for Planning & Programming

Same Letter sent to: Norm Hancock, Utah State Fish & Game Department

Resolution & Location

Maps sent to: Robert Kirby, B.P.R. Evelyn Crill Lillian Witkowski  
W. L. Anderson Charles Bertolina Garn Henderson  
Bruce Fjeldsted Robin Hood Maurice Richey  
Keith Rosevear Harold Brown Wallace J. Liddle  
Ken Riddle David Greenwood David Sargent  
Ralph Murdock Lucy Ann Bean Eva McEwan  
Janiel Little Edwin E. Lovelace Alex Mansour  
John Homer Porter M. Gooch Ezra Christensen  
Dean R. Steed James Booth E. Paul Gilgen  
Chauncey Powis Robert Walsh Jim West  
Ellen Wandell  
Don Jensen

August 23, 1968

C  
O  
P  
Y  
The Honorable LaMar Losser  
Mayor of Payson City  
Payson City Corporation  
P.O. Box 188  
Payson, Utah 84651

Dear Mayor Losser:

Subject: Transfer of a State Route to Local Jurisdiction  
in Payson City

Effective August 15, 1968, the State Road Commission adopted a resolution to transfer State Route 234 in Payson City to local jurisdiction.

By this action Payson City "C" mileage will be increased 1.1 + - miles.

Attached is a copy of the resolution and a location map.

Very truly yours,

B. Dale Burningham  
Planning Statistics Supervisor

BDent:bt