

Route 268

Updated: December 2011

(A) Scanned) **Scanned) From a connection with FAI Route 15, easterly via Fifth North Street in Salt Lake City to Route 1. This route was **approved by the 1963 Legislature.**

1965 Description:

From Route 1 (Interstate Route 15) easterly via 5th North Street in Salt Lake City to Route 271.

Approved by the 1965 Legislature:

1967 Legislature:

1979 Legislature Description:

From Route 15 easterly on 600 North Street to Route 89 in Salt Lake City.

1981 Legislature: Description remains the same.

1983 Legislature: Description remains the same.

1985 Legislature: Description remains the same.

1986 Legislature: Description remains the same.

1987 Legislature: Description remains the same.

1988 Legislature: Description remains the same.

1990 Legislature: Description remains the same.

1992 Legislature: Description remains the same.

1993 Legislature: Description remains the same.

1994 Legislature: Description remains the same.

1995 Legislature: Description remains the same.

1996 Legislature: Description remains the same.

1997 Legislature: Description remains the same.

1998 Legislature: Description remains the same.

1999 Legislature: Description remains the same.

2000 Legislature: Description remains the same.

2001 Legislature: Description remains the same.

2002 Legislature: Description remains the same.

2003 Legislature: Description remains the same.

2004 Legislature: Description remains the same.

2005 Legislature: Description remains the same.

2006 Legislature: Description remains the same.

2007 Legislature: Description remains the same.

2008 Legislature: Description remains the same.

2011 Legislature: Description remains the same.

*Refers to resolution index page following.

** Refers to Scanned Computer Resolution index on the following page.

Route 268

COUNTY/VOLUME & RESOLUTION NUMBER

A. Salt Lake Co. 1/21

B. Salt Lake Co. 1/23

DESCRIPTION OF RESOLUTION CHANGE

(A). New Road -

From FAI-15 to Route 1.

(B). Addition -

FAP-32 addition to Route 268.

RECOMMENDED LEGISLATIVE CHANGES IN STATE ROAD SYSTEM


ROUTE 268

Previous Description: (new road)

Recommended Description: From a connection with F.A.I. route 15, easterly via Fifth North Street in Salt Lake City to route #1.

Comments: *Commission approval April 25, 1960.*
~~Recommended for Commission action.~~

DAVIS COUNTY

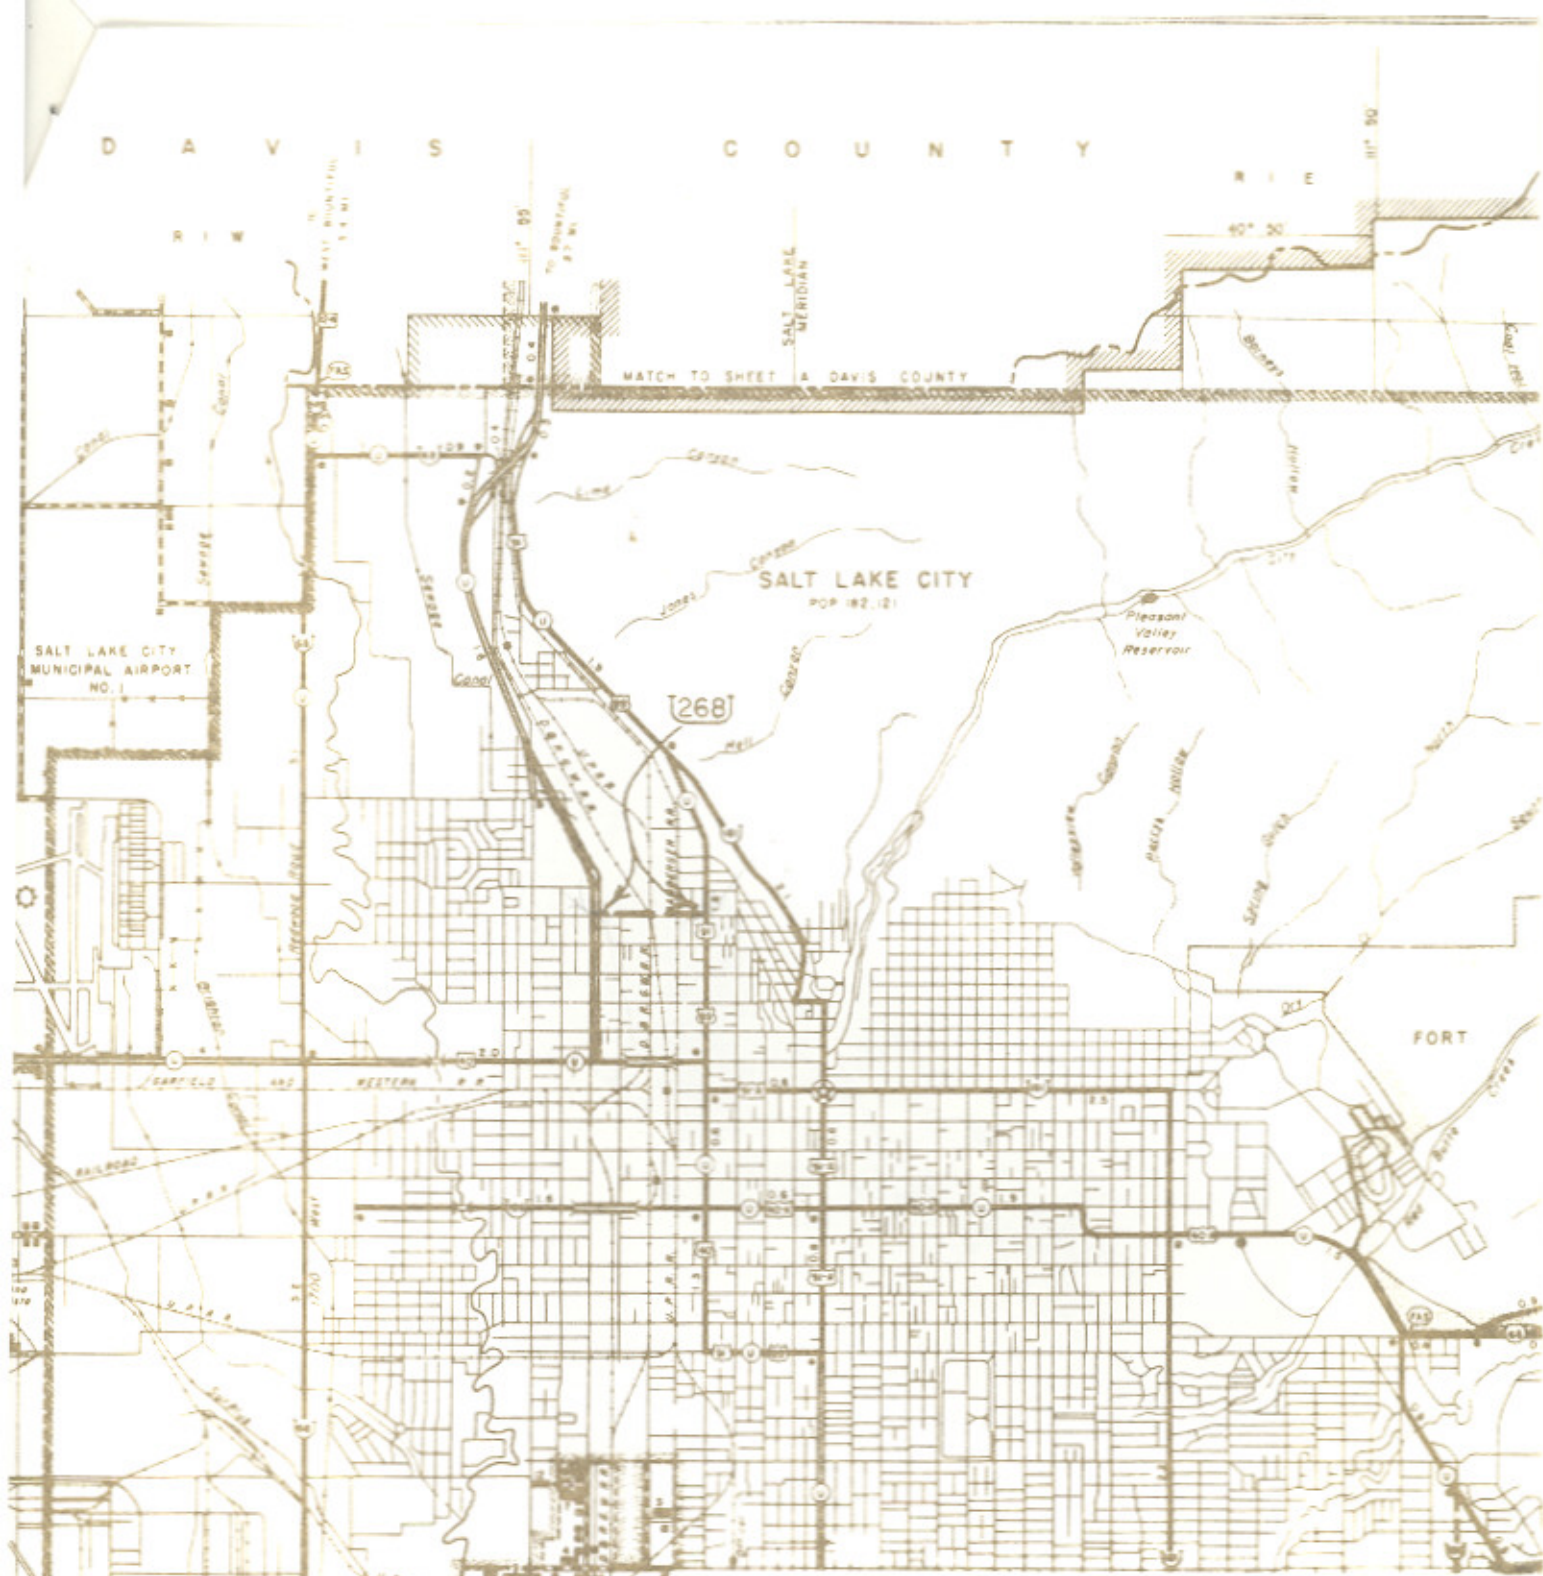

STATE ROAD COMMISSION OF UTAH
HIGHWAY RESEARCH DEPARTMENT
 Proposed State Road Changes
LEGEND

- Addition to State Road System
- Deletion from State Road System

Date: _____