

Route 295

Updated: December 2011

Those roads within Department of Motor Vehicle Driving Test Course 91200 West north of SR-52) *added* to State System by

*(A) Commission Action July 16, 1982.

1983 Legislature effective May 10, 1983: Description remains the same,

1985 Legislature: Description remains the same.

1986 Legislature: Description remains the same.

1987 Legislature: Description remains the same.

1988 Legislature: Description remains the same.

1990 Legislature: Description remains the same.

1992 Legislature: Description remains the same.

1993 Legislature: Description remains the same.

1994 Legislative Description:

Those roads used for drivers' tests at 1200 West in Orem City.

1995 Legislature: Description remains the same.

1996 Legislature: Description remains the same.

1997 Legislature: Description remains the same.

1998 Legislature: Description remains the same.

1999 Legislature: Description remains the same.

2000 Legislature: Description remains the same.

2001 Legislature: Description remains the same.

2002 Legislature: Description remains the same.

***(B) Commission Action December 12, 2003:**

Deleted as a State Road in its entirety.

2003 Legislature: Deleted from the State Highway System.

* Refers to resolution index page following.

Route 295

COUNTY/VOLUME & RESOLUTION NUMBER

A. Utah Co. 6/43

B. Utah Co.11/4

DESCRIPTION OF RESOLUTION CHANGE

(A). Addition -

Roadway within Driver License Facility in Orem.

(B). Deletion -

Removed from the State Highway System.

1

RESOLUTION

State Route ²⁹⁵~~299~~

WHEREAS, to clarify maintenance responsibility for those roads at the Department of Motor Vehicle Test Course ^{in Orem, Utah County} at ~~2780 West 4700 South in Salt Lake County~~ that are used for the purpose of a physical test for automotive drivers ability, and

WHEREAS, those roads that are to be used for driving tests have been coordinated with the Utah State Department of Public Safety, Drivers License Division and Mr. ^{L. R. Jester} William Hurley, District Director, and

WHEREAS, these roads are considered as a part of the State System of Highways.

NOW THEREFORE, be it resolved as follows:

1 That the roads at the Department of Motor Vehicle Test Course ^{in Orem, Utah County} at ~~2780 West 4700 South in Salt Lake County~~ that are used for the purpose of a physical test for automotive drivers ability are a part of the State Road System and be designated as State Route ²⁹⁵~~299~~,

2 That the parking areas be considered part of this route for maintenance responsibility,

3 That by this action State Highway System mileage will increase ^{0.75}~~1.0~~ + - mile,

4 That the map attached illustrating the action taken herewith be hereby incorporated as a part of this submission.

Dated this 11th day of February, 1977.

UTAH TRANSPORTATION COMMISSION

B. L. Durrant
Chairman

RESOLUTION
State Route 299
Page 2

W. J. ...
Vice-Chairman

Chas. E. ...
Commissioner

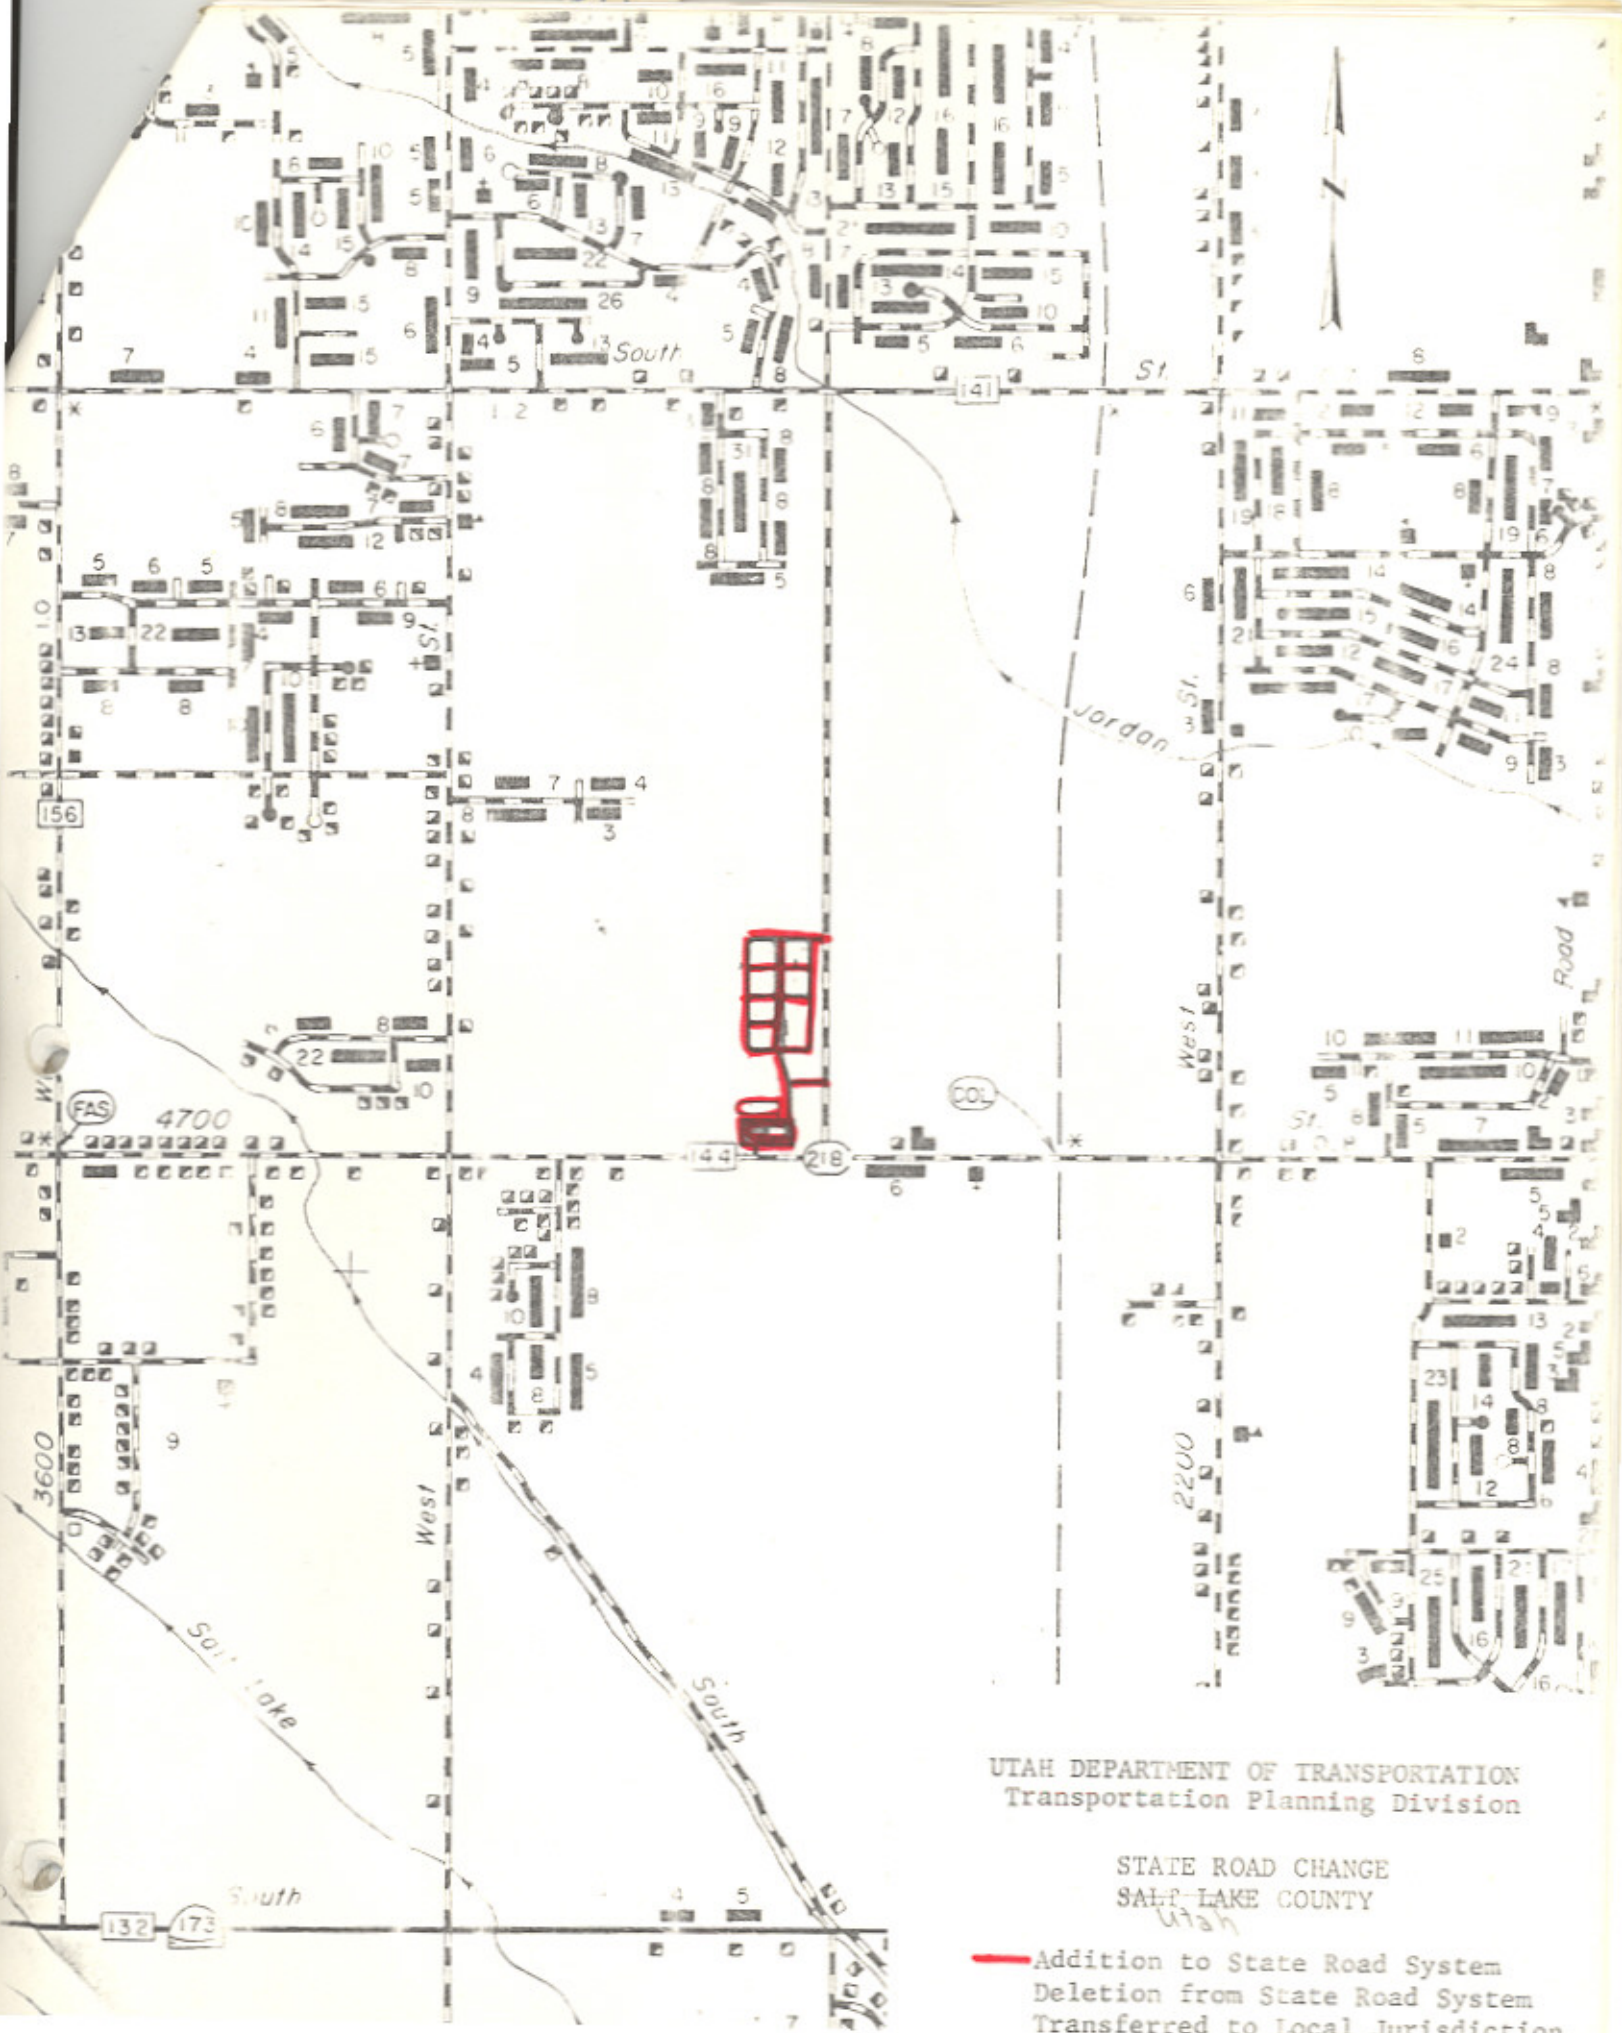
Samuel ...
Commissioner

Clayton ...
Commissioner

ATTEST:

Donald ...
Secretary

SR-299



UTAH DEPARTMENT OF TRANSPORTATION
 Transportation Planning Division

STATE ROAD CHANGE
 SALT LAKE COUNTY
 Utah

- Addition to State Road System
- Deletion from State Road System
- - - Transferred to Local Jurisdiction

SR-
199

Memorandum.

UTAH STATE DEPARTMENT OF HIGHWAYS

DATE: February 23, 1977

TO : Department of Transportation Personnel

FROM : L. R. Jester, P.E. *L.R.J.*
Engineer for Transportation Planning

SUBJECT: Addition of State Route 299 to the State System of Highways

On February 11, 1977, the Utah Transportation Commission approved those roads within the Motor Vehicle Test Course at 2780 West 4700 South in Salt Lake County as a part of the State System of Highways.

Attached is a copy of the resolution and a location map.

Attachment

SR-
299

R E S O L U T I O N

State Route 299

WHEREAS, to clarify maintenance responsibility for those roads at the Department of Motor Vehicle Test Course at 2780 West 4700 South in Salt Lake County that are used for the purpose of a physical test for automotive drivers ability, and

WHEREAS, those roads that are to be used for driving tests have been coordinated with the Utah State Department of Public Safety, Drivers License Division and Mr. William Hurley, District Director, and

WHEREAS, these roads are considered as a part of the State System of Highways.

NOW THEREFORE, be it resolved as follows:

That the roads at the Department of Motor Vehicle Test Course at 2780 West 4700 South in Salt Lake County that are used for the purpose of a physical test for automotive drivers ability are a part of the State Road System and be designated as State Route 299,

That the parking areas be considered part of this route for maintenance responsibility,

That by this action State Highway System mileage will increase 1.0 + - mile,

That the map attached illustrating the action taken herewith be hereby incorporated as a part of this submission.

Dated this 11th day of February, 1977.

UTAH TRANSPORTATION COMMISSION

B. LaPrun
Chairman

SR-
199

RESOLUTION
State Route 299
Page 2

Wm. J. ...
Vice-Chairman

Chas. E. ...
Commissioner

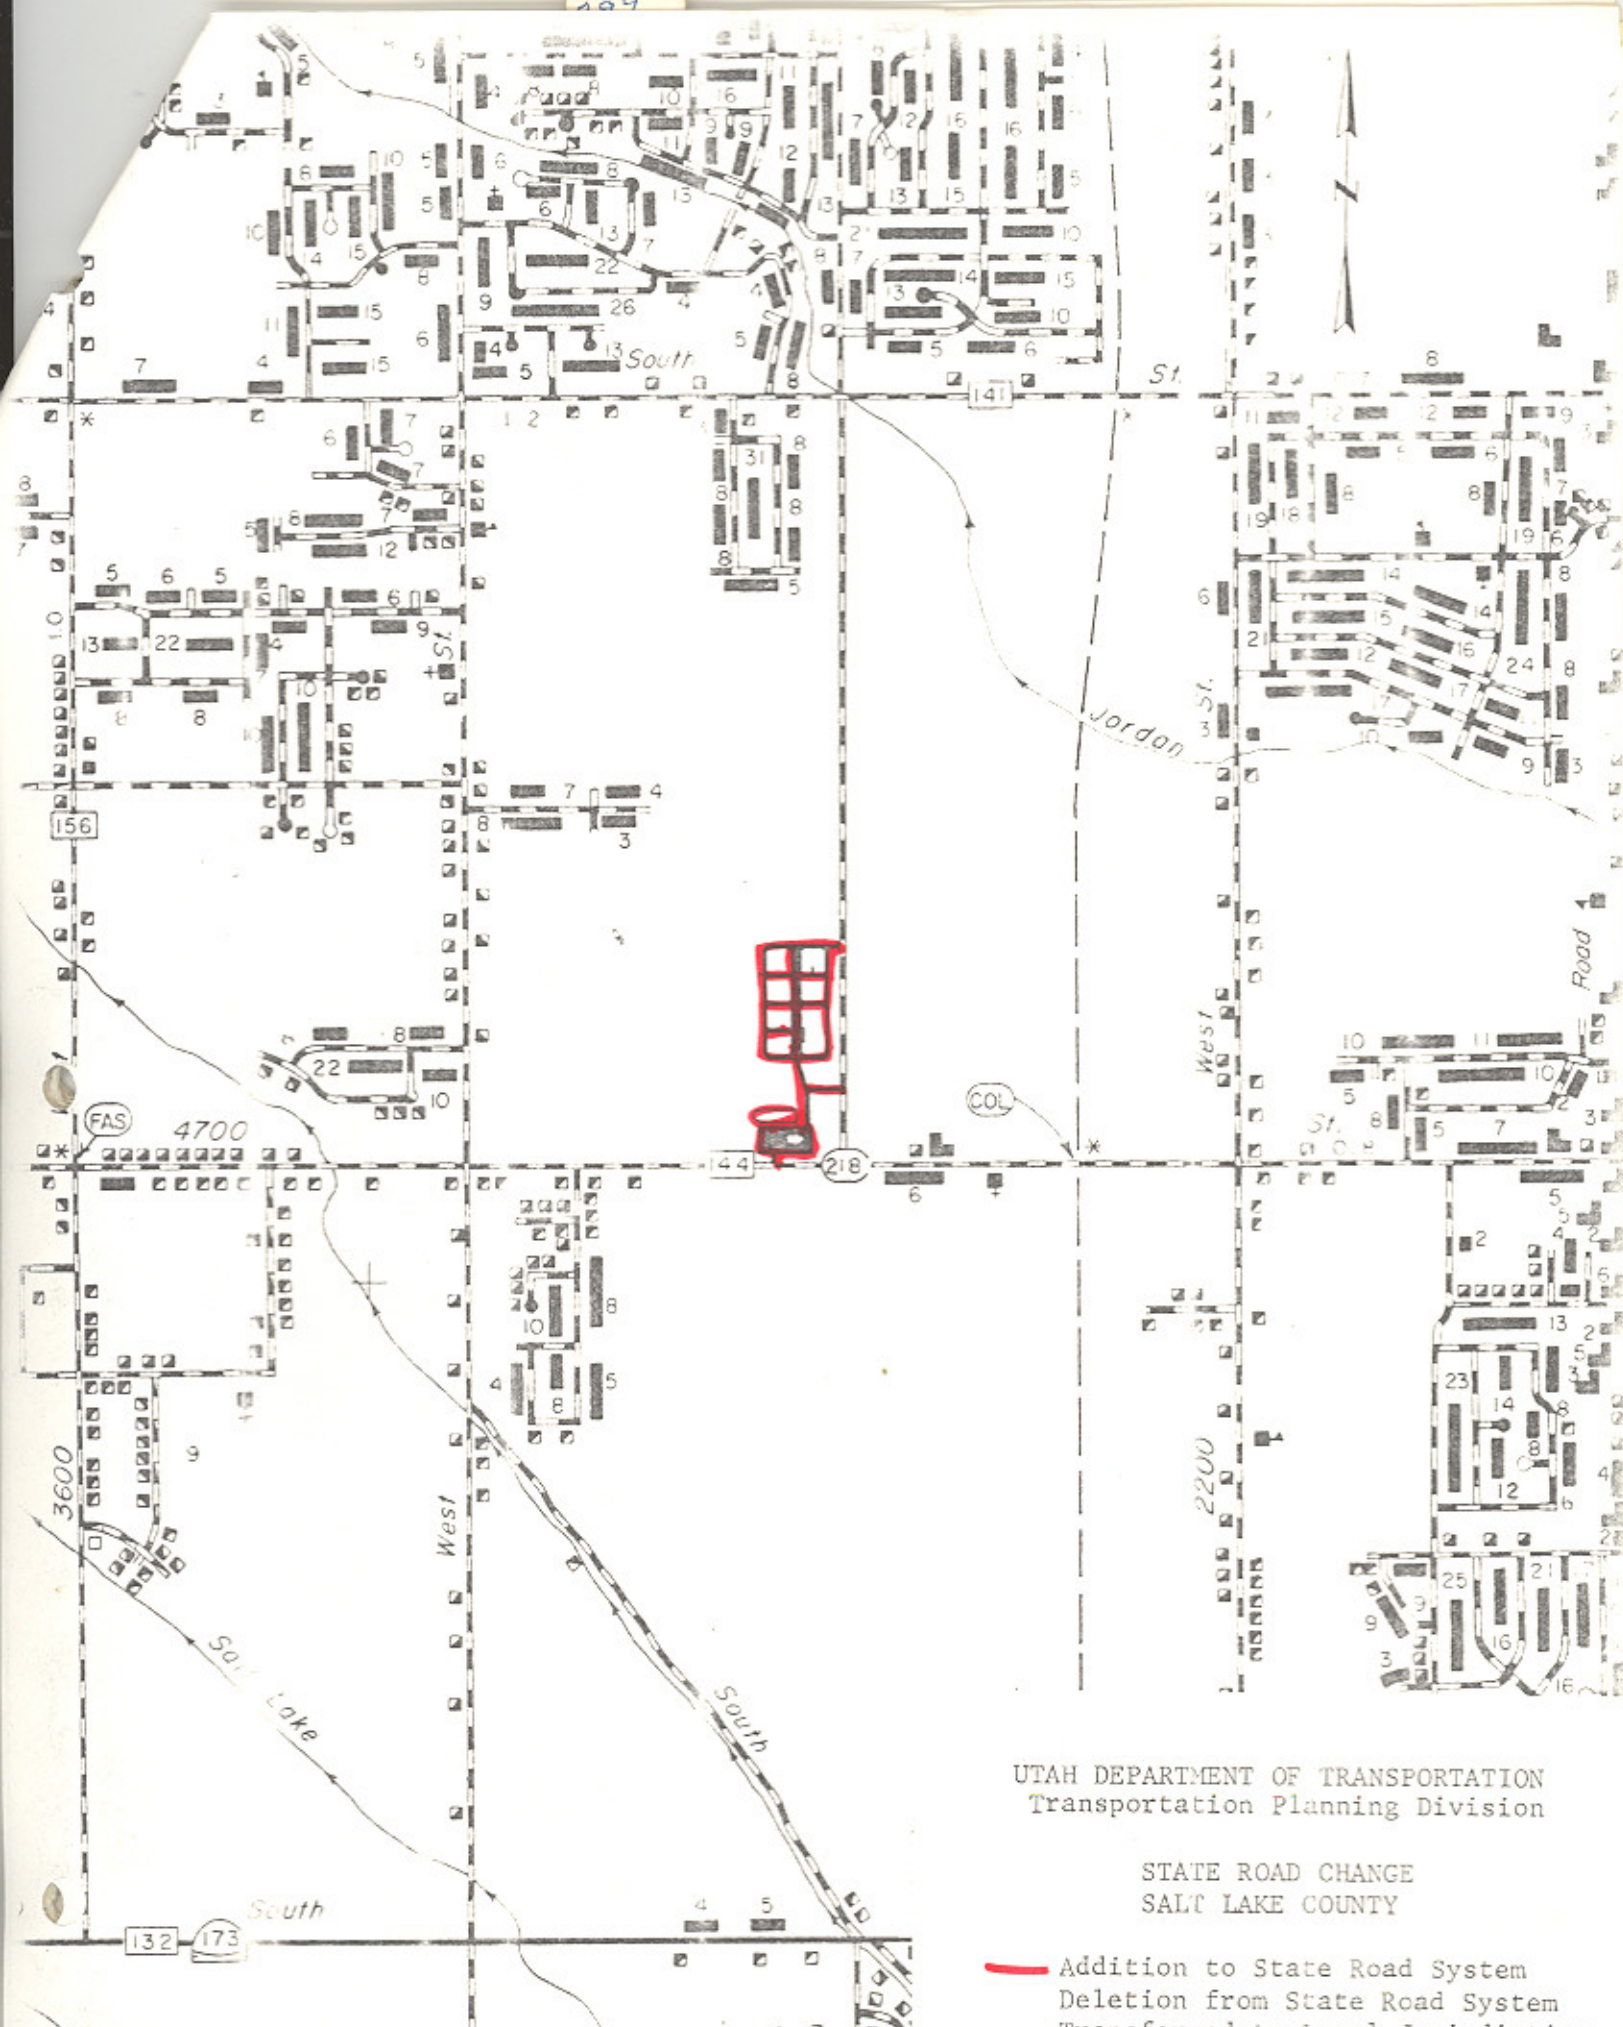
Samuel ...
Commissioner

Henry ...
Commissioner

ATTEST:



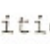
Ronald ...
Secretary

SR-109



UTAH DEPARTMENT OF TRANSPORTATION
 Transportation Planning Division

STATE ROAD CHANGE
 SALT LAKE COUNTY

 Addition to State Road System
 Deletion from State Road System
 Transferred to Local Jurisdiction

Memorandum.

UTAH STATE DEPARTMENT OF HIGHWAYS

TO : Department of Transportation Personnel

DATE: February 23, 1977

FROM : L. R. Jester, P.E. *L.R.J.*
Engineer for Transportation Planning

SUBJECT: Addition of State Route 299 to the State System of Highways

On February 11, 1977, the Utah Transportation Commission approved those roads within the Motor Vehicle Test Course at 2780 West 4700 South in Salt Lake County as a part of the State System of Highways.

Attached is a copy of the resolution and a location map.

Attachment

RESOLUTION

Addition to the State Highway System, Route 295

Utah County

WHEREAS, to clarify maintenance responsibility for those roads at the Driver License facility in Orem, Utah County, that are used for the purpose of conducting driver license road tests, and

WHEREAS, those roads that are to be used for driving tests have been coordinated with the Utah State Department of Public Safety, Driver License Division, and Mr. L. R. Jester, District Director, and

WHEREAS, these roads are considered a part of the State System of Highways.

NOW THEREFORE, be it resolved as follows:

1. That the roads at the Driver License facility in Orem, Utah County, that are used for conducting driver license road tests and are a part of the State Road System be designated as State Route 295, and

2. That the parking areas be considered part of this route for maintenance responsibility, and

3. That by this action State Highway System mileage will increase 0.75± mile, and

4. That the accompanying map showing the roads used for driving tests be hereby incorporated as a part of this submission.

Dated this 16th day of July, 1982.

UTAH TRANSPORTATION COMMISSION

R. LaJawn Cox
Chairman

[Signature]
Vice-Chairman

[Signature]
Commissioner

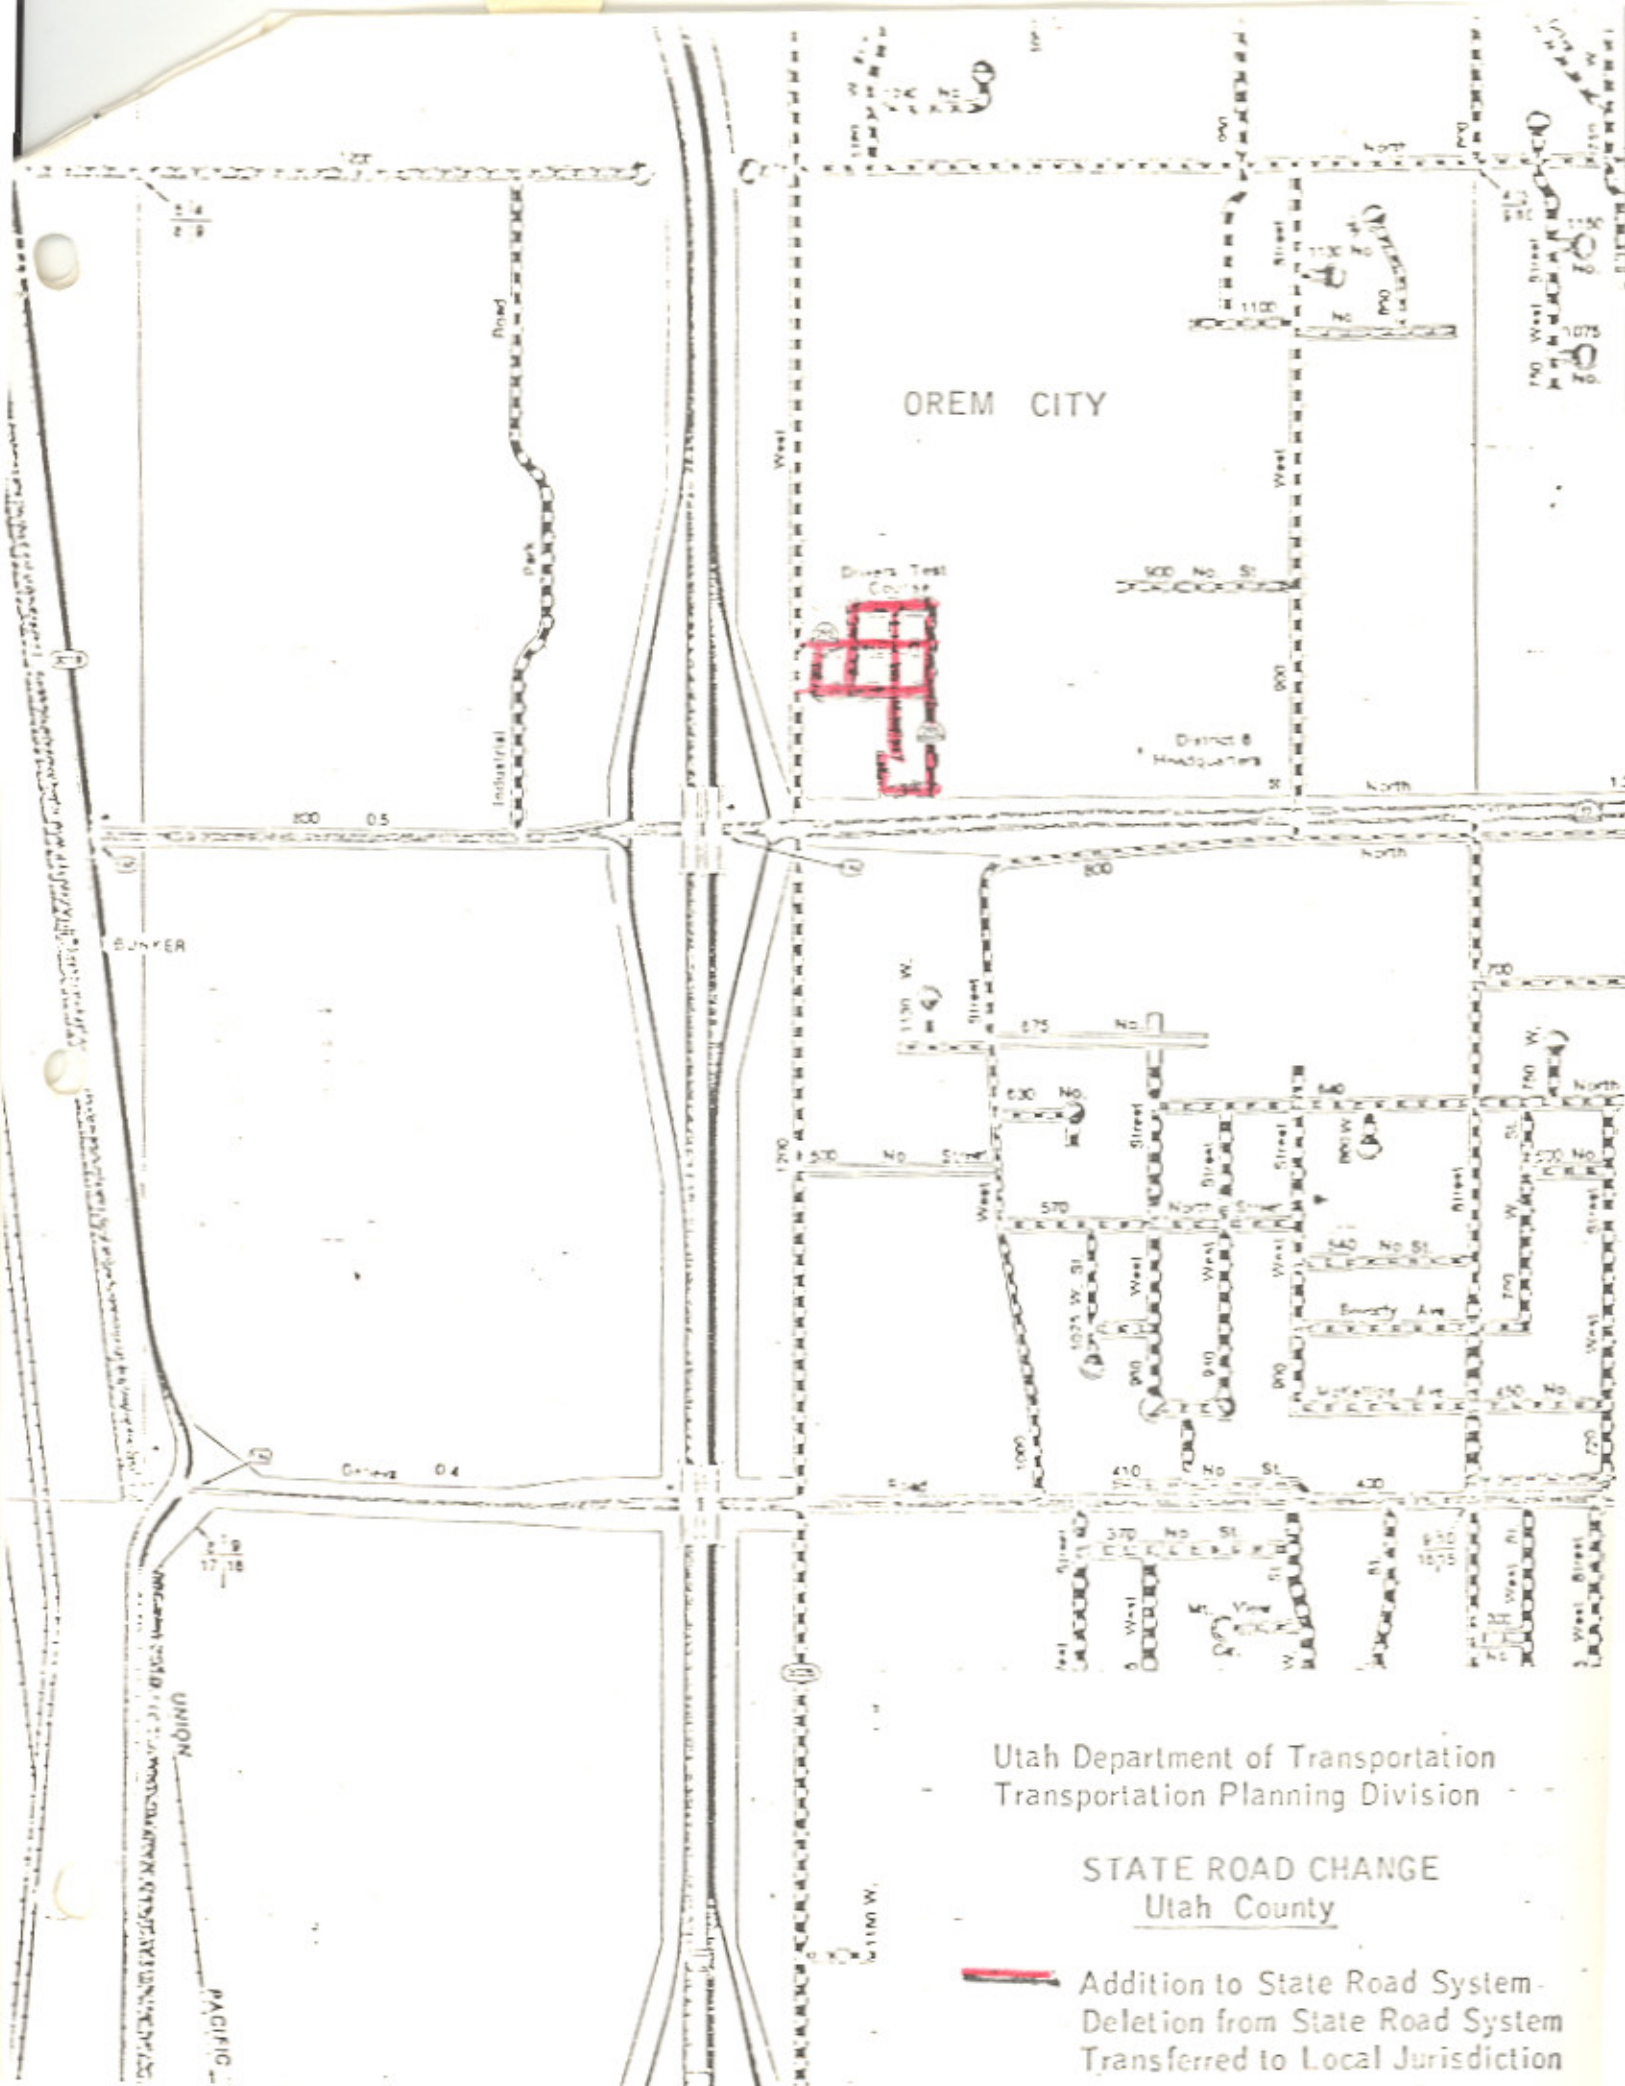
Glen H. Church
Commissioner

[Signature]
Commissioner

ATTEST:




Deva H. Anderson
Secretary

295 Nothing 295 now
Utah Low
County on
state request
[unclear]



Utah Department of Transportation
 Transportation Planning Division

STATE ROAD CHANGE
Utah County

-  Addition to State Road System
-  Deletion from State Road System
-  Transferred to Local Jurisdiction

UTAH DEPARTMENT OF TRANSPORTATION

bc: Howard B. Leatham, Engineer for Planning & Programming
Lester R. Jester, District #1 Director

August 6, 1982

C The Honorable James E. Mangum
Mayor of Orem
Orem City Offices
56 North State Street
Orem, Utah 84057

O Dear Mayor Mangum:

Subject: Addition to State Highway System

P Effective July 16, 1982, the Utah Transportation Commission approved those roads at the Department of Motor Vehicle Test Course in Orem, Utah County, that are used for the purpose of a physical test for Automotive Drivers Ability are a part of the State Highway System and be designated as State Route 295.

Y Enclosed is a copy of the resolution and a location map.

Very truly yours,

Dave Blake, P.E.
Acting Engineer for
Transportation Planning

Enclosure

Information sent to:

Jerry Fenn	Gerald Barrett	Martin Cutler	Richard Julio
Darrus Middleton	J. Q. Adair	Bonnie Garcia	Heber Vlam
Billy McCoy	James Naegle	Mark Musuris	Don Jensen
Robert Wheadon	Robin Hood	Ken Riddle	Edwin McMillen
Keith Rosevear	Art Guerts		John Petrovich

WDM:F Stevensen:be

Utah
County

RESOLUTION

Deletion of State Highway SR-295 Orem Drivers Course Test Facility Utah County

WHEREAS, Sections 72-4-102, and 72-4-103, of the Utah Code Annotated 1953, as amended, authorize the Transportation Commission to approve additions to or deletions from the state highway system, along with return to county or municipality or abandonment between general sessions of the State Legislature, and

WHEREAS, the Orem Office of the Department of Motor Vehicles has moved and the property which contained the drivers course layout (SR-295) has been sold to private interests with intent to abandon and demolish roadway defined herein, and

WHEREAS, since a new drivers course layout will not be built at the new offices of the Department of Motor Vehicles, and

WHEREAS, deletion of SR-295 from the State System of Highways has been requested through the Region Three Director, having reviewed all material and correspondence related to stated deletion from the Region Three Assistant Traffic Engineer, and

WHEREAS, the appropriate staff of the Program Development Division, reviewing the criteria for state highways and having reviewed all pertinent material and correspondence related to the proposed deletion, concur with the request by the Region Three Director for deletion of SR-295 from the State System of Highways.

NOW THEREFORE, be it resolved as follows:

1. The Utah Department of Transportation abandons any and all interest pertaining to jurisdiction, operation, and maintenance of roadway legally described as SR-295 as follows: From a junction with 1200 West crossing in Orem and traversing roadway defined as the Utah Motor Vehicle Test Course a distance of 0.650± miles and depicted on Exhibit "A"
2. The statements contain within this resolution will become effective upon passage by the Utah Transportation Commission.
3. The accompanying Exhibit "A" and Email correspondence be made part of this resolution.

Page 2

Deletion of State Highway

SR-295

Orem Drivers Course Test Facility

Utah County

Dated on this 12th day of December 2003

UTAH TRANSPORTATION COMMISSION

Steve Brown
Chairman

John R. Lohdy
Vice-Chairman

Hal M. Leiby
Commissioner

Sam C. Wells
Commissioner

Kevin T. Wilson
Commissioner

[Signature]
Commissioner

[Signature]
Commissioner

Attest: [Signature]
Secretary

From: John Quick
To: Lewis, Degen; Nielsen, Glen
Date: 11/7/03 10:37AM
Subject: Re: Removal of SR 295 From State System

Degan - Thanks for the information - we will follow up and have it deleted from the State System.

Bart - Will you prepare the Resolution necessary for this process? Thanks!

JQ

>>> Degen Lewis 11/07/03 10:10AM >>>

John,

After talking to Tracy Conti about this, he asked me to email you. State route 295 was the roads in the driver's course layout at the Orem office of the Department of Motor Vehicles. However, they have moved and the property has been sold. Since a new course will not be built at the new offices, this state route should be deleted.

Thanks.

Degen Lewis, P.E.
Assistant Traffic Engineer
UDOT - Region Three

801-222-3401 office
801-830-9588 cell

15

Drivers Test Course

900 North

1200 West

900 West

295

52

Exhibit 'A'

