


1900 West Street (State Road No. 126)

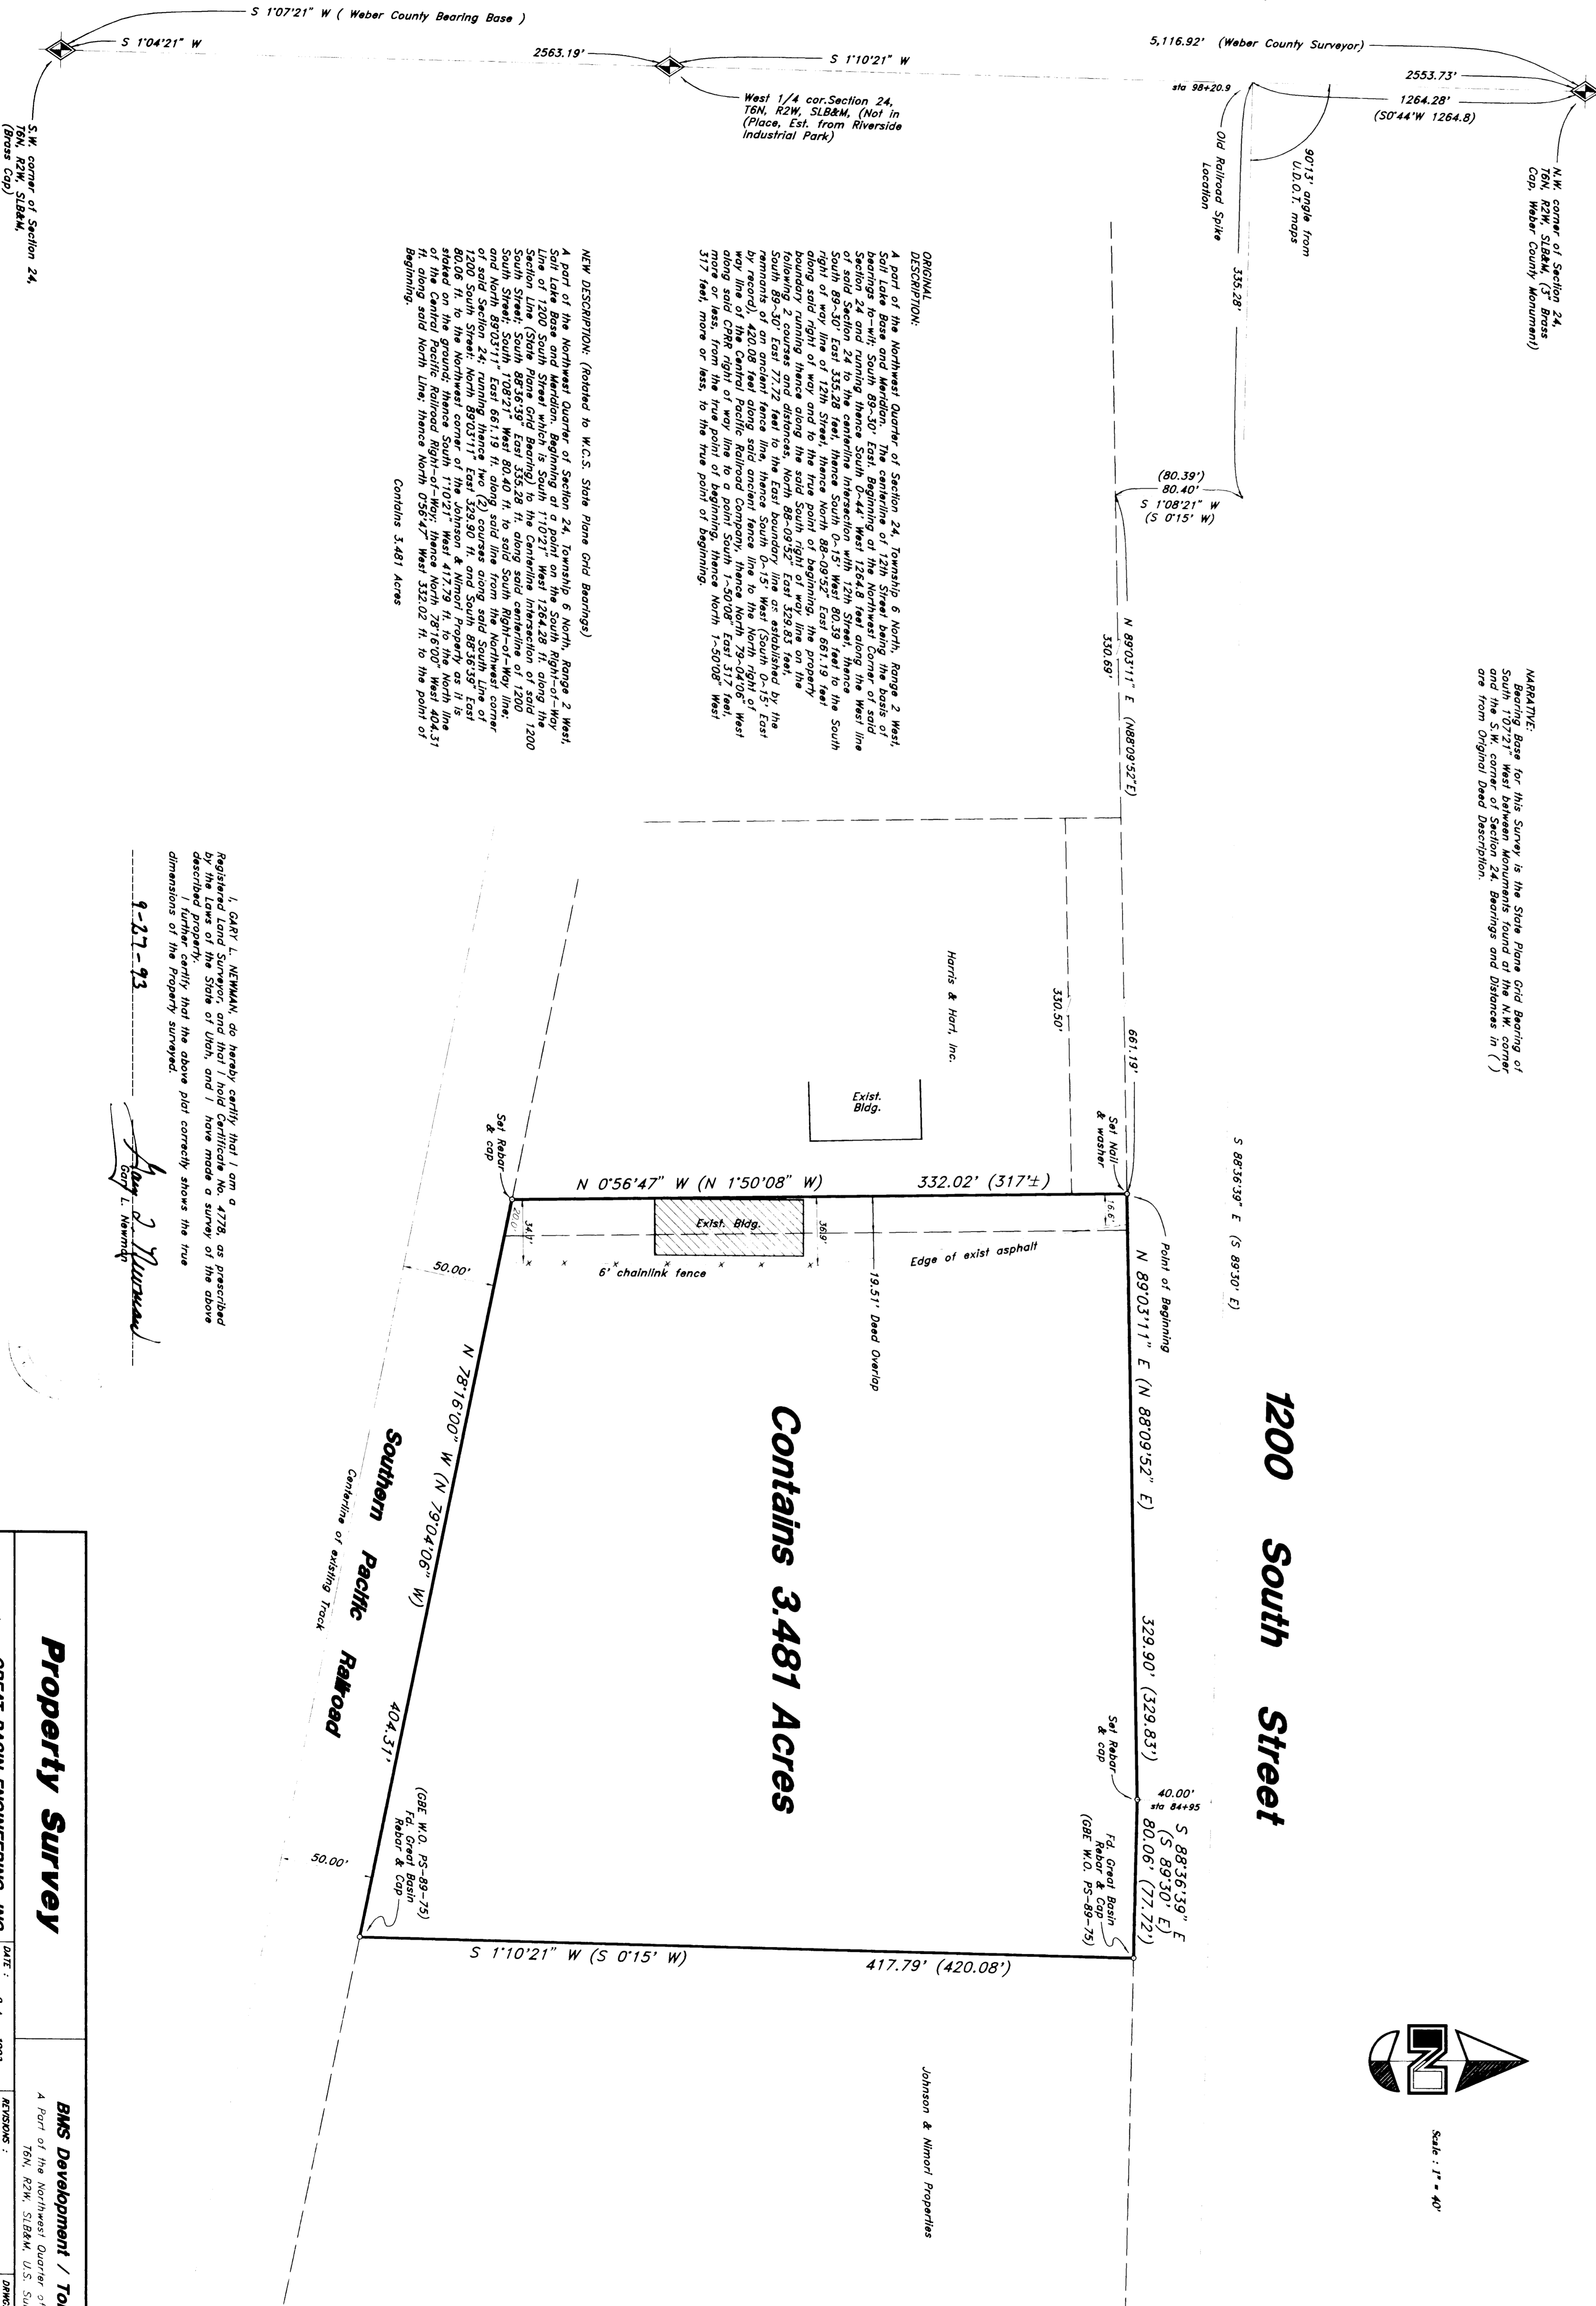

ORIGINAL DESCRIPTION:
08 feet along said ancient fence line to the North right of way line of the Central Pacific Railroad Company, thence North 1°-50'08" West 317 feet, more or less, to the true point of beginning.

NEW DESCRIPTION: (related to W.C.S. State Plane Grid Bearings)



Contains 3.481 Acres




Surveyor

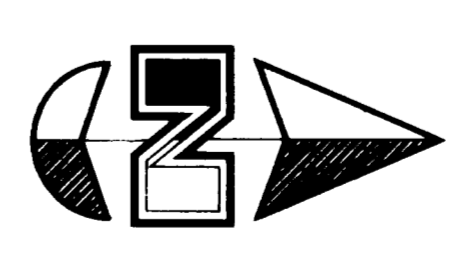

Scale: 1" = 40'

Property Survey

GREAT BASIN ENGINEERING, INC.
5544 Lincoln Avenue, Ogden, Utah, 84401
P.O. Box 9007, Ogden, Utah, 84409
Phone: (801) 466-4411 Fax: (801) 466-4412

BMS Development / Tom Makin
A Part of the Northwest Quarter of Section 24,

DATE: 8 Aug, 1993
SCALE: 1" = 40'
DWG. NO. PS-93-03