

001001

PLAN HOLD CORPORATION • IRVINE, CALIFORNIA
RECORDER BY NUMBER 07548
POSITION EDGE OF PAINT OR THE LINE

DRAWING NUMBER







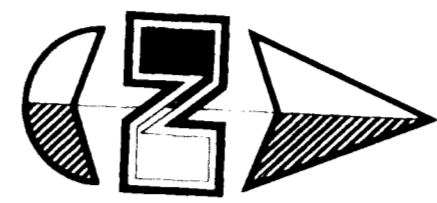

Scale: 1" = 50'

Riverdale Road

Thirty-seventh


Grant Avenue

Street

Avenue

Boulevard

Washington

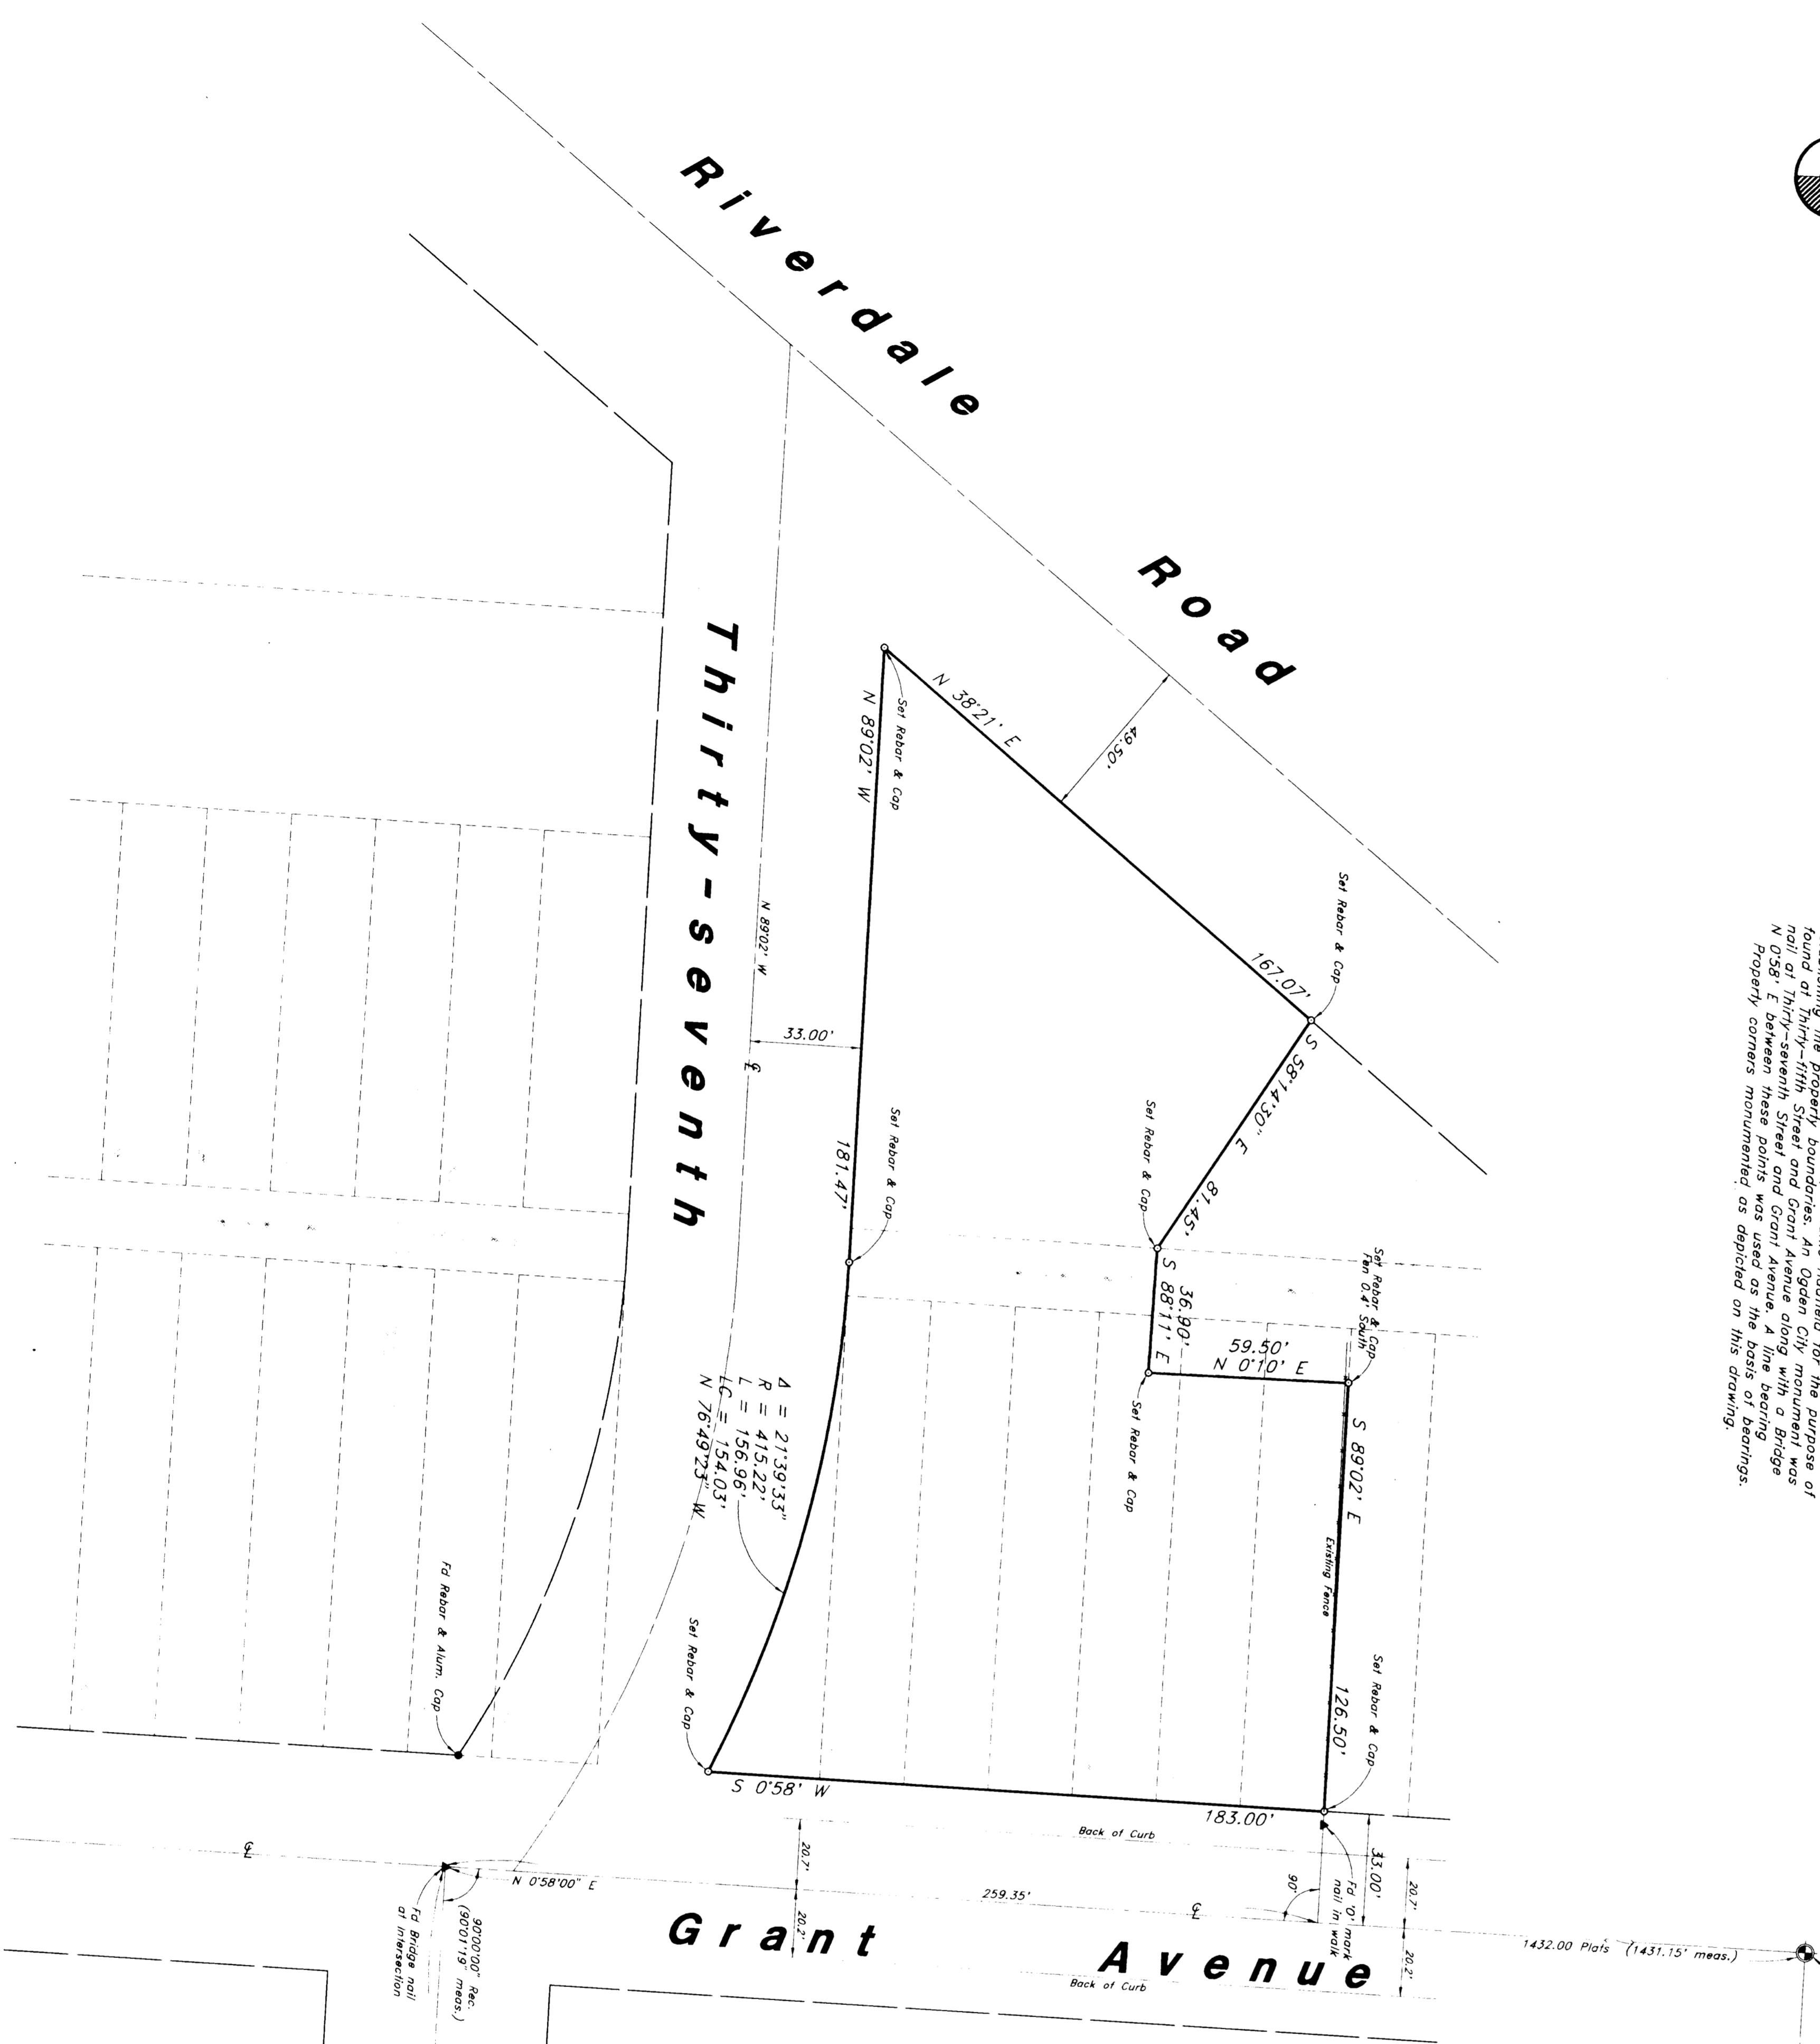


MAPS/PLATS
This survey was requested by Melonie Hatfield for the purpose of establishing the property boundaries of a portion of the property located at the intersection of Thirty-seventh Street and Grant Avenue. A low wall bridge was located between the two streets. The property corners monumented as depicted on this drawing.

DESCRIPTION

Contains 38,233 Square Feet

CERTIFICATION
I, Gary L. Newman, do hereby certify that I am a Registered Land Surveyor, and have made a survey of the above described property, I further certify that the above data is true and correct.

Gary L. Newman
Gary L. Newman

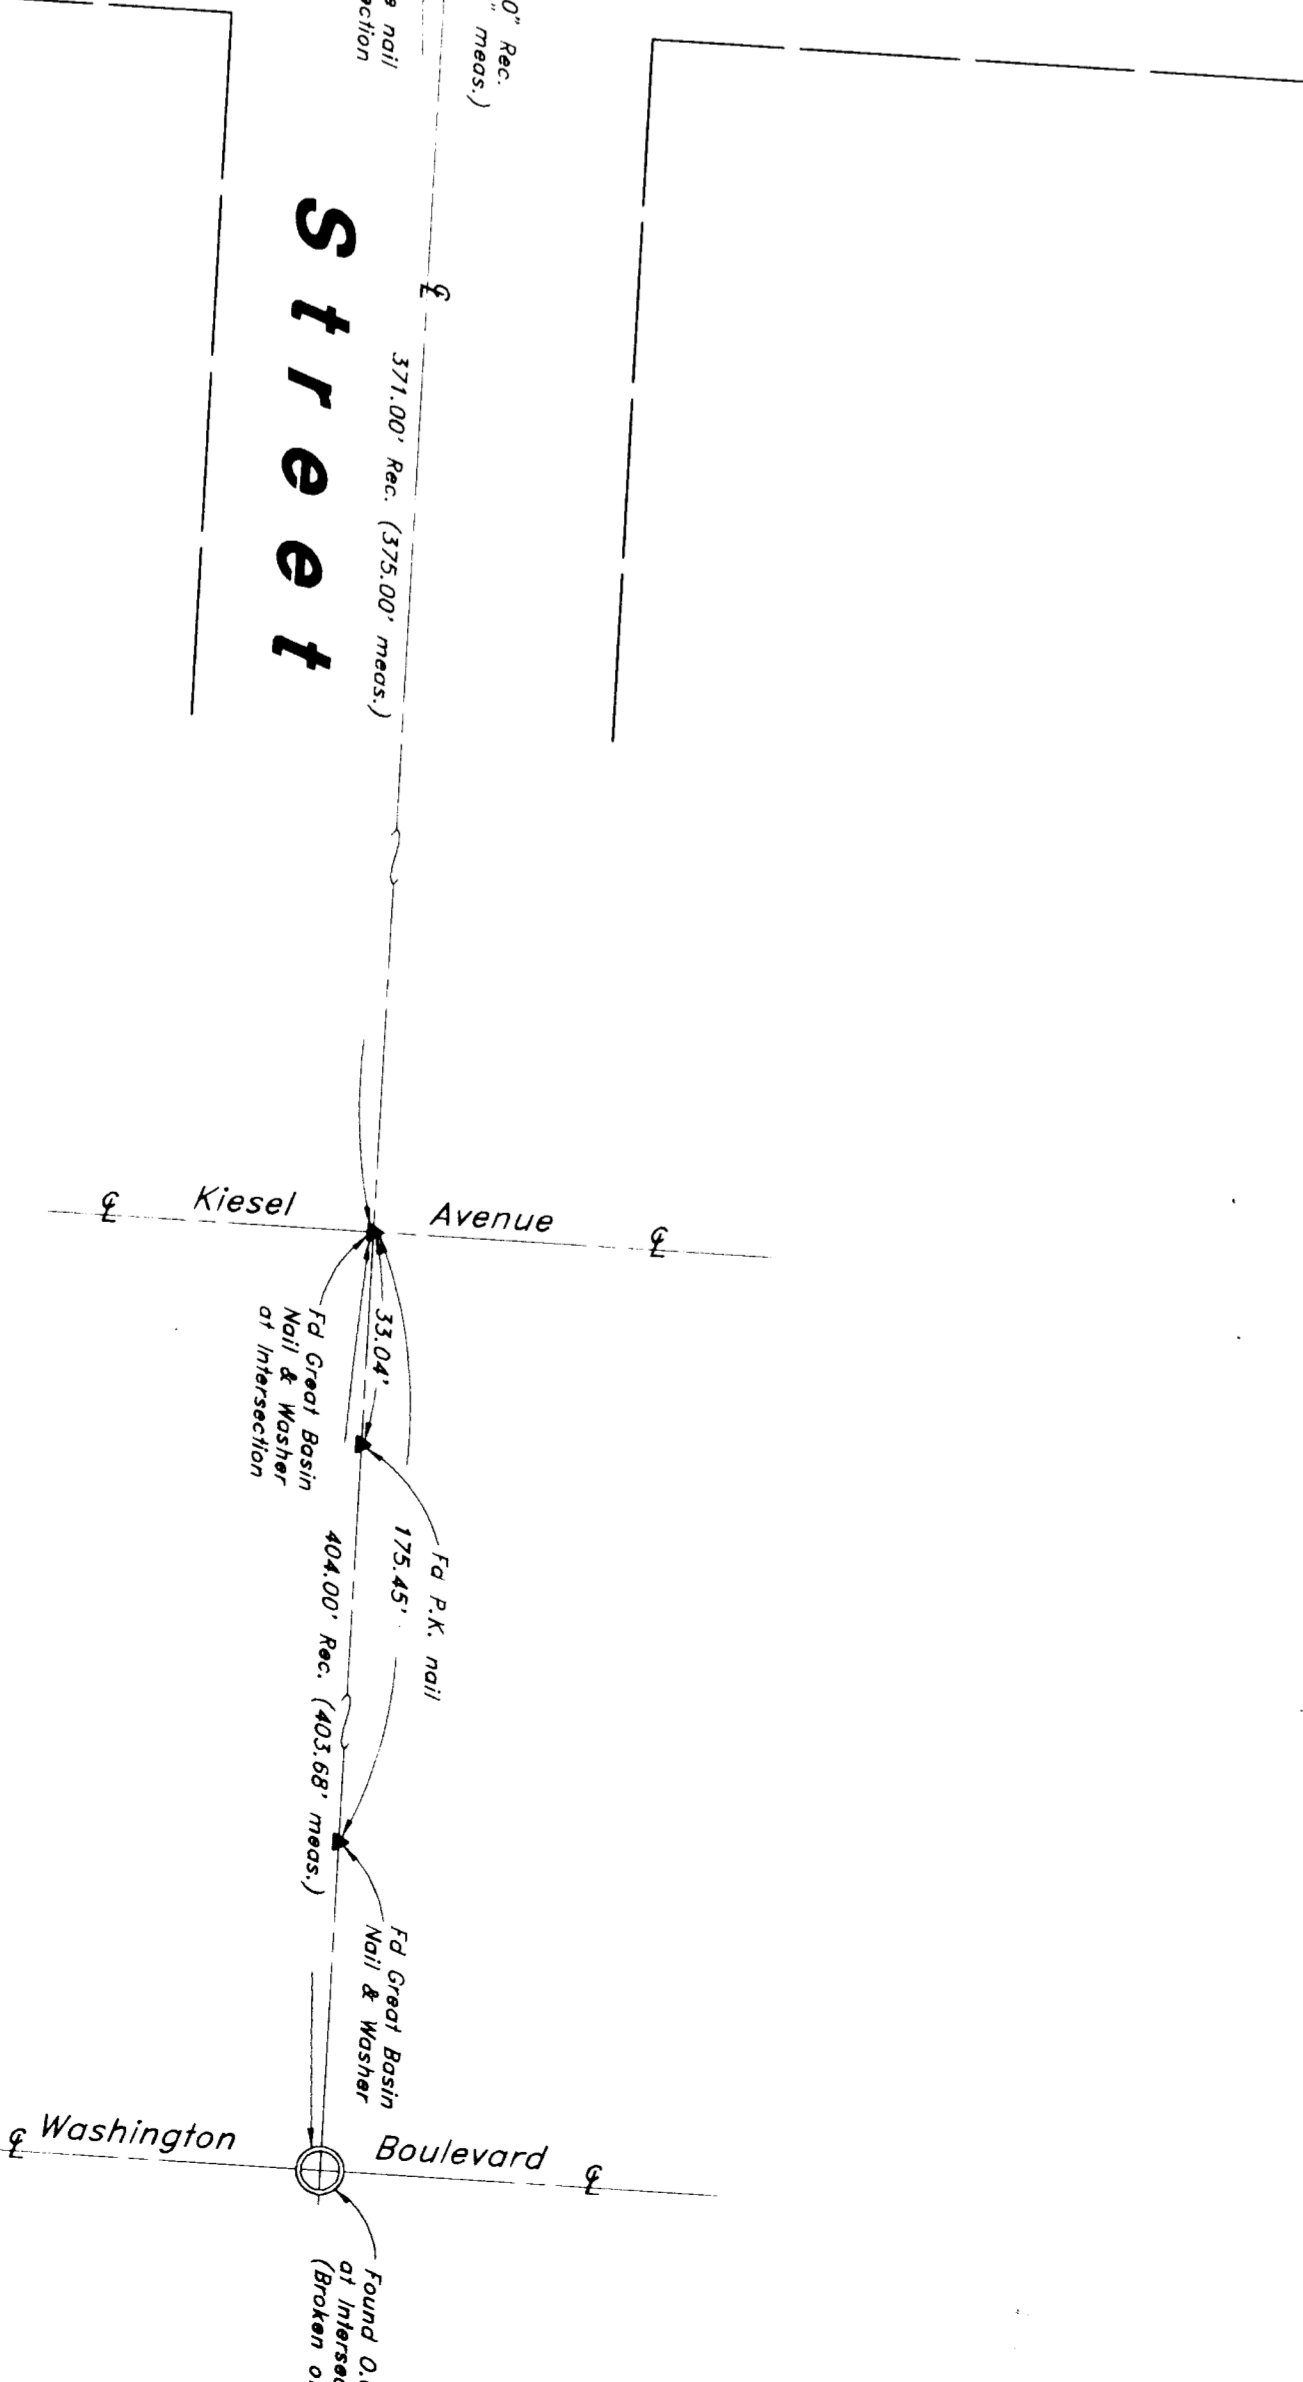

Property Survey


GREAT BASIN ENGINEERING, INC.
410 Lincoln Avenue, Ogden, Utah 84401
3500 Van Buren Avenue, Ogden, Utah 84401
DATE: 11 Nov., 1993

Melanie Hatfield
3540 Van Buren Avenue
Ogden, Utah 84401

RECEIVED
MAY 19 1994
Weber County Survey Office