

DRAWING NUMBER
001009





PLAN HOLD CORPORATION • IRVINE, CALIFORNIA
RECORDER BY NUMBER 07541
REGISTERED LAND SURVEYOR




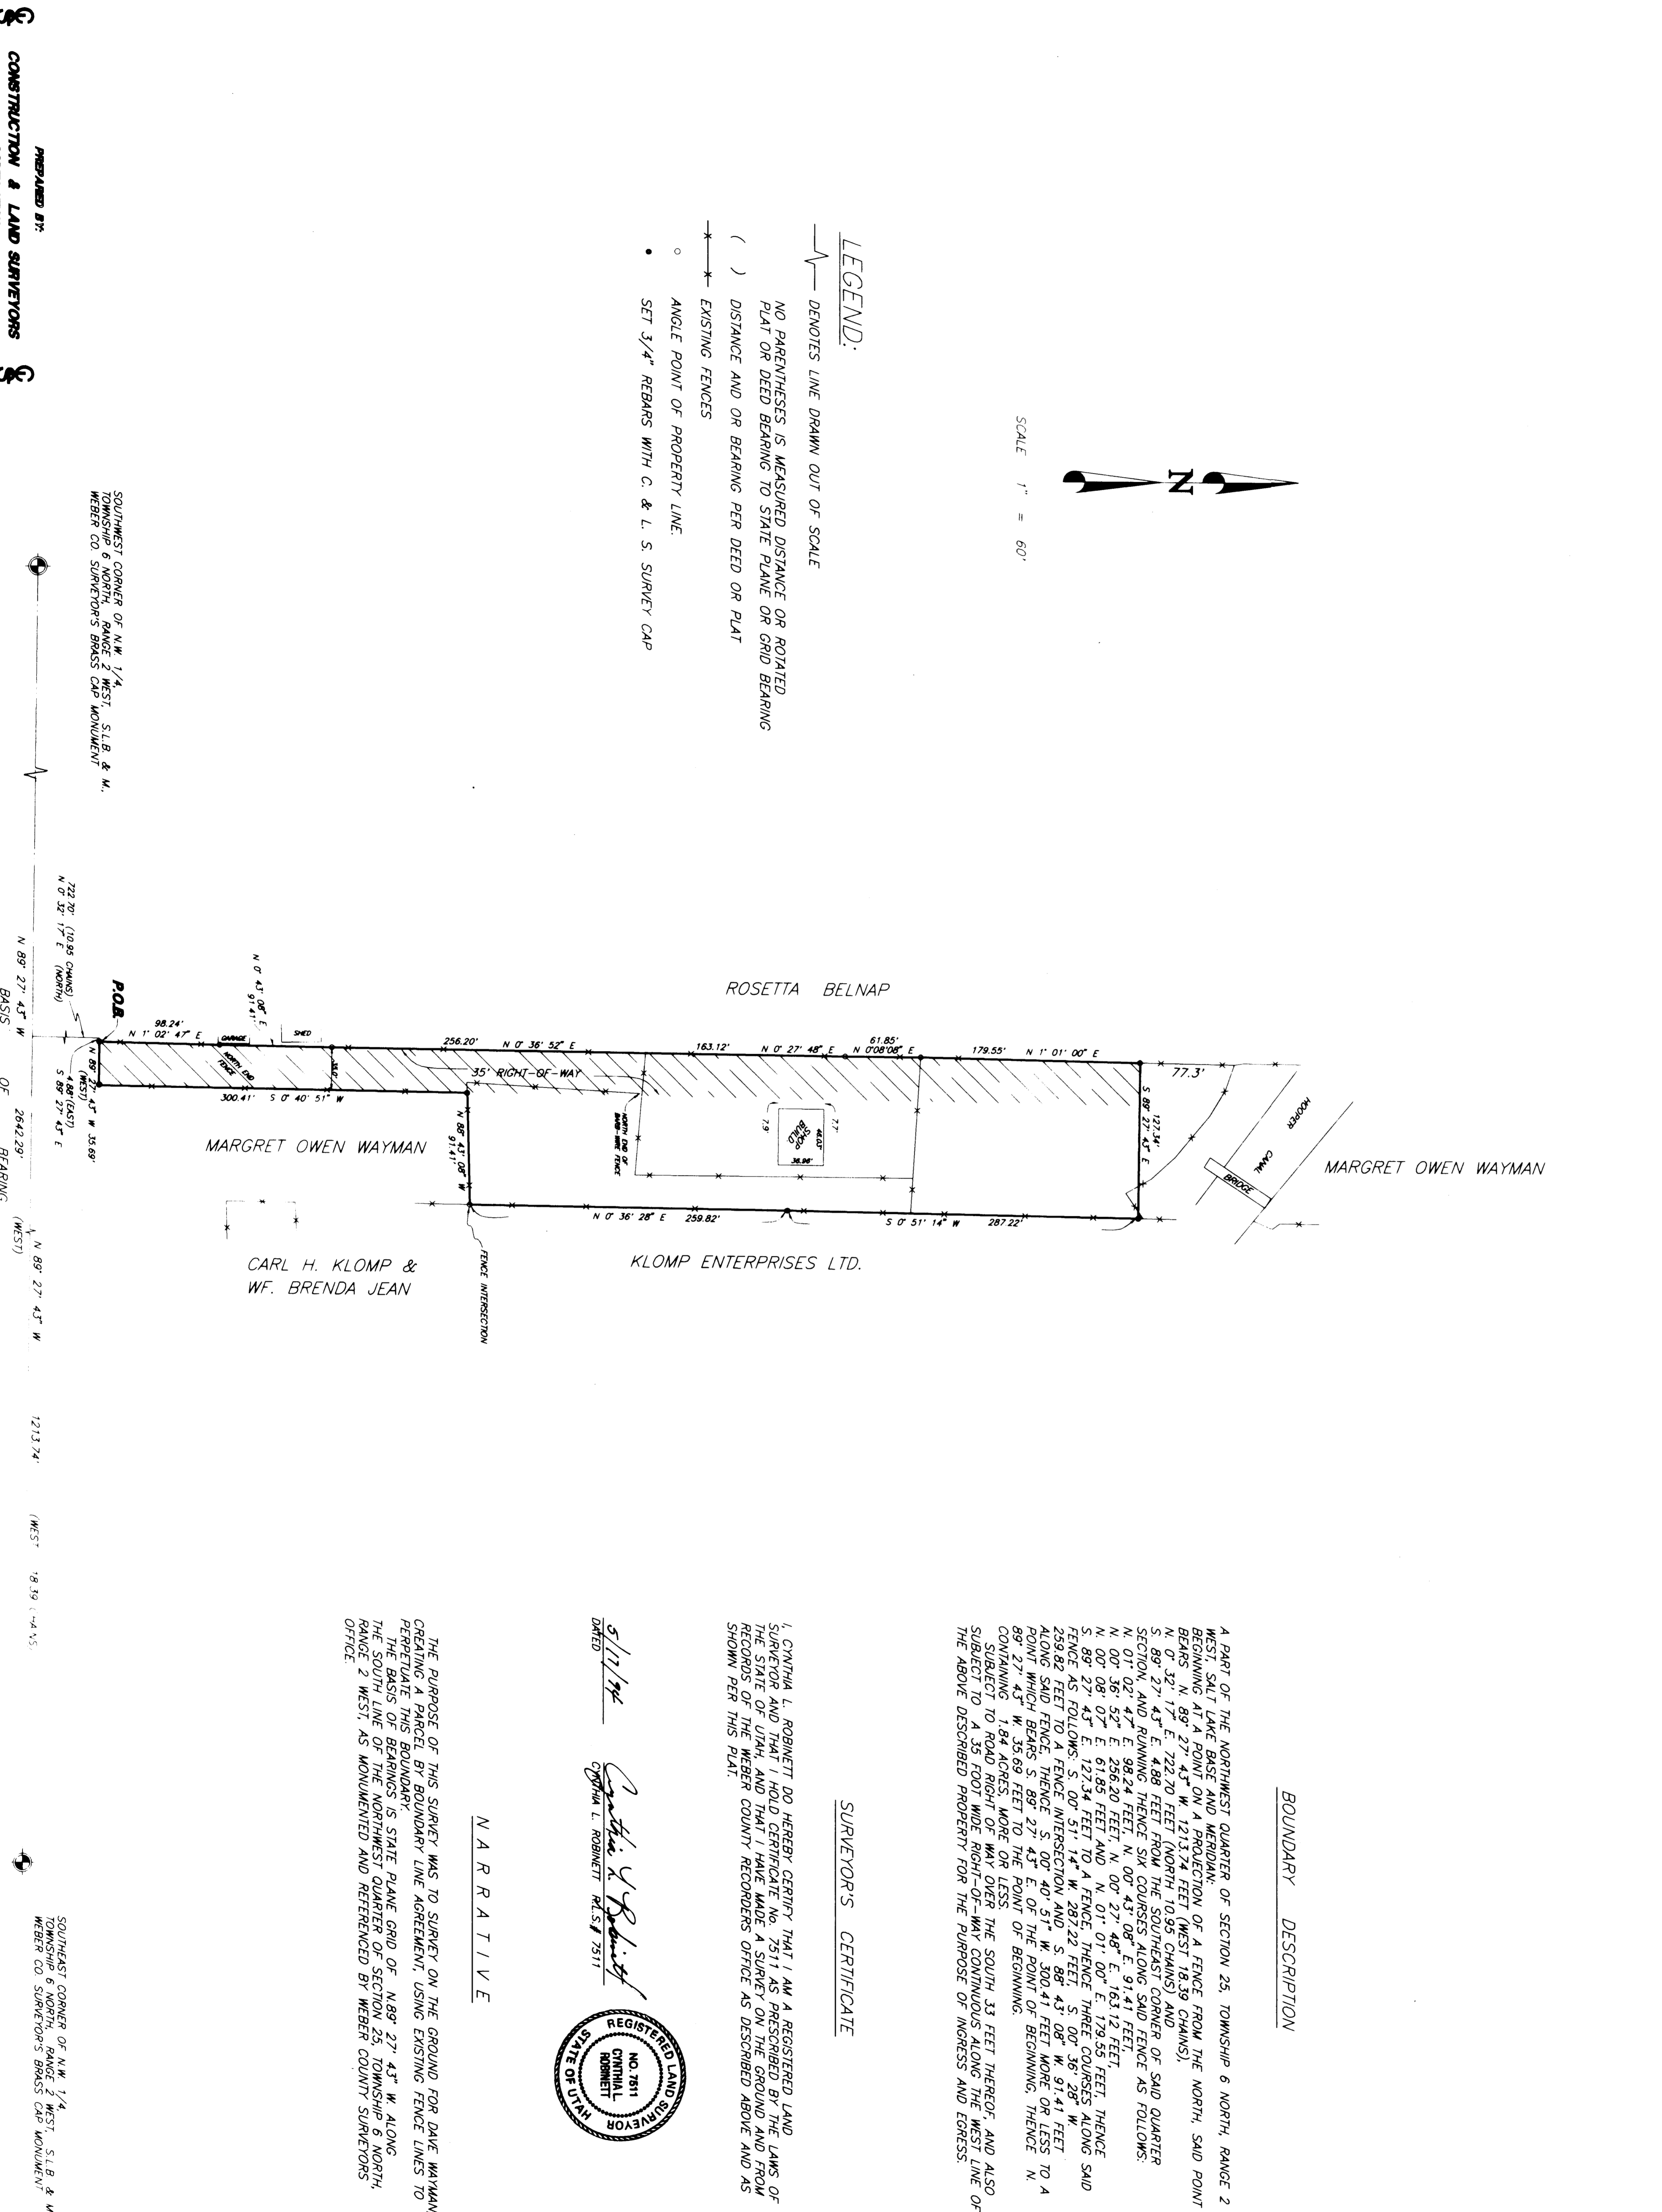

CONSTRUCTION & LAND SURVEYORS
 2251 WASHINGTON BLVD
 COVINGTON, UTAH 84401
 (801) 398-4935

CLIENT: DAVE WAYMAN

SURVEY LOCATION:
 N. 1/4 SEC. 25, RANGE 2 WEST,
 TOWNSHIP 6 NORTH, RANGE 2 WEST, AS MONUMENTED
 WEBER CO SURVEYORS BRASS CAP MONUMENT

SURVEY DATE: 5/10/94

RECEIVED
 JUN 29 1994
 WEBER COUNTY SURVEYORS OFFICE

REGISTERED LAND SURVEYOR
 NO. 7511
 CYNTHIA L. ROBINETT
 STATE OF UTAH

5/17/94
 Cynthia L. Robinett
 CYNTHIA L. ROBINETT, R.L.S. 7511



