


**CONTAINS 44.45 ACRES**

**EXPLANATION**  
This survey was ordered by Mr. Jed McCormick for the purpose of establishing boundary lines. Brass caps were found at the Northeast Corner of Section 15, Township 6 North, Range 2 West, and the North Quarter Corner of Section 15, Township 6 North, Range 2 West. A Utah State Plane Grid bearing of North 88°36'53\"

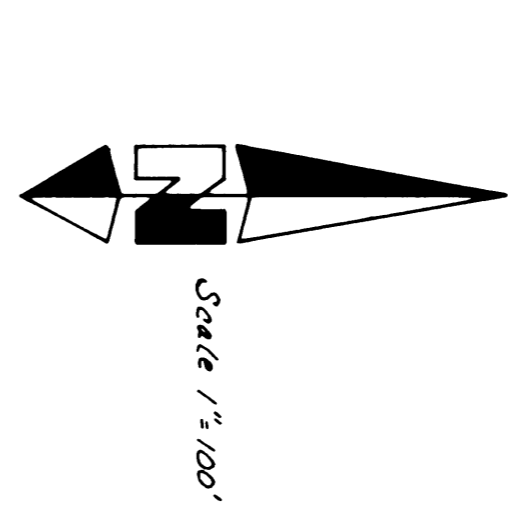

**DESCRIPTION**  
A Part of Sections 9, 15 and 16, Township 6 North, Range 2 West, Salt Lake Base and Meridian, U.S. Survey;  
Beginning at the Section corner common to Sections 9, 10, 15 and 16, and running thence North 89°40' East 130 feet along the section line between Sections 10 and 15; thence South 79°18'38\"

I, Gary L. Reenan, do hereby certify that I am a Registered Land Surveyor, and that I hold Certificate No. 4778, as prescribed by the Laws of the State of Utah, and I have made a survey of the above described property. I further certify that the above plat correctly shows the true dimensions of the property surveyed.  
Date: 5-9-85  
Gary L. Reenan  
GARY L. REENAN  
STATE OF UTAH

RECEIVED  
MAY 11 1985  
Jed McCormick  
Whiter County Surveyor

**GREAT BASIN ENGINEERING, INC.**  
SALT LAKE CITY, UTAH  
Property Survey  
for  
Jed McCormick  
East of Sections 9, 15 and 16, T6N, R2W, S20T4N