

1	REVISION
2	
3	
4	

PROJECT NO.	
DATE	JUNE 24, 1994
SCALE	1" = 40'
DRAWN	C. CAHILL
CHECKED	

REEVE & REEVE, INC.  
 CIVIL AND ENVIRONMENTAL ENGINEERING  
 LAND SURVEYING  
 OGDEN, UTAH

RECORD OF SURVEY

ANDERSON, GUYMON  
 FERNELLIUS, PENROD

SHEET  
 SHEETS

BOUNDARY DESCRIPTIONS


-ALMA MILTON ANDERSON PARCEL -  
 PART OF THE N 1/2 OF SEC. 26, T.5N, R.1W, S.L.B. & M.  
 DESCRIBED AS FOLLOWS:  


-PENROD PARCEL -  
 PART OF THE N 1/2 OF SEC. 26, T.5N, R.1W, S.L.B. & M.  
 DESCRIBED AS FOLLOWS:  
 BEGINNING AT A POINT ON THE EAST LINE OF 2275 EAST STREET, SAID POINT BEING 5007'02'25" W 1217.60 FEET AND N85°36'39"W 139.54 FEET FROM THE N 1/4 CORNER OF SAID SEC. 26 (BASIS OF BEARING BEING N00°02'25"E BETWEEN THE CENTER AND THE N 1/4 OF SAID SEC. 26); AND RUNNING THENCE S89°36'39"E 219.00 FEET; THENCE S05°04'51"W 50.27 FEET TO A FENCE; THENCE N86°11'08"W 215.90 FEET ALONG SAID FENCE TO THE EAST LINE OF SAID STREET; THENCE N07°39'16"E 52.49 FEET ALONG SAID EAST LINE TO THE POINT OF BEGINNING; CONTAINS 1.16(5) SQ. FT.(0.26 ACRES) MORE OR LESS.

-GUYMON PARCEL -  
 PART OF THE N 1/2 OF SEC. 26, T.5N, R.1W, S.L.B. & M.  
 DESCRIBED AS FOLLOWS:  


-CARL N. ANDERSON PARCEL -  
 PART OF THE N 1/2 OF SEC. 26, T.5N, R.1W, S.L.B. & M.  
 DESCRIBED AS FOLLOWS:  
 BEGINNING AT A POINT ON THE SOUTH LINE OF 6550 SOUTH STREET, SAID POINT BEING S00°02'25" W 1004.18 FEET AND S84°50'20"E 125.70 FEET FROM THE N 1/4 CORNER OF SAID SEC. 26 (BASIS OF BEARING BEING N00°02'25"E BETWEEN THE CENTER AND THE N 1/4 OF SAID SEC. 26); AND RUNNING THENCE S84°50'20"E 133.00 FEET ALONG SAID SOUTH LINE OF 6550 SOUTH STREET; THENCE S03°45'34"W 267.41 FEET; THENCE S84°58'28"E 158.50 FEET; THENCE S19°23'54"W 394.55 FEET; THENCE N73°47'51"W 216.66 FEET; THENCE S86°11'08"E 500 FEET; THENCE N02°20'05"E 352.78 FEET; THENCE S86°11'08"E 5.00 FEET; THENCE N04°31'48"E 261.27 FEET TO THE POINT OF BEGINNING; CONTAINS 3.00 ACRES, MORE OR LESS.



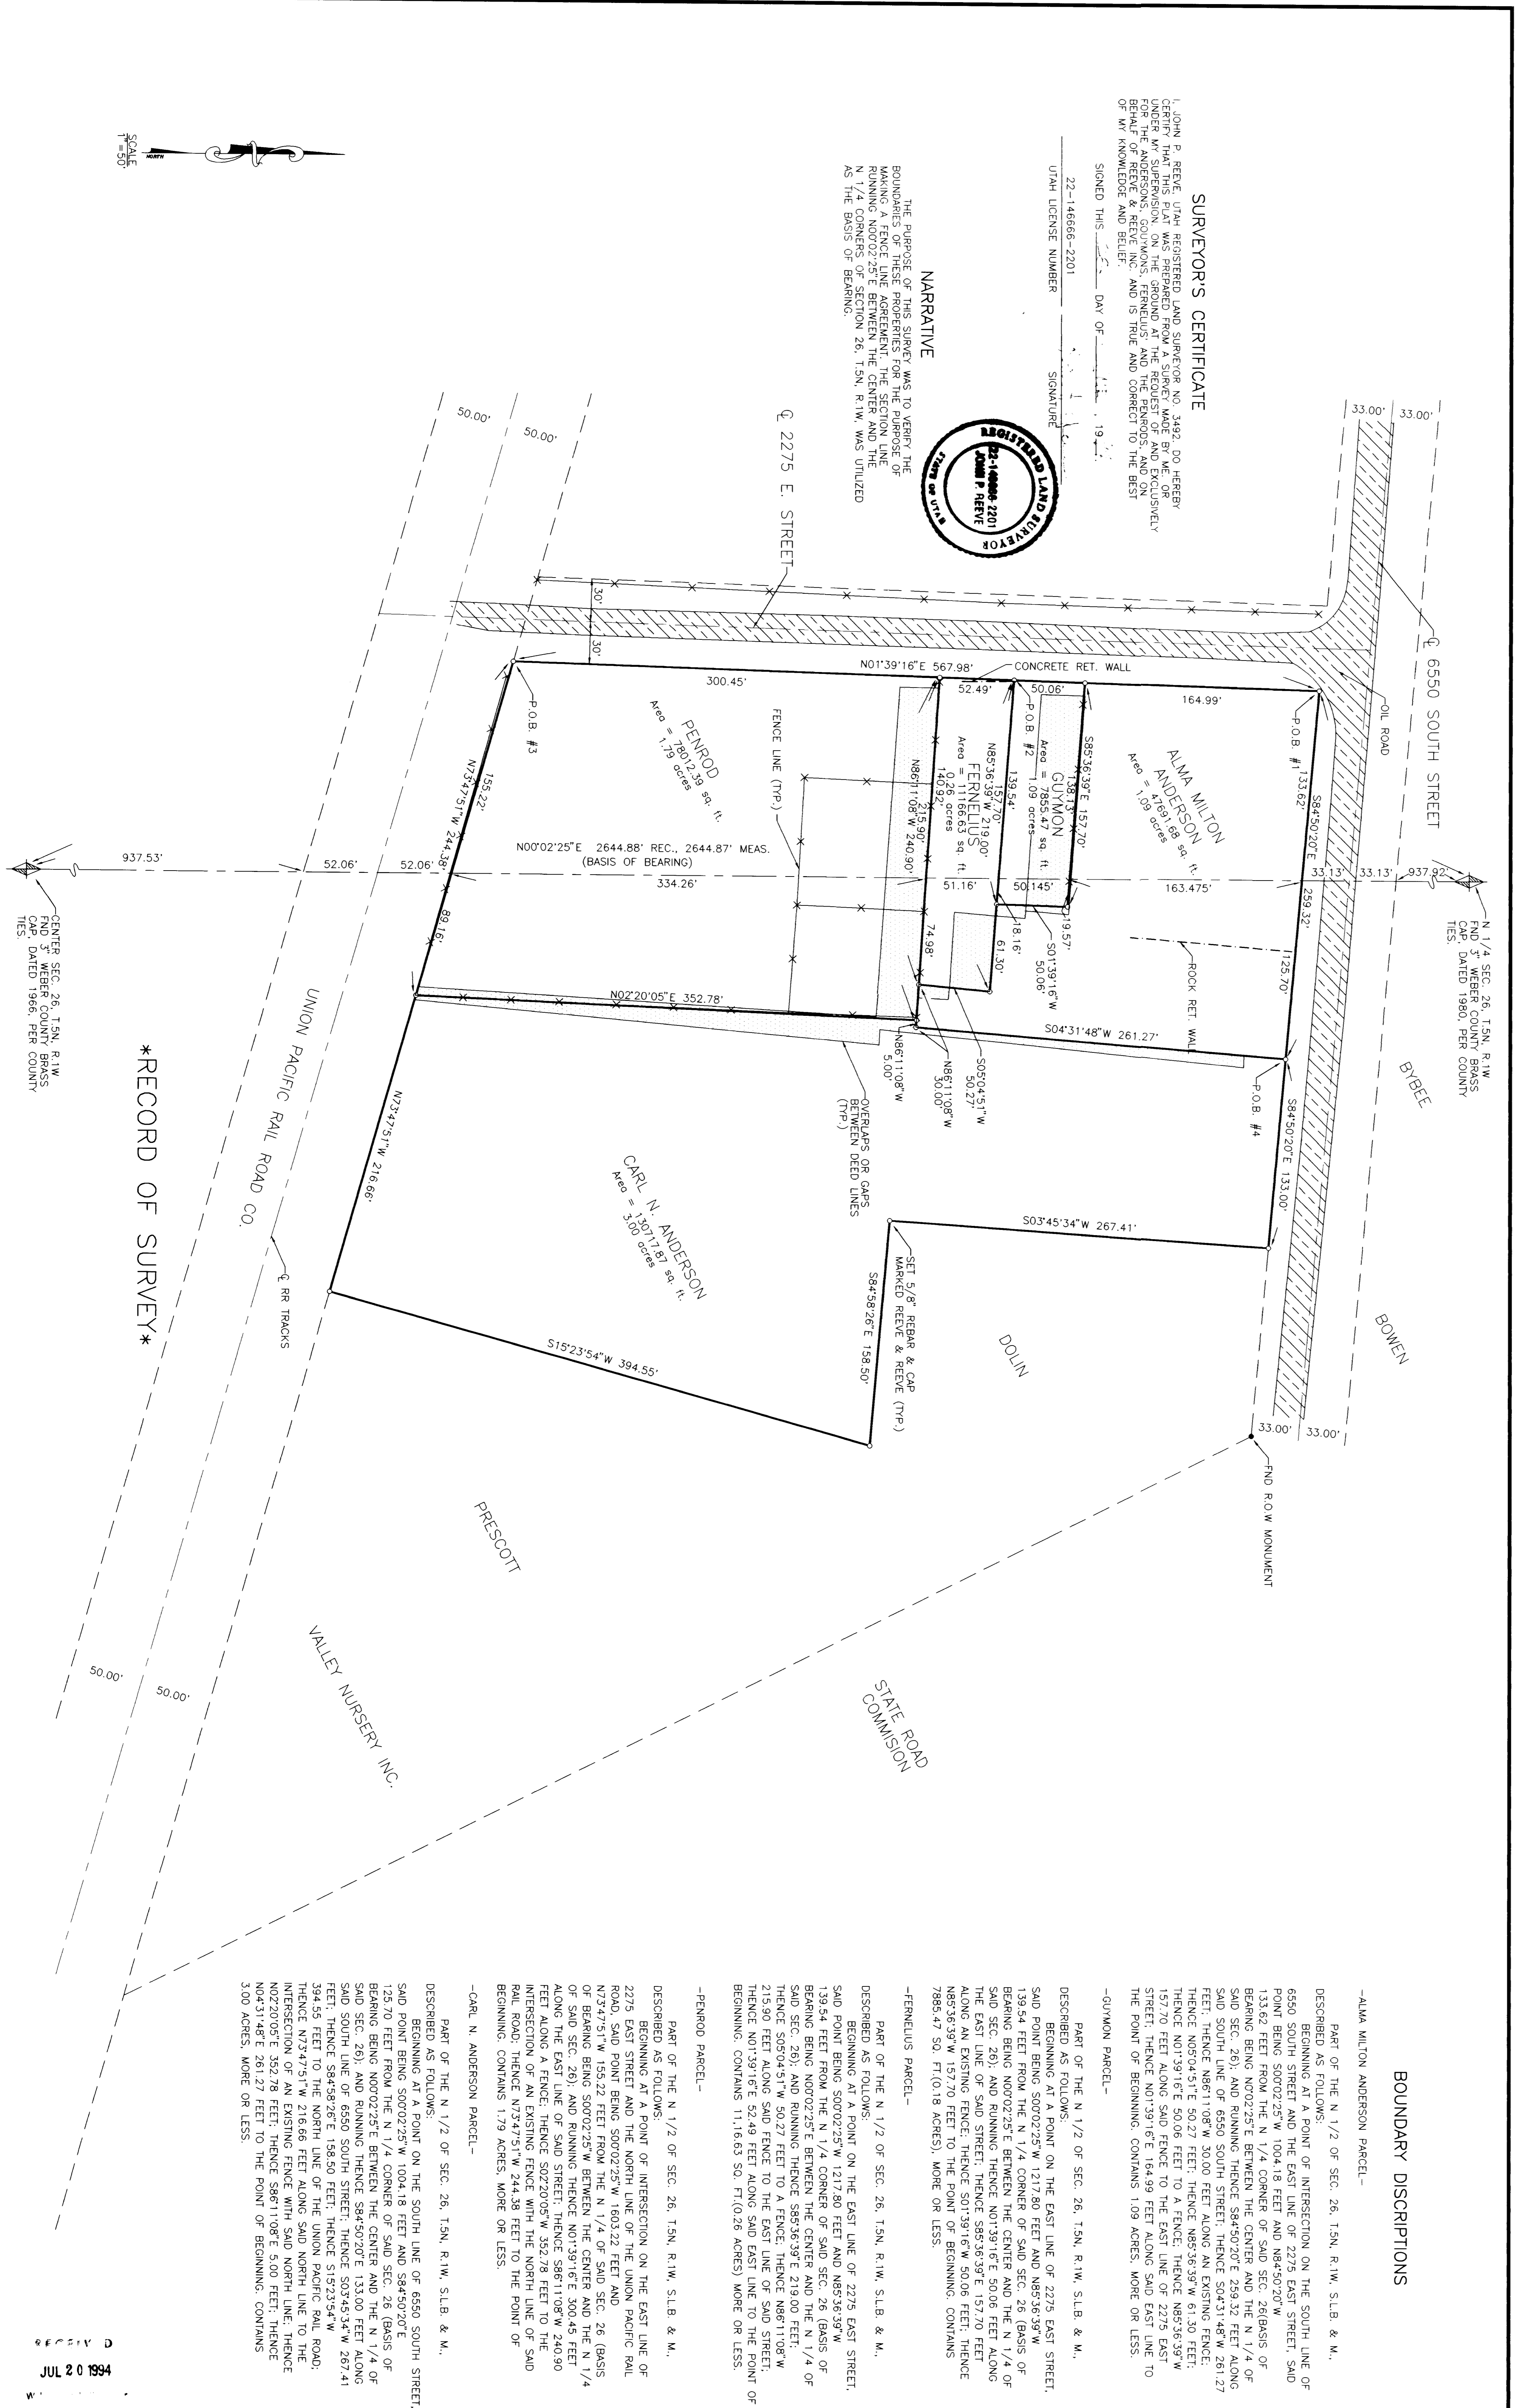


SURVEYORS' CERTIFICATE  


NARRATIVE  



UTAH LICENSE NUMBER 22-14666-2201  
 SIGNATURE

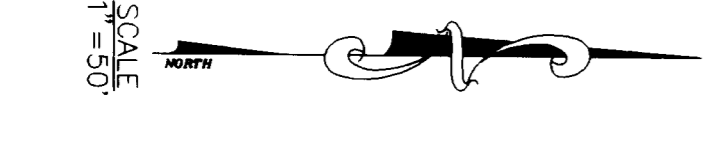

\*RECORD OF SURVEY\*

CENTER SEC. 26, T.5N, R.1W, FND 5" WEIR COUNTY BRASS CAP, DATED 1966, PER COUNTY M.S.

JUL 20 1994