

1	REVISION
2	
3	
4	


PROJECT NO.	DATE	ISSUED
2008-001	JUL 1, 2008	C. CHASE
SHEET	1 - 60	APPROVED

REEVE & REEVE, INC.  
CIVIL AND ENVIRONMENTAL ENGINEERING  
LAND PLANNING AND SITE DESIGN  
LAND SURVEYING  
OGDEN, UTAH


RECORD OF SURVEY

COURTNEY & BARBARA  
HANSON  
PROPERTY

SHEET
1

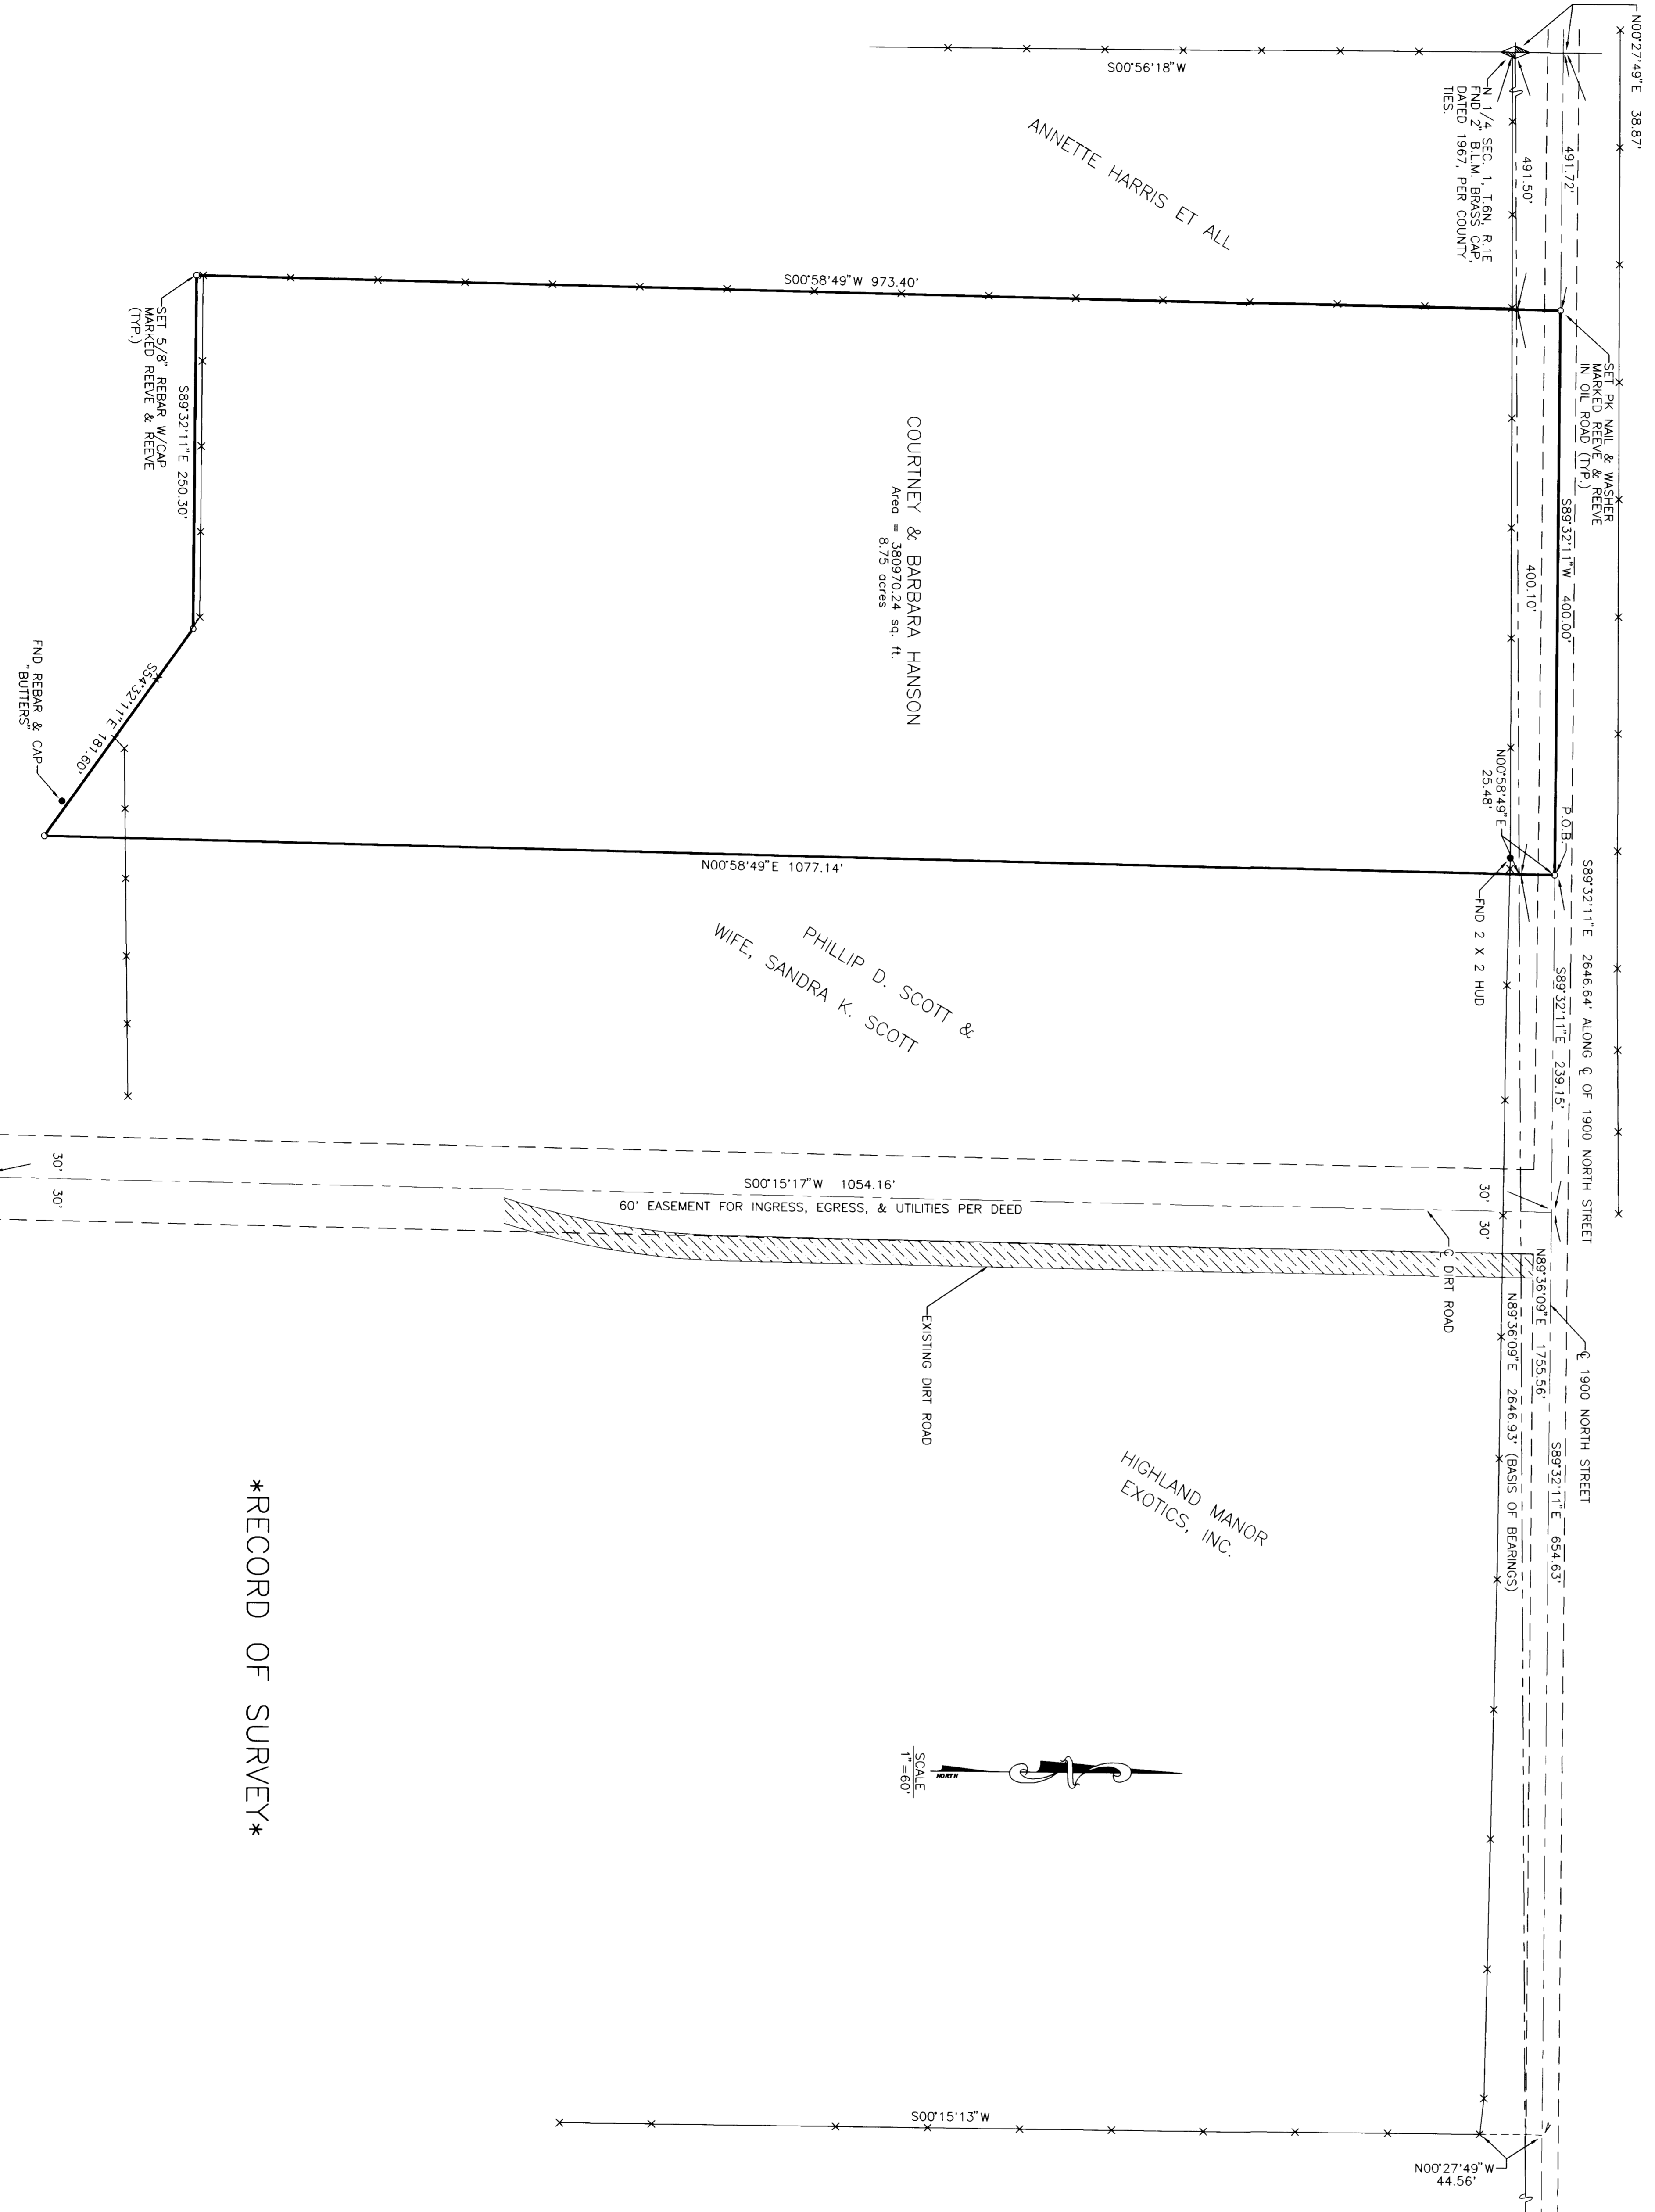

\*RECORD OF SURVEY\*

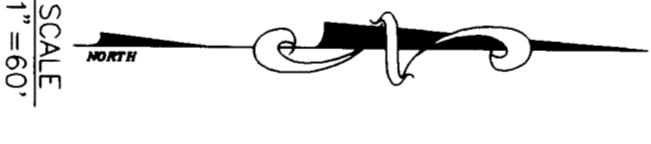

**BOUNDARY DESCRIPTION**

PART OF THE NE 1/4 OF SEC. 1, T.6N, R.1E, S.L.B. & M. DESCRIBED AS FOLLOWS:

1/4 AND RUNNING THENCE 589'32'11\" W 400.00 FEET ALONG SAID CENTERLINE; THENCE 500°58'49\" W 973.40 FEET ALONG A FENCE; THENCE 589'32'11\" E 250.30 FEET TO A FENCE; THENCE S54°32'11\" E 181.60 FEET ALONG SAID FENCE; THENCE N00°58'49\" E 1077.14 FEET TO THE POINT OF BEGINNING, CONTAINING 8.75 ACRES, MORE OR LESS.

**NARRATIVE**




**SURVEYOR'S CERTIFICATE**

I, JOHN P. REEVE, UTAH REGISTERED LAND SURVEYOR NO. 3492, DO HEREBY CERTIFY THAT THIS PLAT WAS PREPARED FROM A SURVEY MADE BY ME OR UNDER MY CLOSE PERSONAL SUPERVISION AND TO THE BEST OF MY KNOWLEDGE AND BELIEF IS TRUE AND CORRECT TO THE BEST OF MY KNOWLEDGE AND BELIEF.

SIGNED THIS \_\_\_\_\_ DAY OF \_\_\_\_\_ 19\_\_\_\_

UTAH LICENSE NUMBER  
SIGNATURE

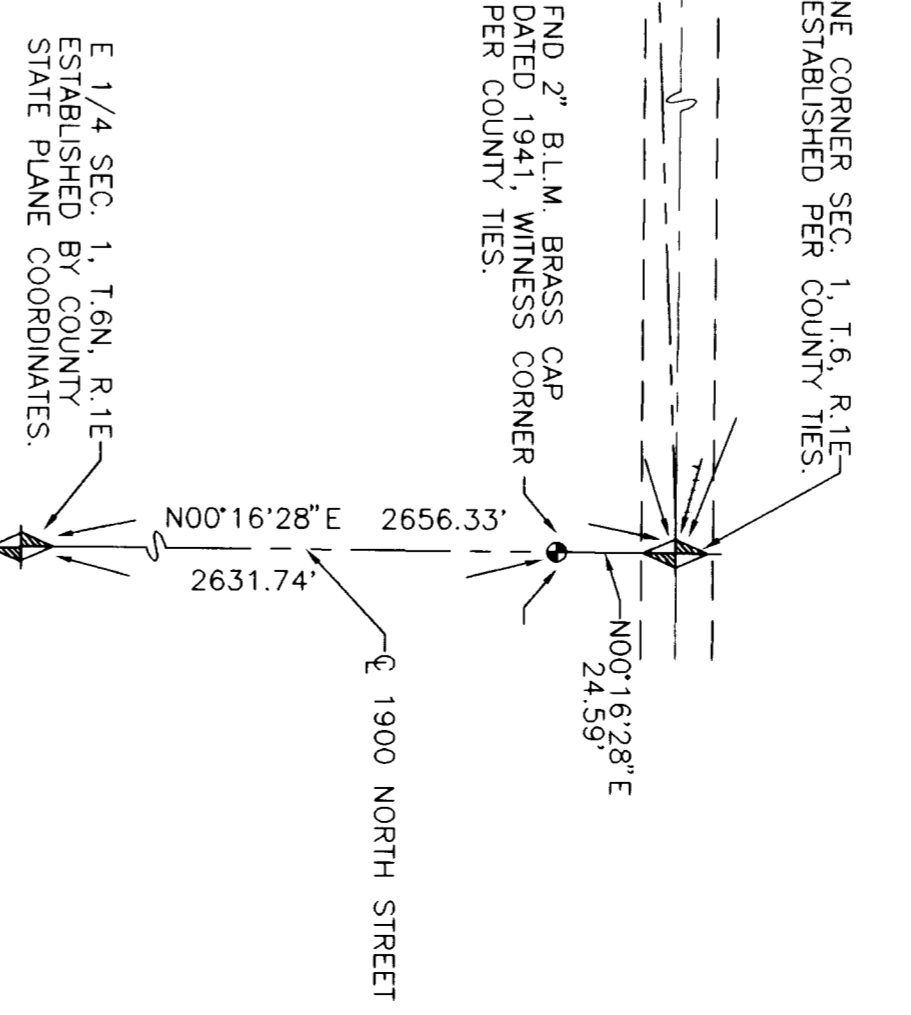

RECEIVED  
JUL 20 2008