


Washington Blvd.

2100 North Street


600 East Street

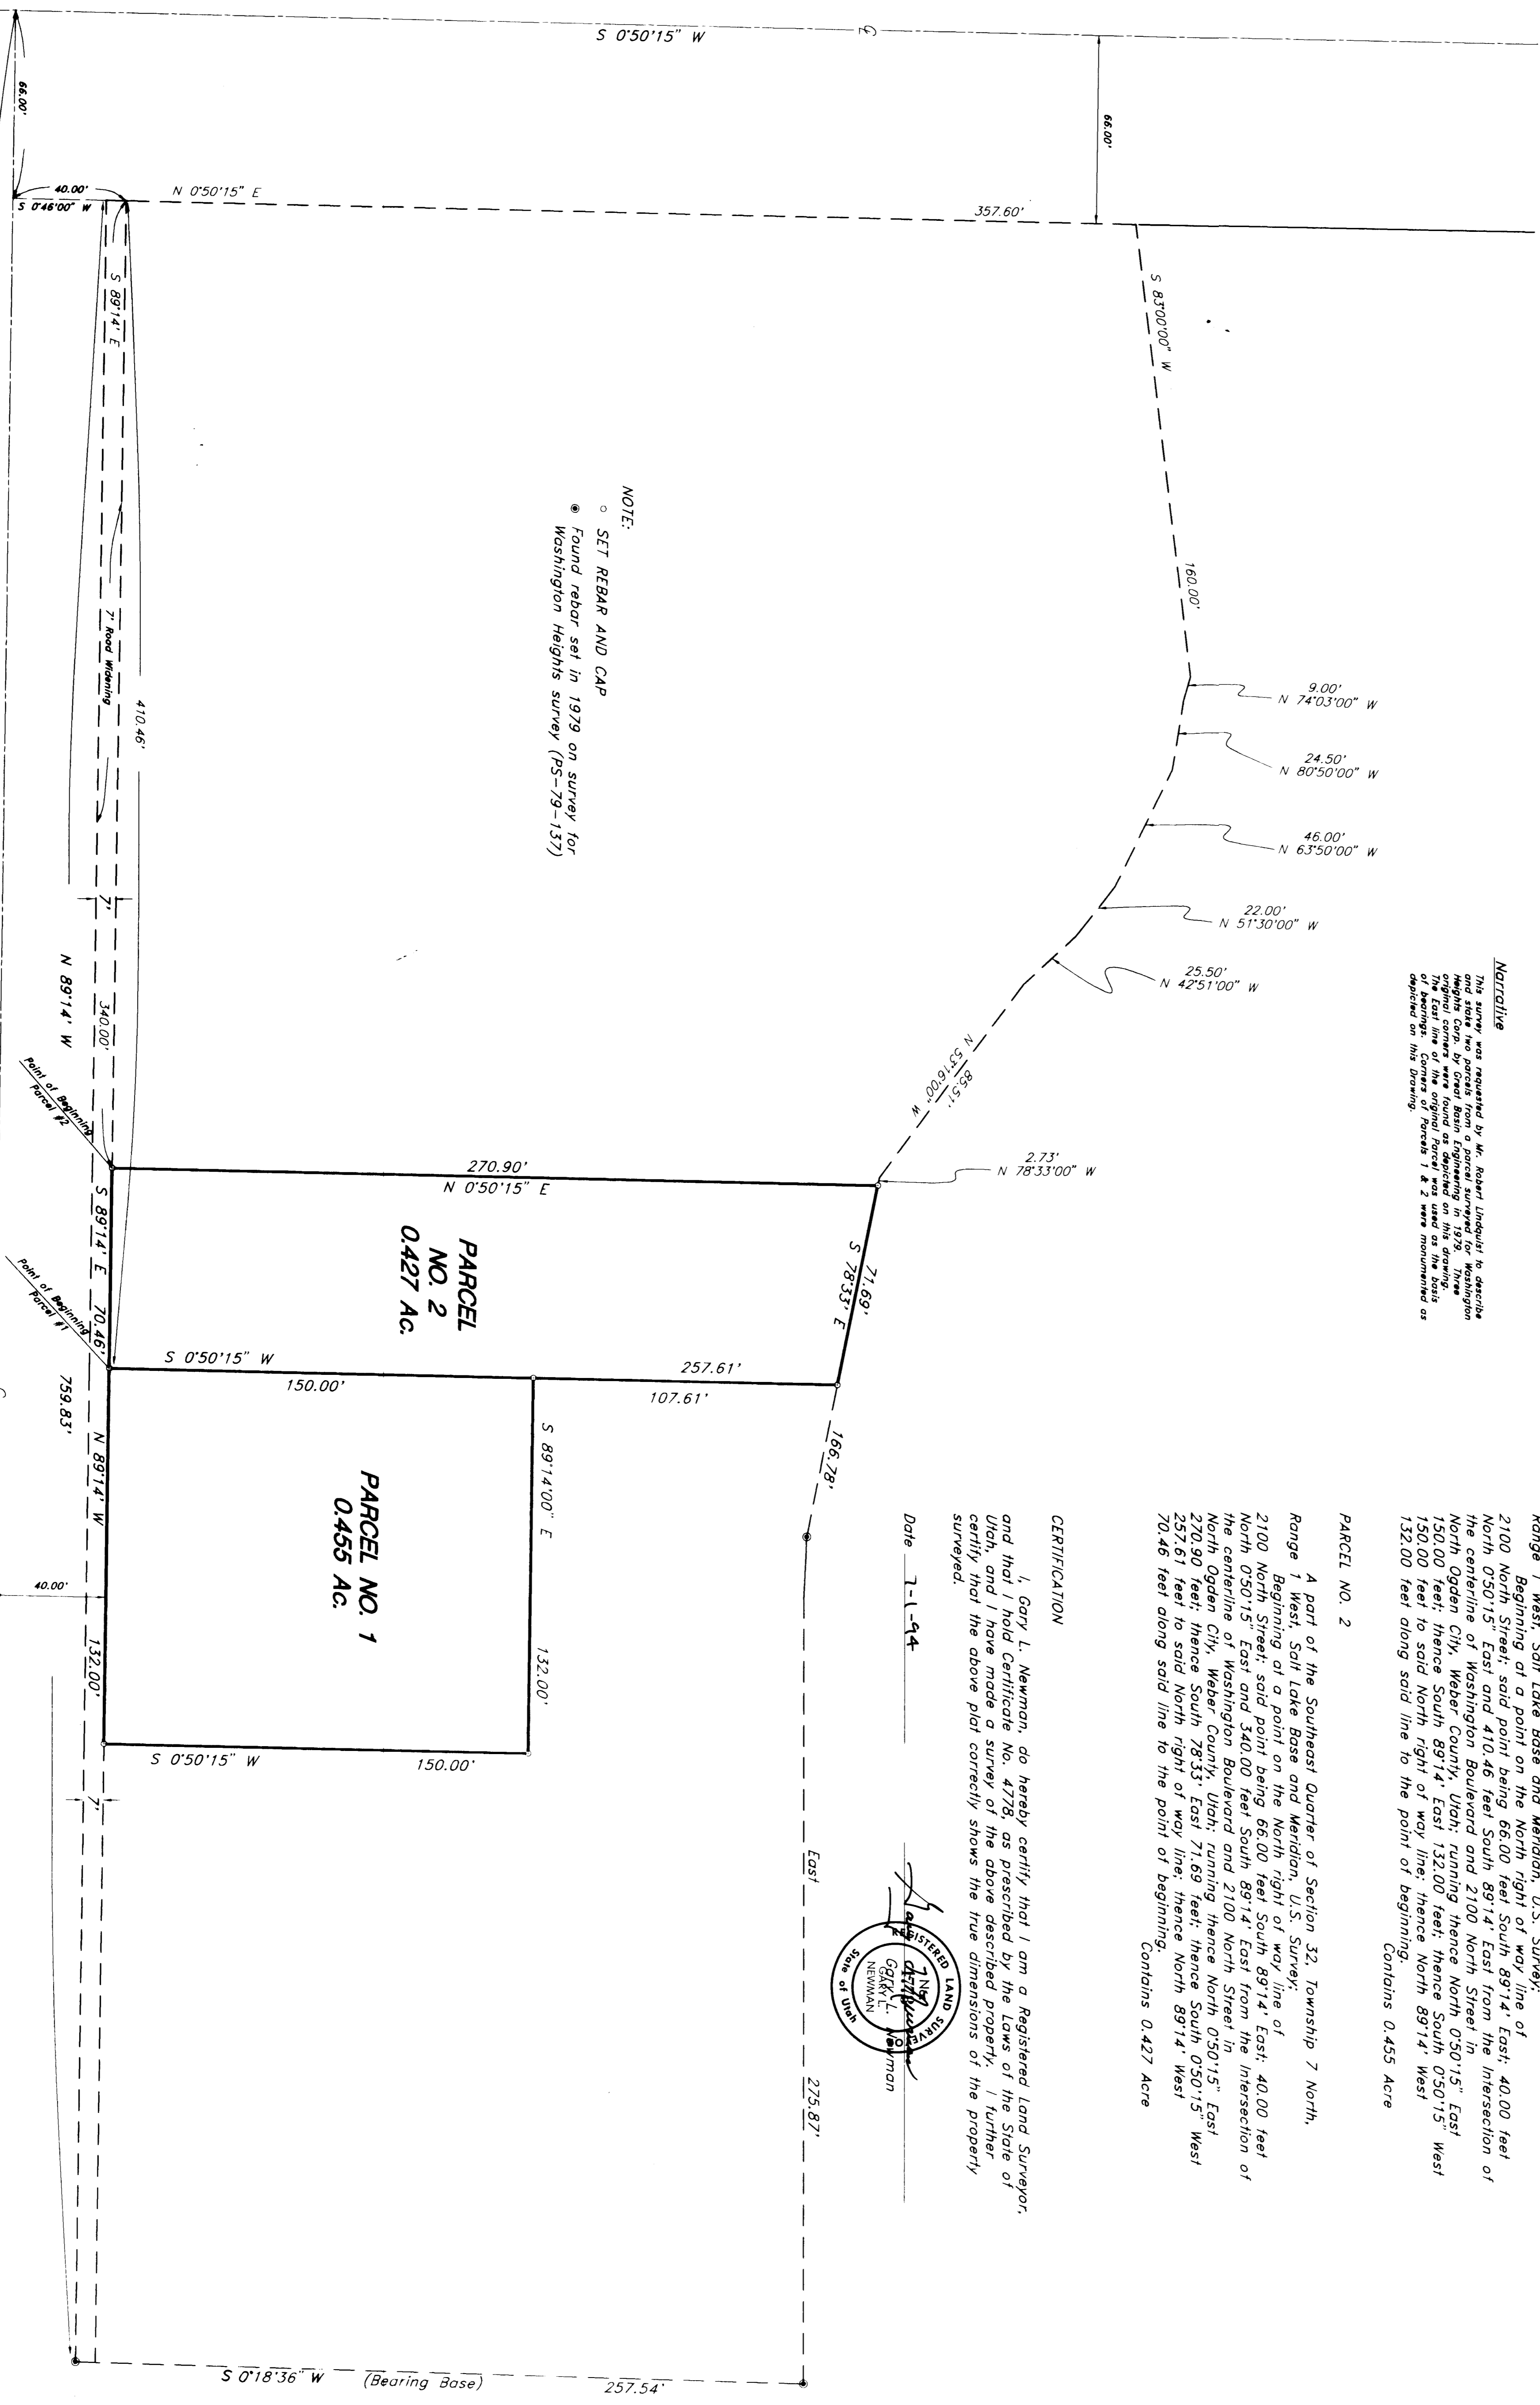

NOTE:
 SET REBAR AND CAP
 Found rebar set in 1979 on survey for
 Washington Heights survey (PS-79-137)



Date: 7-1-94

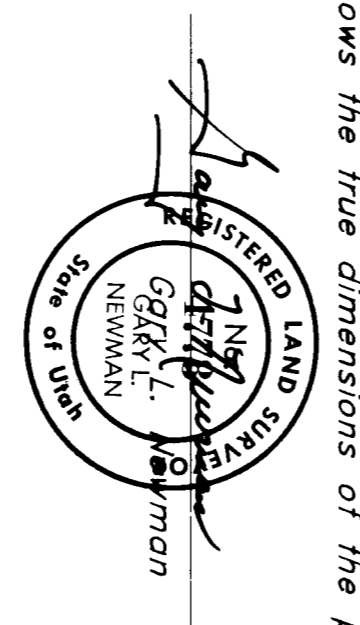

CERTIFICATION
 I, Gary L. Newman, do hereby certify that I am a Registered Land Surveyor,
 Utah, and I have made a survey of the above described property. Further,



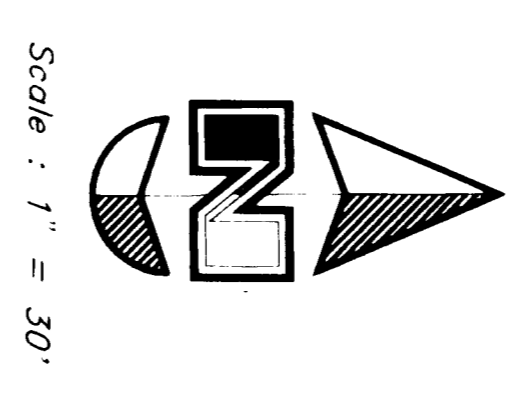

PROPERTY SURVEY
 For Robert Lindquist

GREAT BASIN ENGINEERING, INC.
 CONSULTING ENGINEERS AND SURVEYORS
 3574 Lincoln Avenue, Ogden, Utah 84401
 (801) 231-4411 Fax (801) 231-4422

DATE: 9 Jun, 1994
 DRAWN: MCB
 SCALE: 1" = 30'

REVISIONS:
 1. A part of the SE 1/4 of Section 32
 T7N, R1W, S12E & M

DRAWN BY: MCB
 DATE: 9 Jun, 1994

RECEIVED
 AUG 23 1994