MONSEN ENGINEERING CO 111561

DRAWING NUMBER 000107
PLAN HOLD CORPORATION • IRVINE, CALIFORNIA
REORDER BY NUMBER 07SAR
PRISMA LINE OF PRINT ON THIS LINE

DRAWING NUMBER 000107
PLAN HOLD CORPORATION • IRVINE, CALIFORNIA
REORDER BY NUMBER 07SAR
PRISMA LINE OF PRINT ON THIS LINE

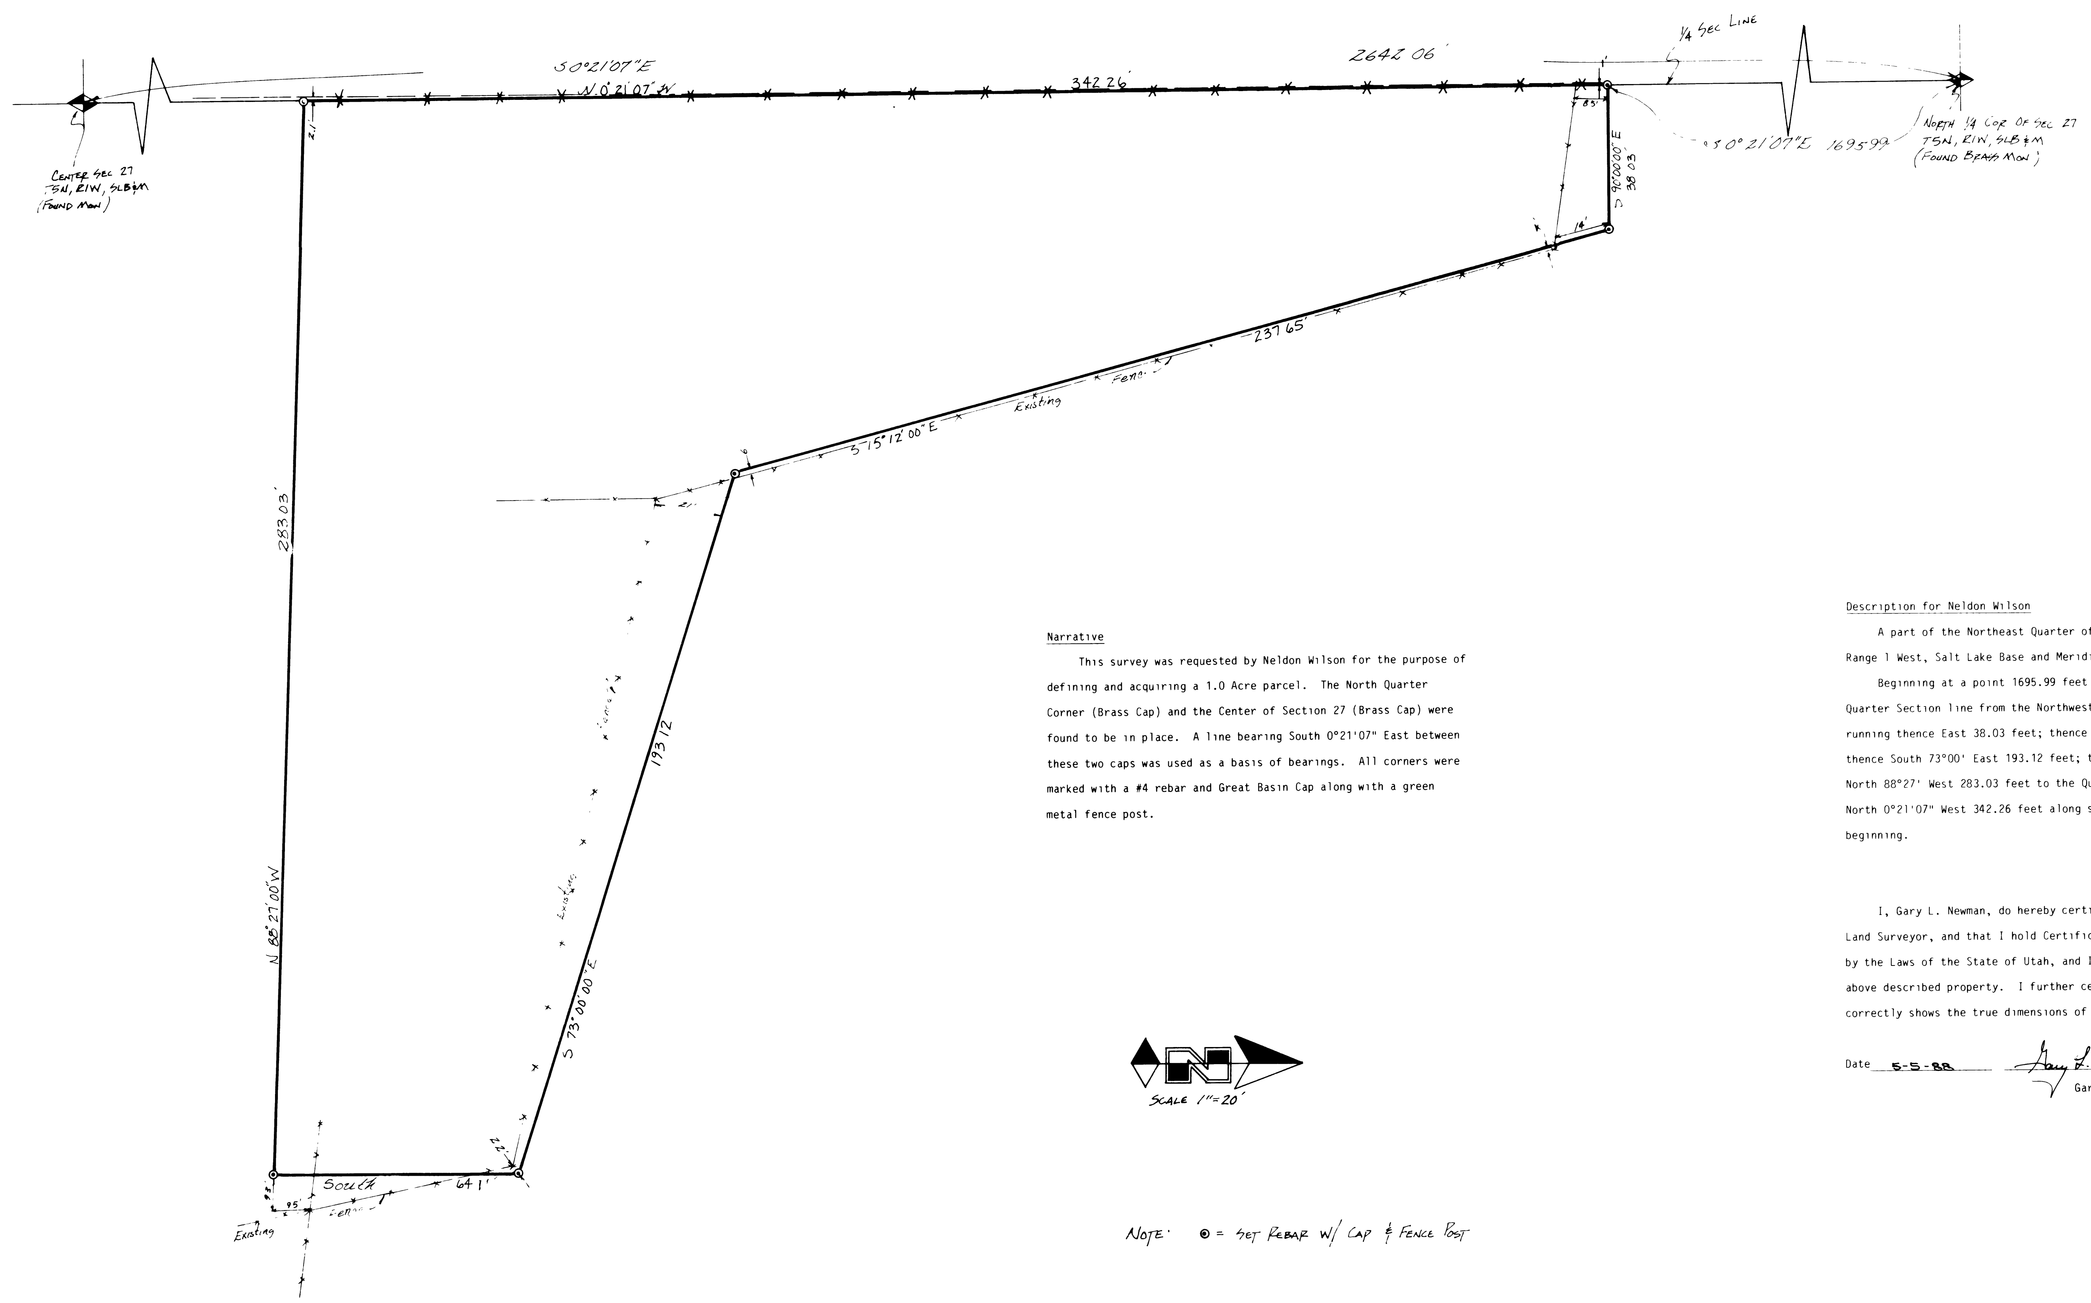

Narrative

This survey was requested by Neldon Wilson for the purpose of defining and acquiring a 1.0 Acre parcel. The North Quarter Corner (Brass Cap) and the Center of Section 27 (Brass Cap) were found to be in place. A line bearing South 0°21'07" East between these two caps was used as a basis of bearings. All corners were marked with a #4 rebar and Great Basin Cap along with a green metal fence post.

SCALE 1"=20'

NOTE: ⊙ = SET REBAR W/ CAP & FENCE POST

Description for Neldon Wilson

A part of the Northeast Quarter of Section 27, Township 5 North, Range 1 West, Salt Lake Base and Meridian, U.S. Survey

Beginning at a point 1695.99 feet South 0°21'07" East along the Quarter Section line from the Northwest corner of said Quarter Section, running thence East 38.03 feet; thence South 15°12' East 237.65 feet, thence South 73°00' East 193.12 feet; thence South 64.11 feet; thence North 88°27' West 283.03 feet to the Quarter Section line; thence North 0°21'07" West 342.26 feet along said line to the point of beginning.

Contains 1.00 Acre

I, Gary L. Newman, do hereby certify that I am a Registered Land Surveyor, and that I hold Certificate No. 4778, as prescribed by the Laws of the State of Utah, and I have made a survey of the above described property. I further certify that the above plat correctly shows the true dimensions of the property surveyed.

Date 5-5-88 Gary L. Newman

Gary L. Newman

REGISTERED LAND SURVEYOR No. 4778 GARY L. NEWMAN State of Utah

RECEIVED
JUN 11 1988
Weber County Surveyor

GREAT BASIN ENGINEERING, INC.
CONSULTING ENGINEERS & SURVEYORS
OGDEN & SALT LAKE CITY, UTAH

PROPERTY SURVEY
FOR
NELDON WILSON
A PART OF THE NE 1/4 OF SEC. 27, T5N, R1W

DRAWN MTM	CHECKED	APPROVED
DATE	SCALE	DWG. NO.