
Certified Supply 157


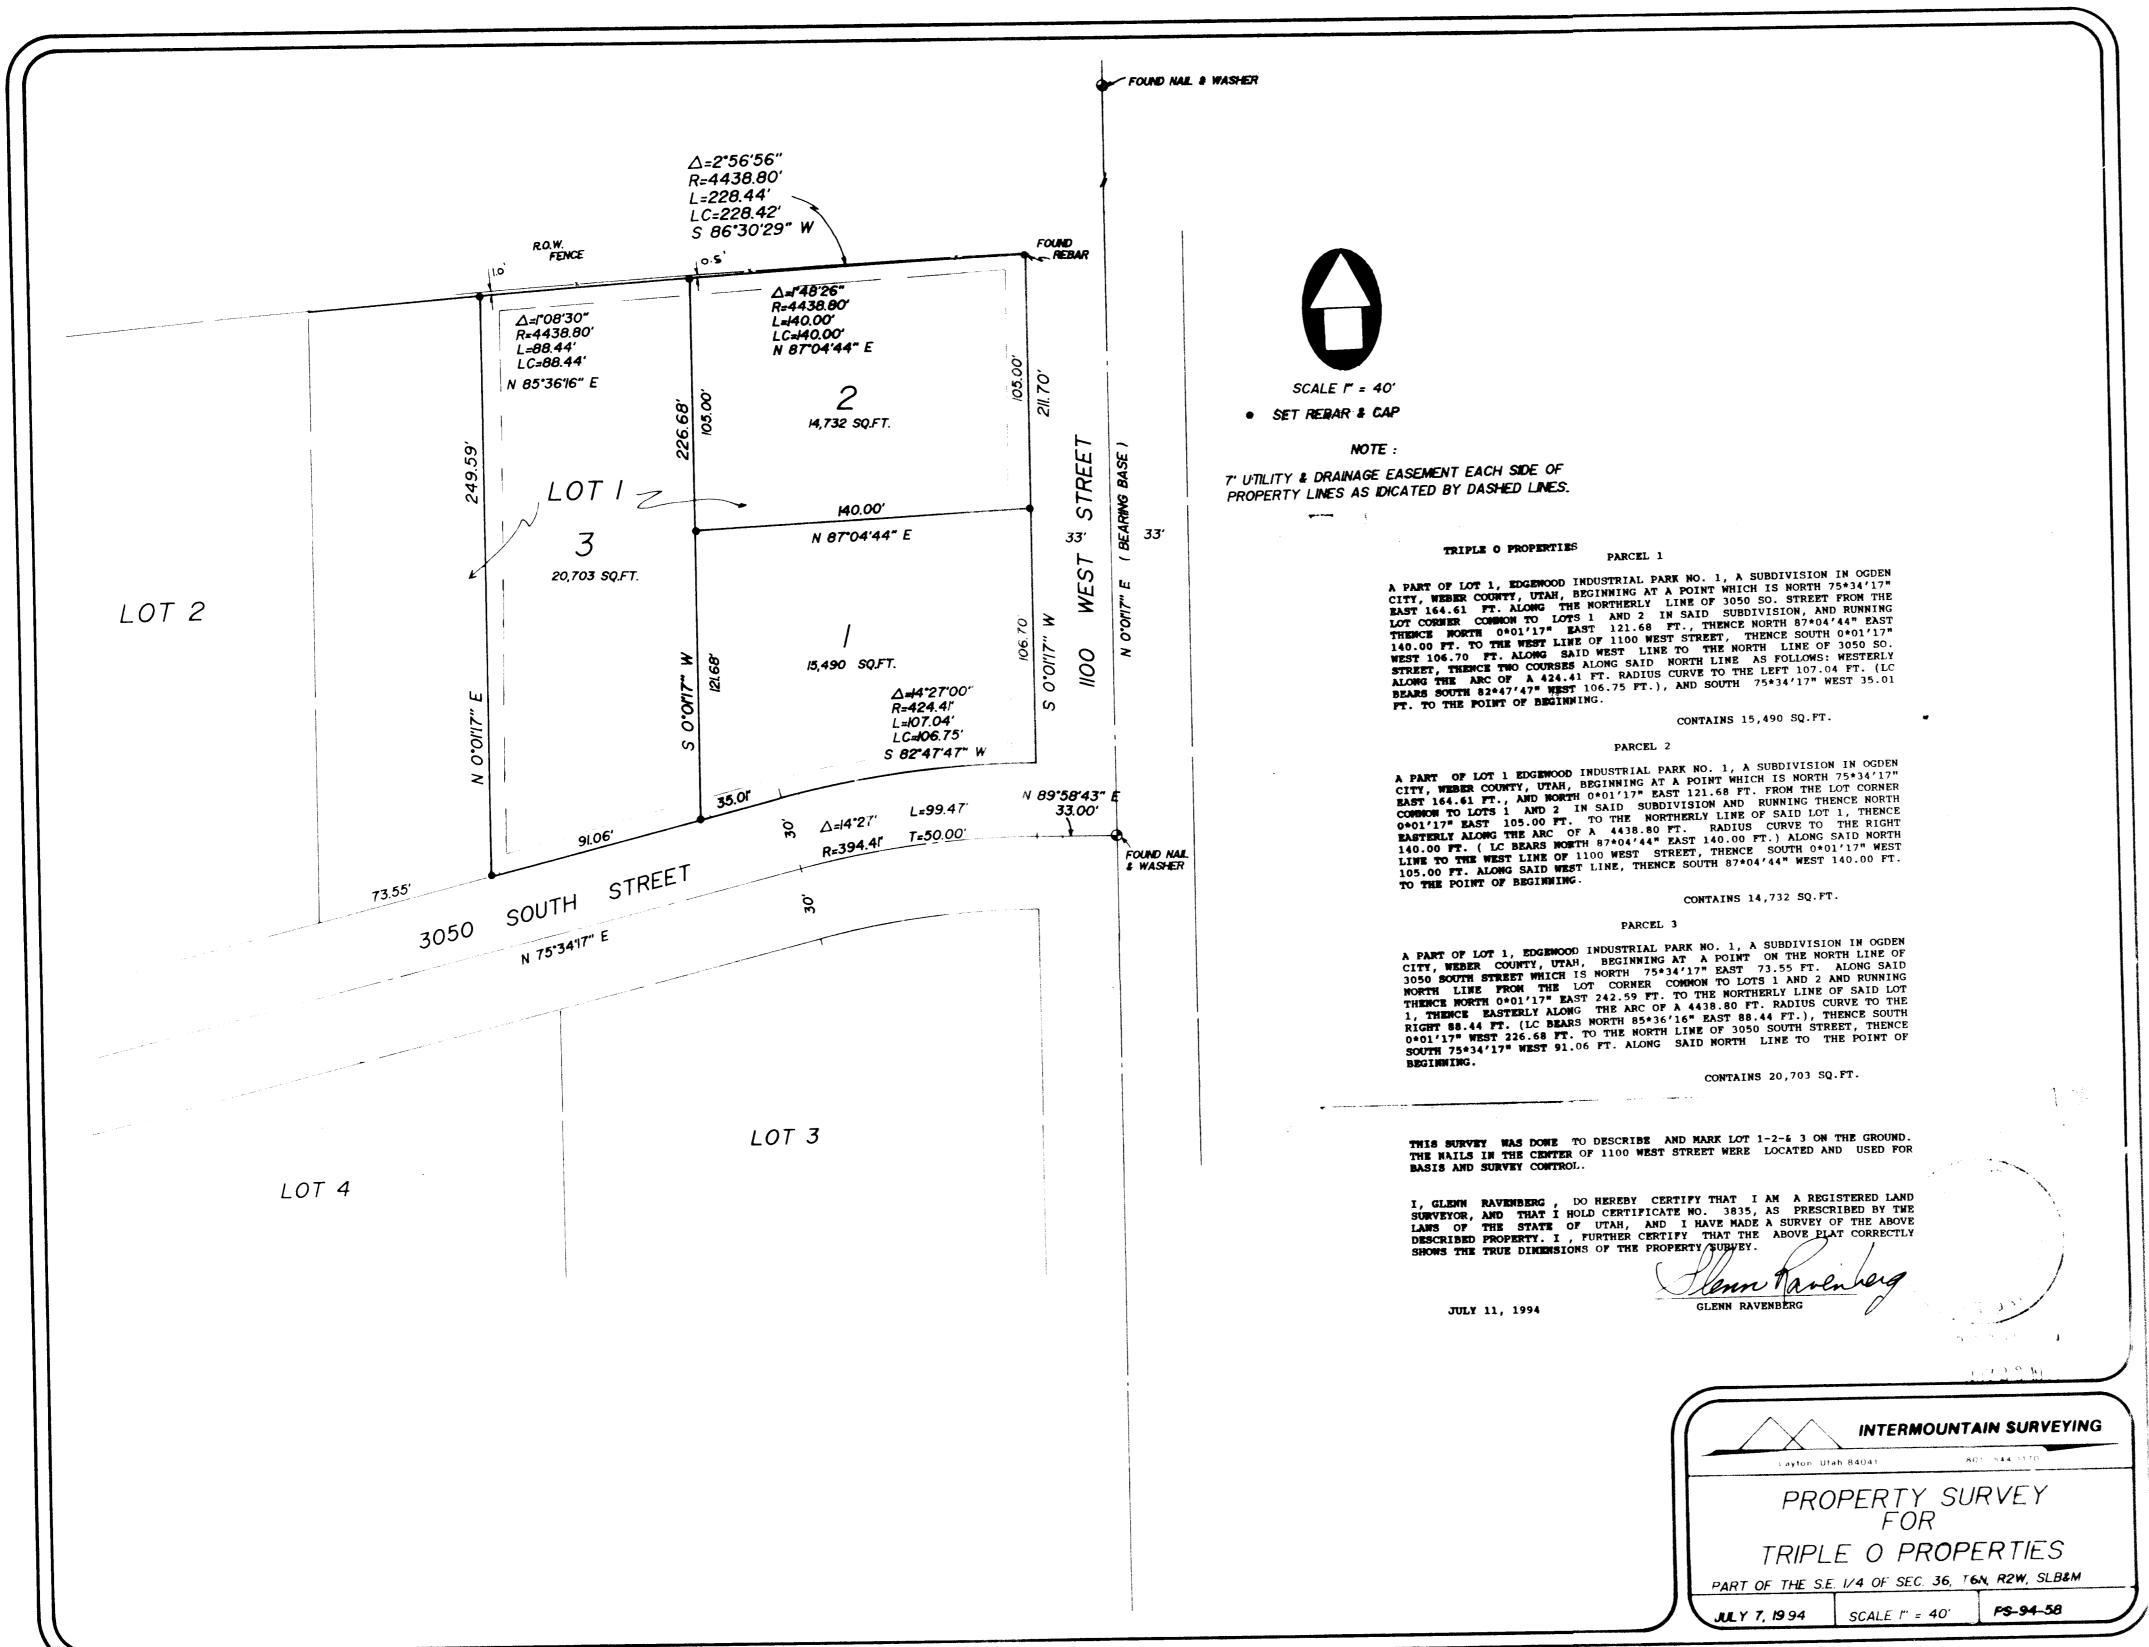

001081