

1	JULY 18, 1994	REVISION
2		
3		


PROJECT NO.		DESIGNED	
DATE	JULY 8, 1994	DRAWN	
SCALE	1"=100'	APPROVED	
		CHECKED	

REEVE & REEVE, INC.
CIVIL AND ENVIRONMENTAL ENGINEERING
LAND PLANNING & SURVEYING
SALT LAKE CITY, UTAH


RECORD OF SURVEY

CLIFFORD J. ORAM
JOHN PERRY SLATTER
PROPERTIES

SHEET	1
SHEETS	1

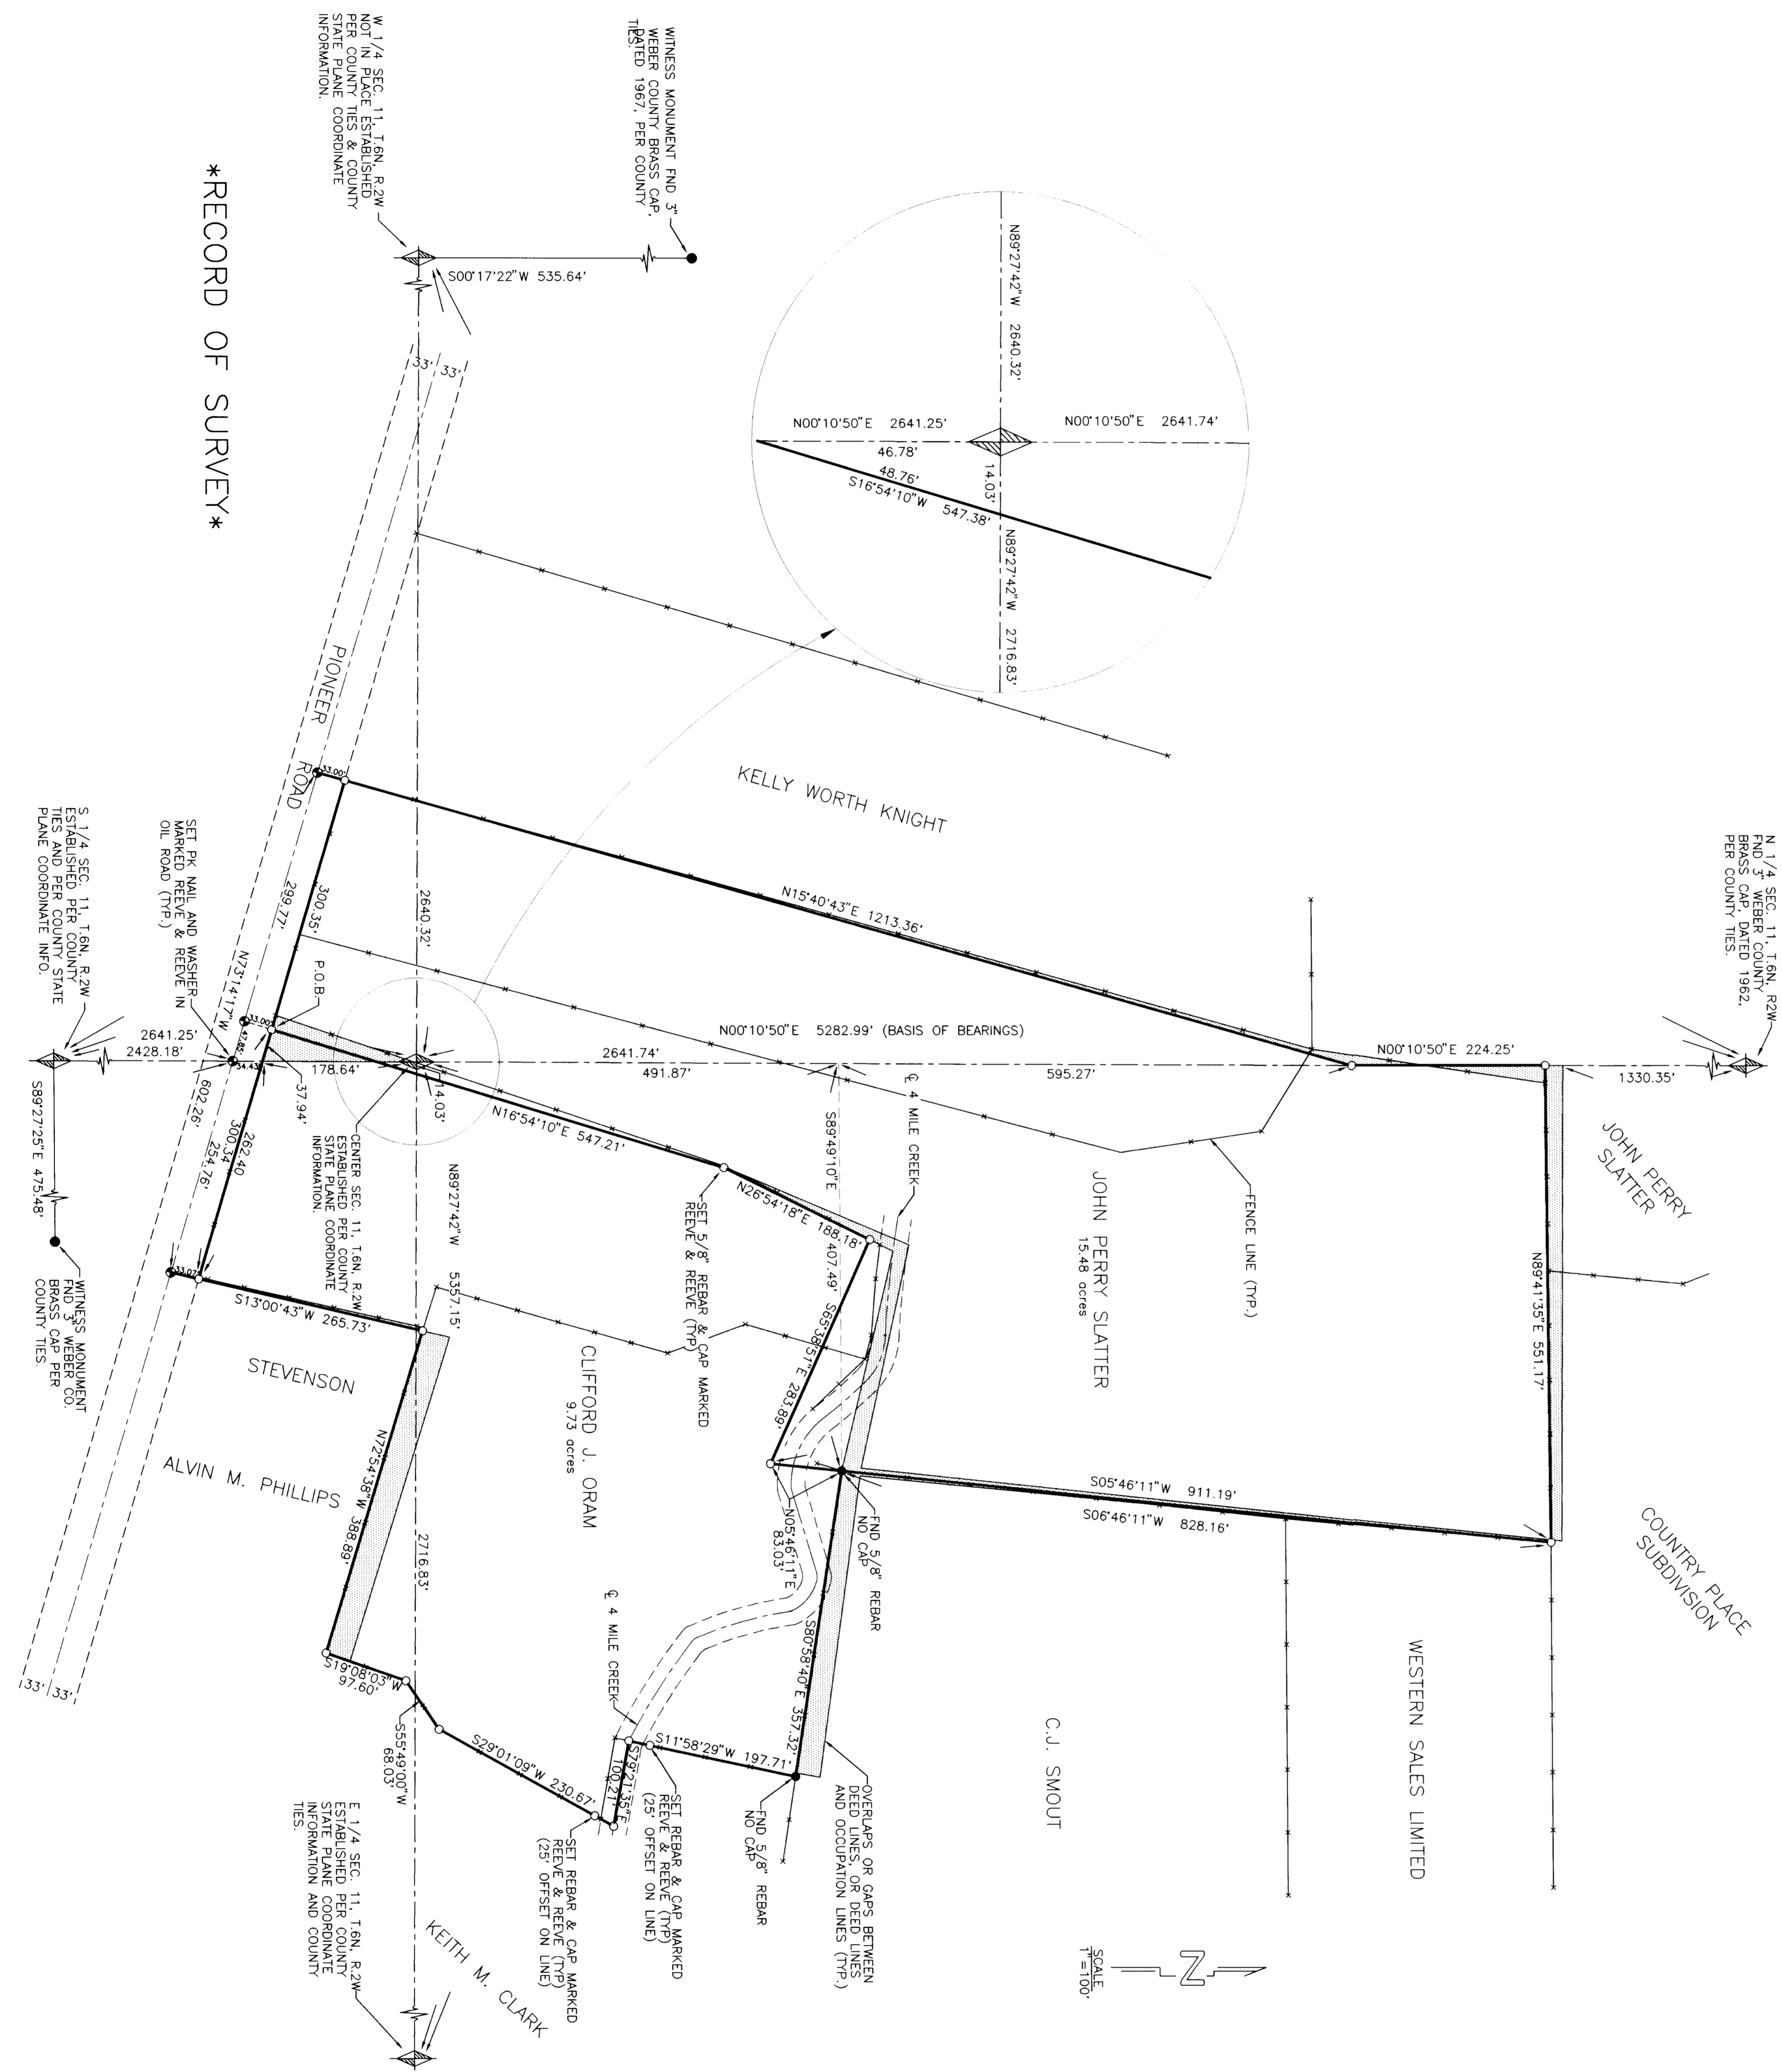

RECORD OF SURVEY

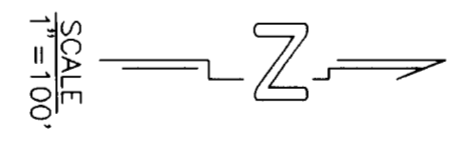

BOUNDARY DESCRIPTION

-CLIFFORD J. ORAM PARCEL-
PART OF SEC. 11, T.6N, R.2W, S.L.B. & M., DESCRIBED AS FOLLOWS:

-JOHN PERRY SLATTER PARCEL-
PART OF SEC. 11, T.6N, R.2W, S.L.B. & M., DESCRIBED AS FOLLOWS:

NARRATIVE



