DRAWING NUMBER 001100
PLAN HOLD CORPORATION • IRVINE, CALIFORNIA
RECORDER BY NUMBER 075AR

BOUNDARY DISCRIPTION

A PART OF THE SE 1/4 OF SEC. 18, T. 7N., R. 1E., S.L.B. & M. DESCRIBED AS FOLLOWS:

BEGINNING AT A POINT N 0°12'44" E, 1334.00 FEET ALONG THE SECTION LINE OF SAID SEC. 18 (BASIS OF BEARINGS N 89°58'29" W BETWEEN THE SE COR. OF SAID SEC. 18 AND THE WITNESS MON. TO SOUTH 1/4 COR. OF SAID SEC. 18), N 89°22'16" W 2649.33 FEET AND N 1°00'44" E 660.90 FEET FROM THE SE COR. OF SAID SEC. 18 AND RUNNING THENCE S 89°18'15" E, 1423.21 FEET; THENCE N 4°16'44" 117.18 FEET; THENCE N 0°50'44" E, 101.95 FEET; THENCE N 89°18'16" W, 1429.59 FEET; THENCE S 1°00'44" W, 218.90 FEET TO THE POINT OF BEGINNING.

SURVEYOR'S CERTIFICATE

I, JOHN P. REEVE, UTAH REGISTERED LAND SURVEYOR NO. 3492. DO HEREBY CERTIFY THAT THIS PLAT WAS PREPARED FROM A SURVEY MADE BY ME, OR UNDER MY SUPERVISION, ON THE GROUND AT THE REQUEST OF AND EXCLUSIVELY FOR GARY BILLS, AND ON BEHALF OF REEVE & REEVE INC. AND IS TRUE AND CORRECT TO THE BEST OF MY KNOWLEDGE AND BELIEF.

SIGNED THIS 7 DAY OF DEC, 1994

3492
UTAH LICENSE NUMBER

SIGNATURE

REGISTERED LAND SURVEYOR
22-146666-2201
JOHN P. REEVE
STATE OF UTAH

NARRATIVE

THE PURPOSE OF THIS SURVEY WAS TO VERIFY THE BOUNDARIES OF THIS PROPERTY. THE LINE BEARING N 89°58'29" W BETWEEN THE SE COR. OF SAID SEC. 18 AND THE WITNESS MON. TO SAID COR. WAS UTILIZED FOR THE BASIS OF BEARINGS.

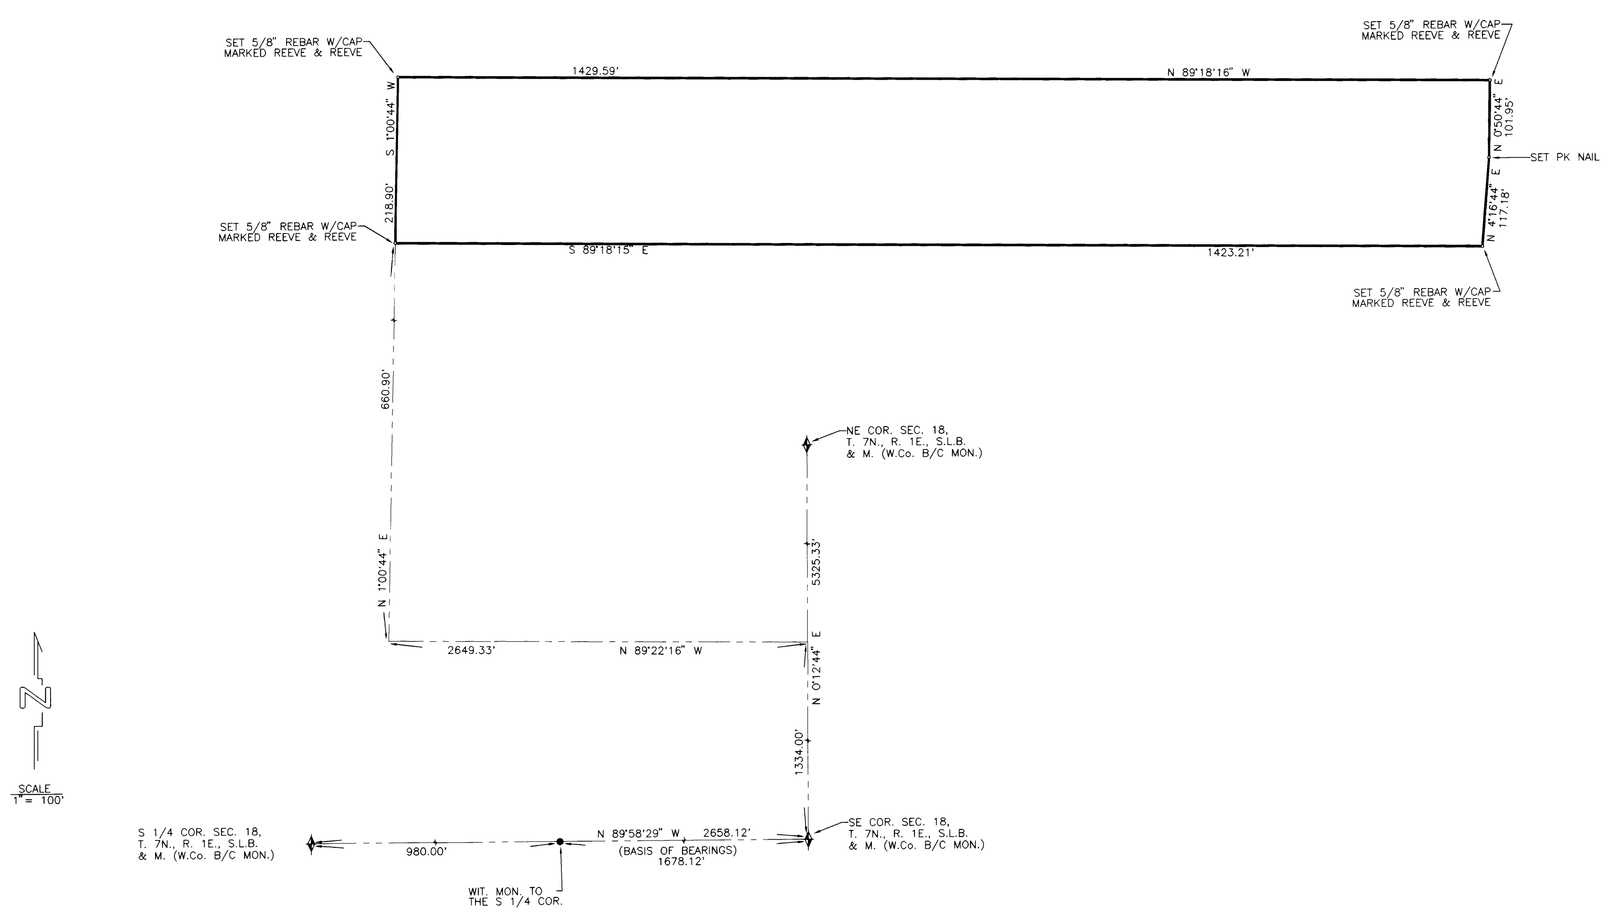

RECORD OF SURVEY

REEVE & REEVE, INC.
CIVIL AND ENVIRONMENTAL ENGINEERING
LAND PLANNING AND SITE DESIGN
LAND SURVEYING
OGDEN, UTAH

0 2 1994

R&R	REVISIONS 1. 1-21-94 2. 3. 4. 5. 6.	PROJECT NO. DATE 1-10-94 SCALE 1" = 100'	DESIGNED DRAWN T.W. APPROVED	REEVE & REEVE, INC CIVIL AND ENVIRONMENTAL ENGINEERING LAND PLANNING AND SITE DESIGN LAND SURVEYING OGDEN, UTAH	RECORD OF SURVEY	GARY BILLS PROPERTY	SHEET SHEETS

001100