



1. REVISIONS
2. _____
3. _____
4. _____
5. _____


PROJECT NO. _____
DATE: 12/22/14
SCALE: 1"=100'
ISSUED: _____
DRAWN: _____
APPROVED: _____

REEVE & REEVE, INC.
CIVIL AND ENVIRONMENTAL ENGINEERING
LAND PLANNING AND SITE DESIGN
LAND SURVEYING
COPDEN, UTAH

RECORD OF SURVEY


JANE RENSTROM
PROPERTY

SHEET 1
SHEETS 1

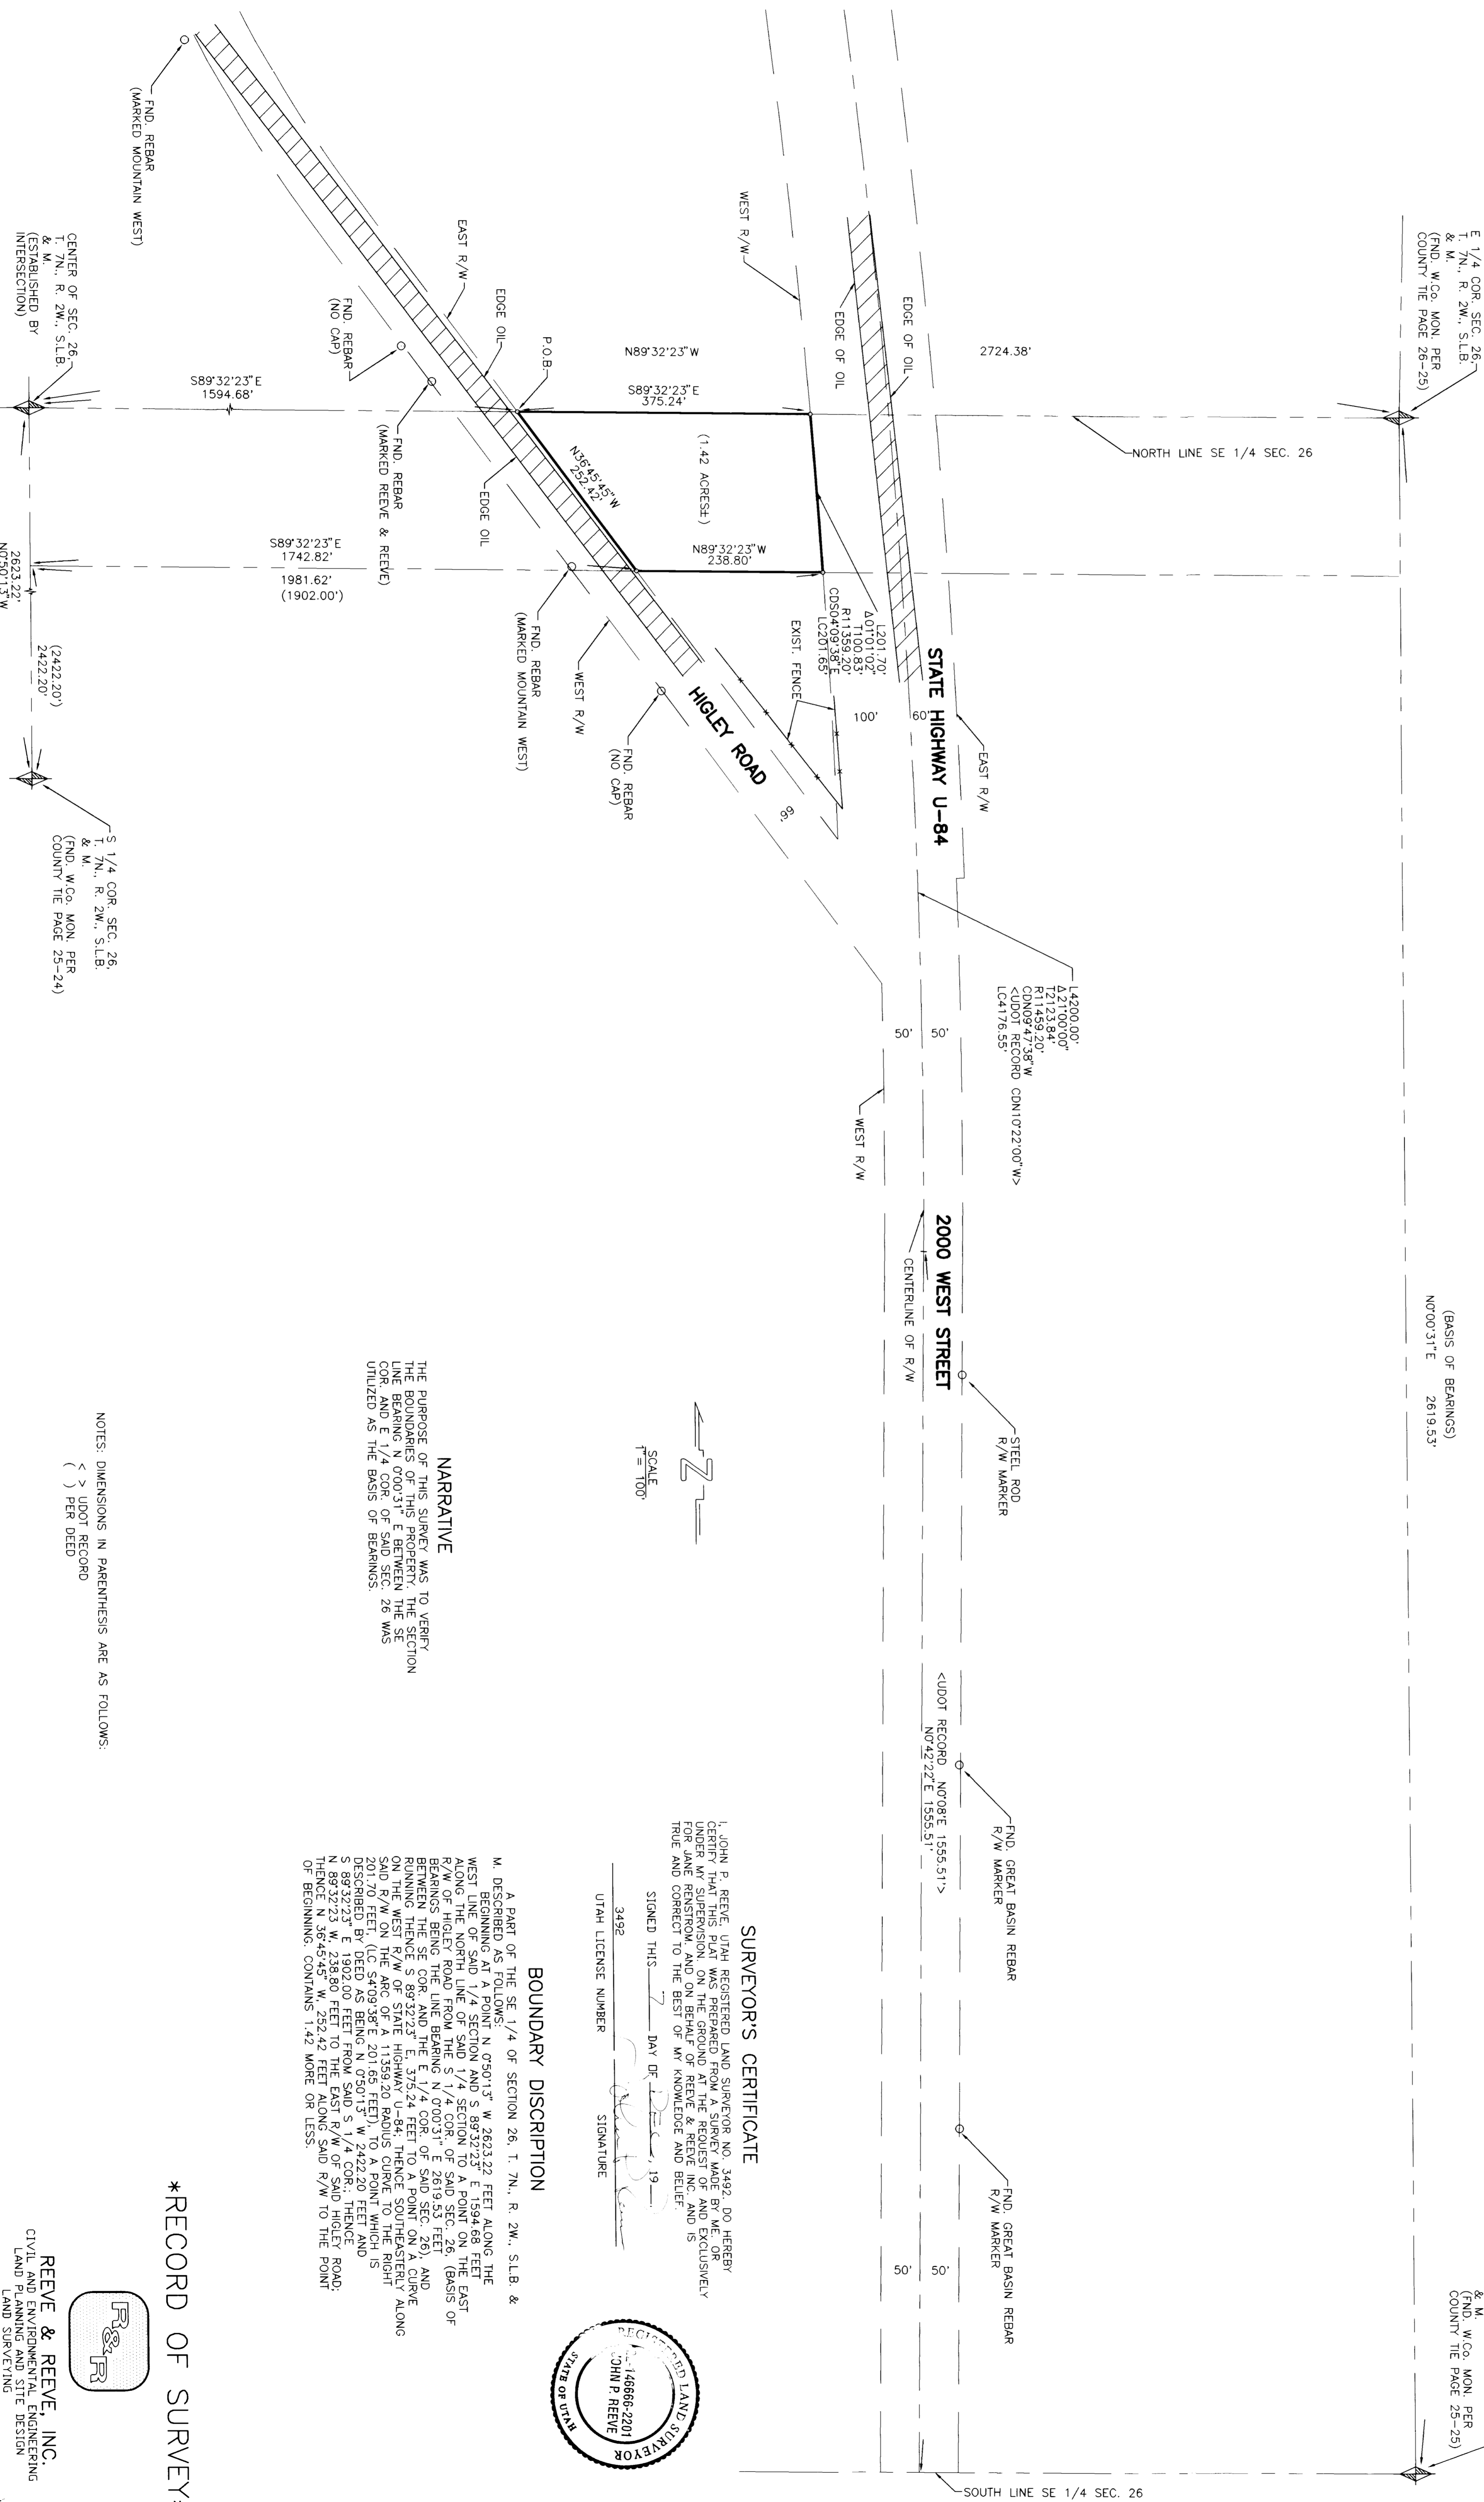

NOTES: DIMENSIONS IN PARENTHESES ARE AS FOLLOWS:


RECORD OF SURVEY

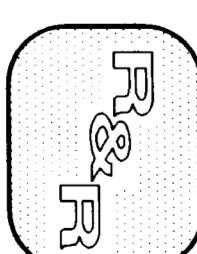

REEVE & REEVE, INC.
CIVIL AND ENVIRONMENTAL ENGINEERING
LAND PLANNING AND SITE DESIGN
LAND SURVEYING
COPDEN, UTAH

NARRATIVE
THE PURPOSE OF THIS SURVEY WAS TO VERIFY THE BOUNDARIES OF THE PROPERTY THE SECTION CORNER AND E 1/4 CORNER OF SAID SEC. 26 WAS UTILIZED AS THE BASIS OF BEARINGS.
BOUNDARY DISCRIPTION
A PART OF THE SE 1/4 OF SECTION 26, T. 7N., R. 2W., S.L.B. & M. DESCRIBED AS FOLLOWS:


SURVEYOR'S CERTIFICATE
SIGNED THIS _____ DAY OF _____, 19____
UTAH LICENSE NUMBER 3482

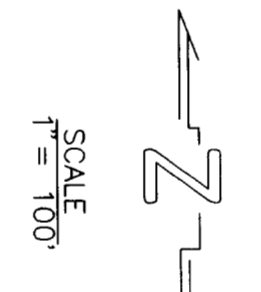

(BASIS OF BEARINGS)

SE COR. SEC. 26,
T. 7N., R. 2W., S.L.B.
(FND. W.CO. MON. PER
COUNTY THE PAGE 25-25)

SOUTH LINE SE 1/4 SEC. 26