DRAWING NUMBER
001105

DRAWING NUMBER
001105

DRAWING NUMBER
001105

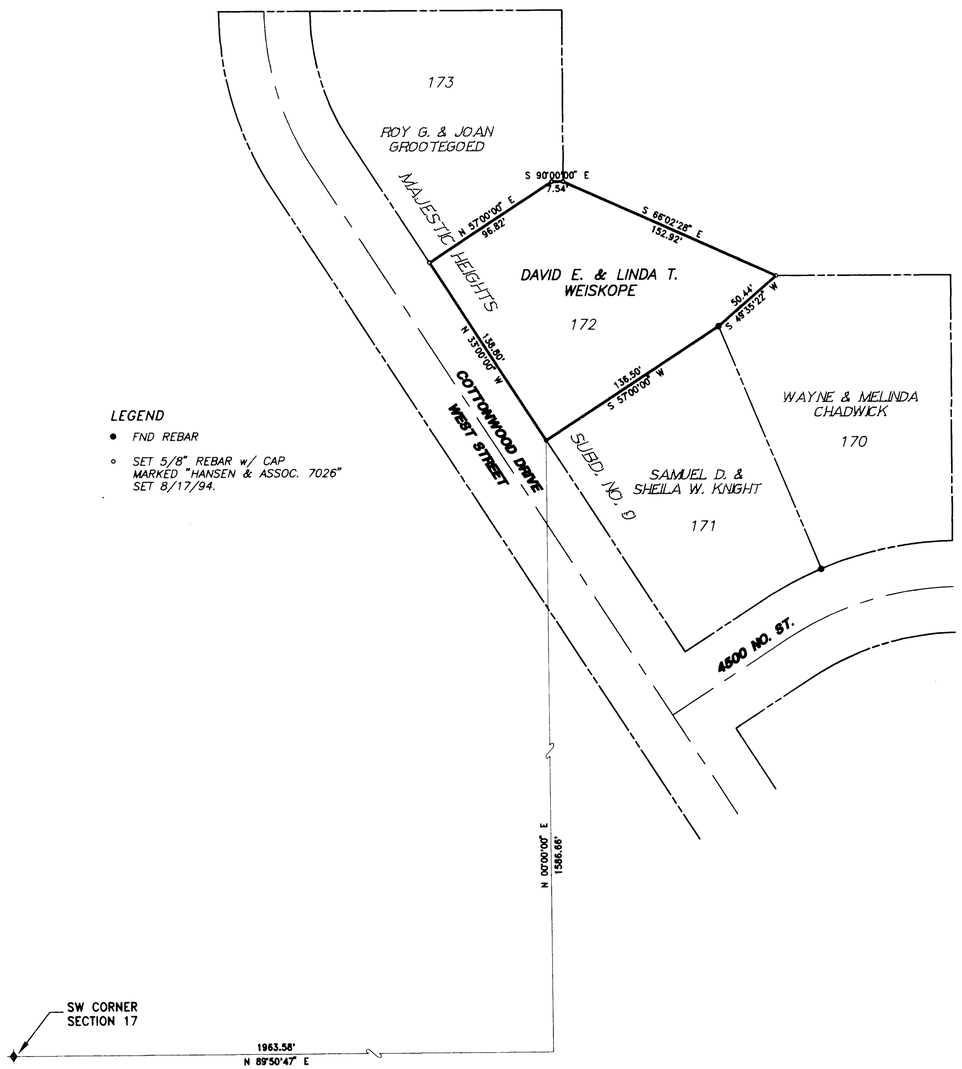

LEGEND

- ● FND REBAR
- ○ SET 5/8" REBAR w/ CAP MARKED "HANSEN & ASSOC. 7026" SET 8/17/94.

SCALE: 1" = 50'

SURVEY CERTIFICATE

I, K. Greg Hansen, do hereby certify that I am a Registered Land Surveyor, and that I hold Certificate No. 167819 as prescribed by the Laws of the State of Utah, and that I have made and/or Supervised the survey of the property shown and described hereon and that this plat is a true and correct representation of said survey to the best of my knowledge and belief.

K. Greg Hansen, R.L.S. No. 167819 — date 12/9/94

REGISTERED LAND SURVEYOR 167819 2001 K. GREG HANSEN STATE OF UTAH

PROPERTY DESCRIPTION

PART OF THE SW 1/4 OF SECTION 17, TOWNSHIP 7 NORTH, RANGE 1 WEST, S.L.B.&M.
LOT 172 OF MAJESTIC HEIGHTS SUBDIVISION NO. 9.

NARRATIVE

THE PURPOSE OF THIS SURVEY WAS TO ESTABLISH AND SET THE PROPERTY CORNERS OF THE PARCEL AS SHOWN HEREON. THE SURVEY WAS ORDERED BY DAVID WEISKOPE. THE CONTROL USED WAS THE PROPERTY LINE THAT BEARS NORTH 22°28'45" WEST BETWEEN LOTS 170 AND 171 OF MAJESTIC HEIGHTS SUBDIVISION NO. 9.

RECEIVED
DEC 28 1994

No.	Date	By	Revision

HANSEN & ASSOCIATES, INC.
Consulting Engineers and Land Surveyors
538 North Main, Brigham City, Utah 84302
Brigham City 723-3481 · Ogden 399-4805 · Logan 752-8272

Drawn By: MO Date: 8/29/94
Designed By:
Checked By: KGH
Approved By:
Scale: 1" = 50'
JOB NUMBER: 94-3-102

PROPERTY SURVEY FOR
DAVID WEISKOPE
PLEASANT VIEW, UTAH
A PART OF THE SOUTHWEST QUARTER OF SECTION 17, T7N, R1W, S.L.B.&M.

SHEET 1 OF 1 SHEETS

001105