DRAWING NUMBER

001115

PLAN HOLD CORPORATION • IRVINE, CALIFORNIA

DRAWING NUMBER

001115


PLAN HOLD CORPORATION • IRVINE, CALIFORNIA

001115

DRAWING NUMBER

601115

PLAN HOLD CORPORATION - IRVINE, CALIFORNIA

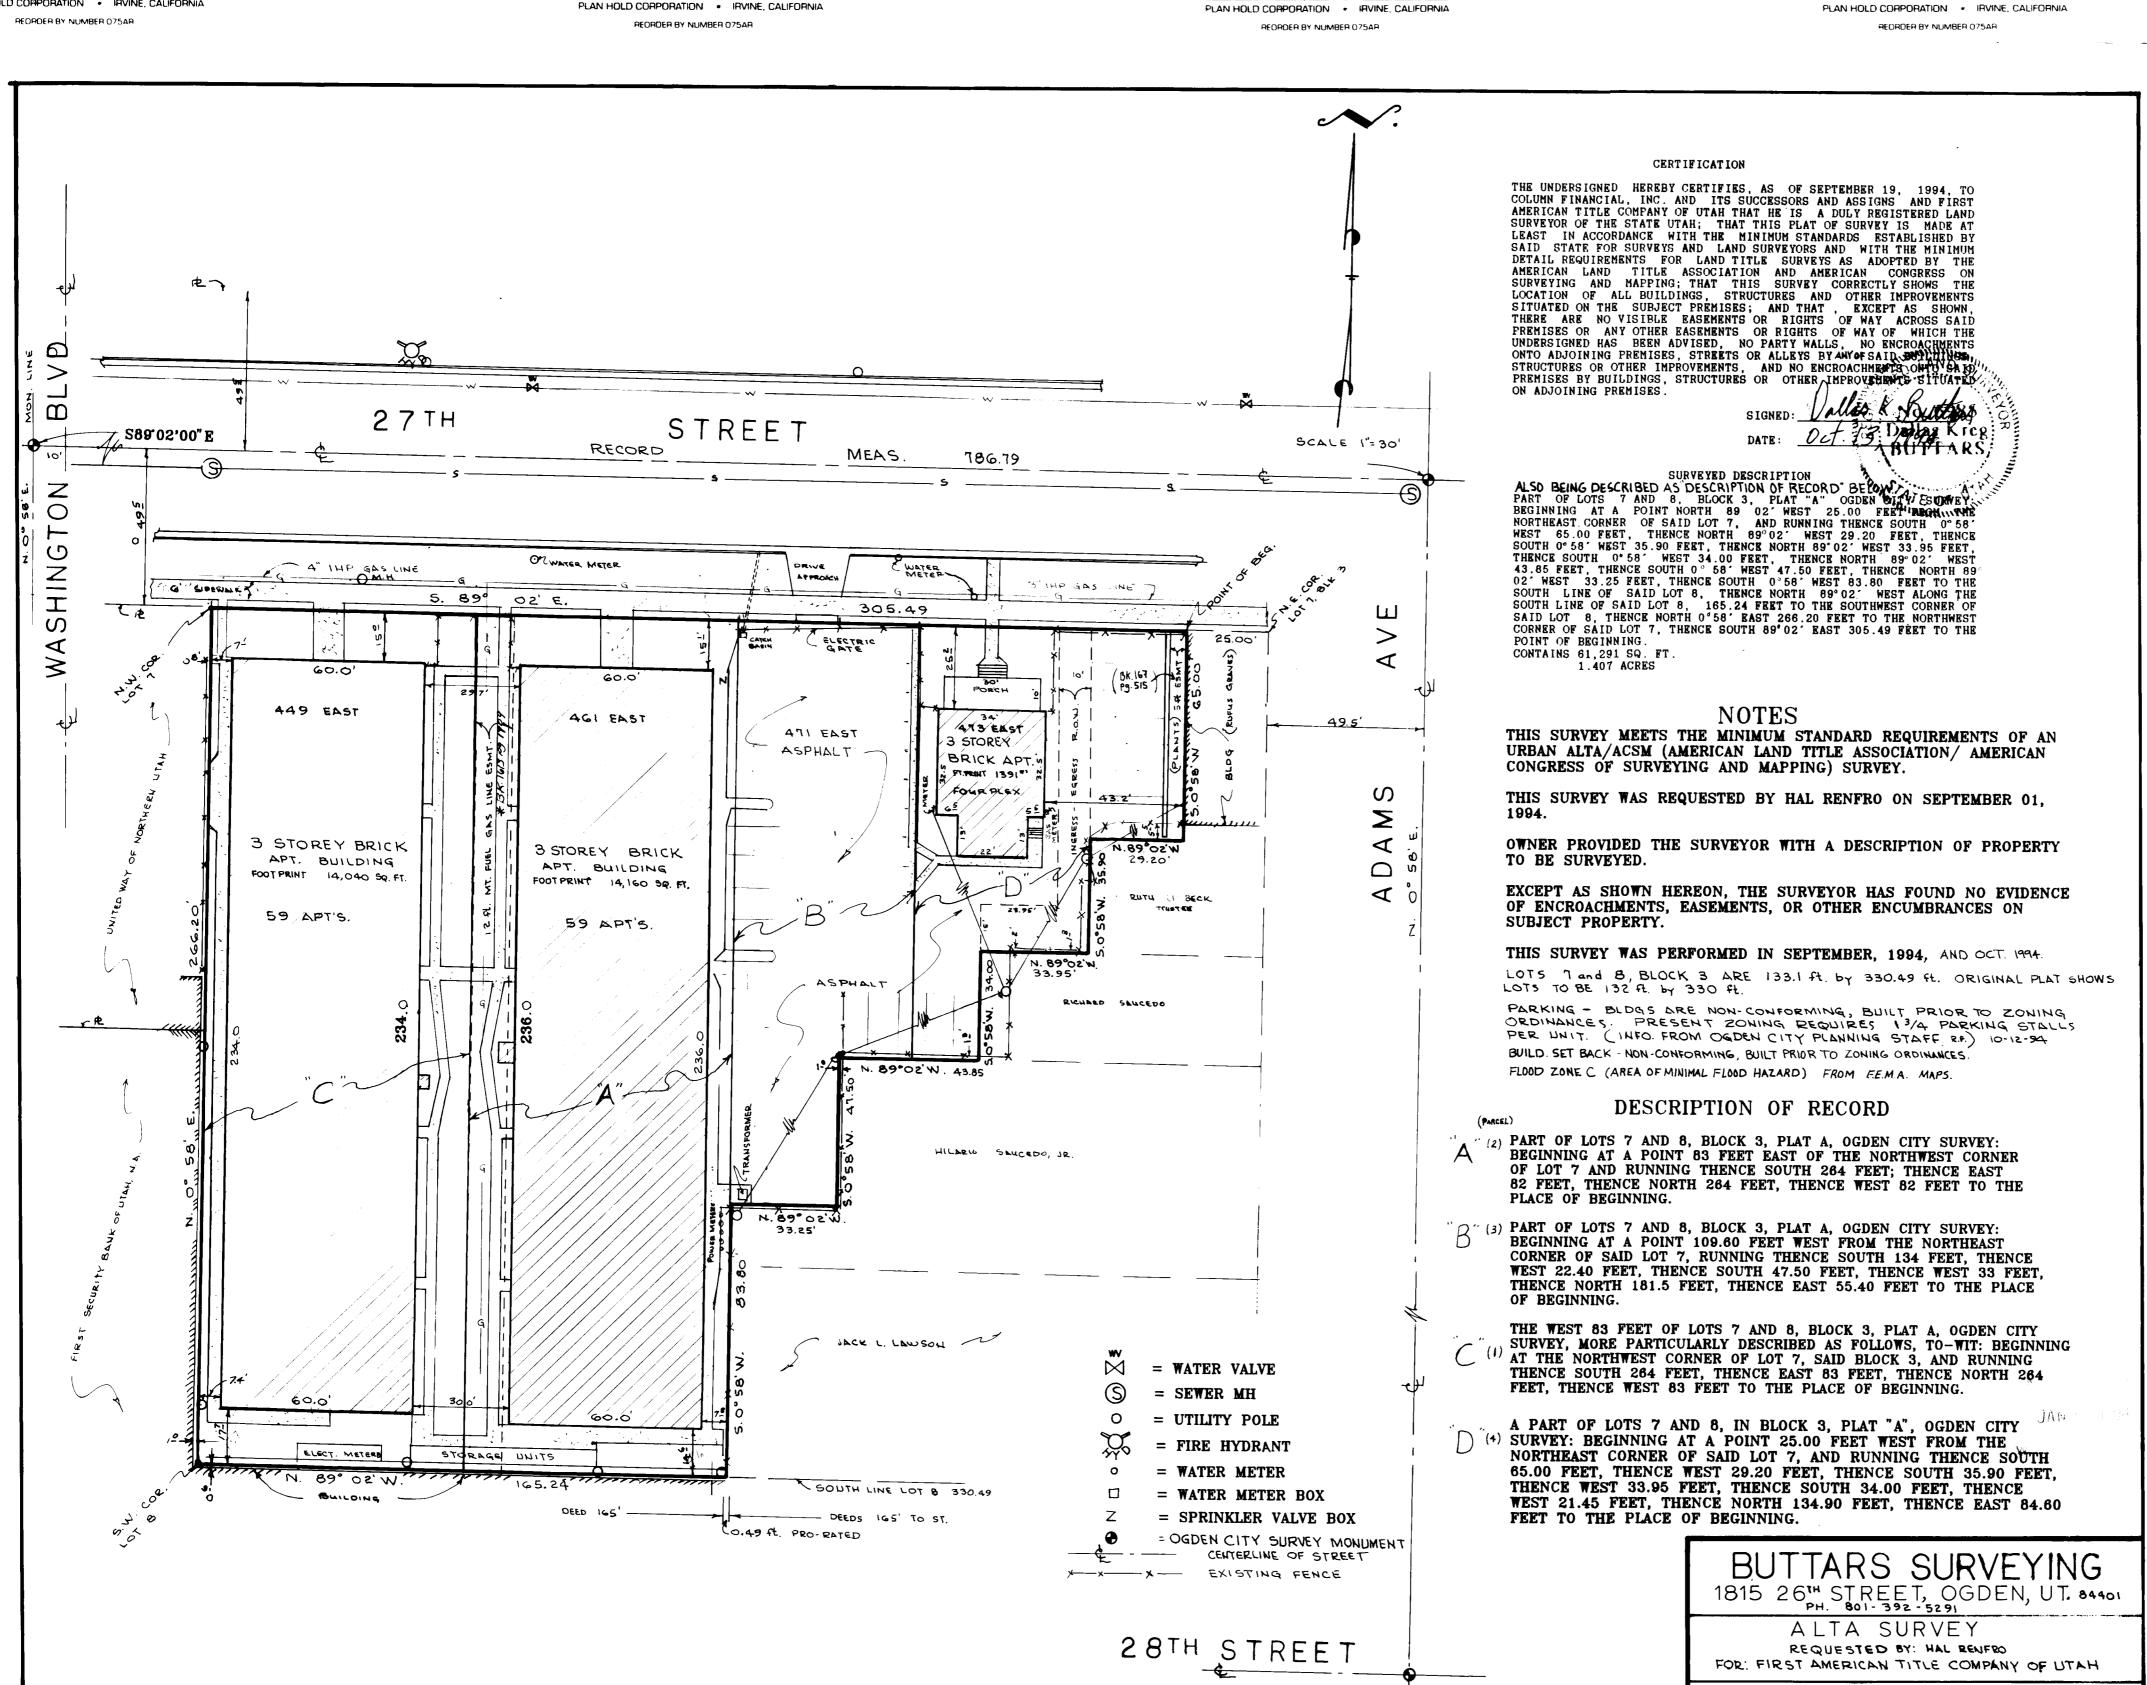

LOCATED IN N.W. 1/4 SEC. 33, T.GN., R.IW, S.L.B. & M.

OGDEN CITY, WEBER COUNTY, UTAH

REVISED 10-13-94