


SURVEYORS CERTIFICATE

I, Larry M. Buttars, a registered Land Surveyor as prescribed by the laws of the State of Utah, and holding license No. 2596 do hereby certify that I made a survey of the below described property and the Plat hereon is a true and correct representation of said survey.

Date: 8-25-94 Sign: *Larry M. Buttars*

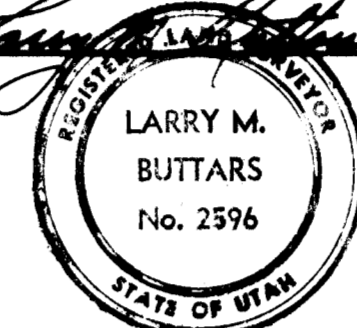

DESCRIPTION

All of Lot 21, Ogden Canyon Wildwood Estates Subdivision, Weber County, Utah, according to the official plat thereof.

NARRATIVE

This survey was requested by O. C. Record to re-establish the corners of Lot 21. The bearing base used is from the recorded subdivision plat and re-locating corners of lots 17 and 19.

LEGEND

- Set 3/8" x 24" re-bar with plastic cap stamped L. Buttars R.L.S. 2596
- Set P.K. nail with ribbon

RECEIVED

JAN 25 1994

W

BUTTARS SURVEYING

1815 26TH STREET OGDEN, UT. 84401
PHONE 392-5231

CLIENT: O. C. RECORD

SURVEY LOCATION:
S.W. 1/4 SEC. 17, T.6N, R.1E, S.L.B. & M.
OGDEN CANYON WILDWOOD ESTATES

SURVEY DATE: 8-22-94

