

### SURVEYORS CERTIFICATE

I, DALLAS K. BUTTARS, A REGISTERED LAND SURVEYOR AS PRESCRIBED BY THE LAWS OF THE STATE OF UTAH AND HOLDING LICENSE NUMBER 187594, DO HEREBY CERTIFY THAT I MADE A SURVEY OF THE BELOW DESCRIBED PROPERTY AND THE PLAT HEREON IS A TRUE AND CORRECT REPRESENTATION OF SAID SURVEY.


DATE: \_\_\_\_\_ SIGNED: \_\_\_\_\_

### DESCRIPTION

ALL OF LOT 1, WOODLAND HILLS SUBDIVISION NO.1 WEBER COUNTY, UTAH.

### NARRATIVE

THE PURPOSE OF THIS SURVEY WAS TO SET THE NORTH LINE OF PROPERTY ON THE GROUND. WEBER COUNTY NAIL AND WASHER WERE FOUND AT THE SHOWN INTERSECTIONS AND FIT SURROUNDING OCCUPATION LINES.

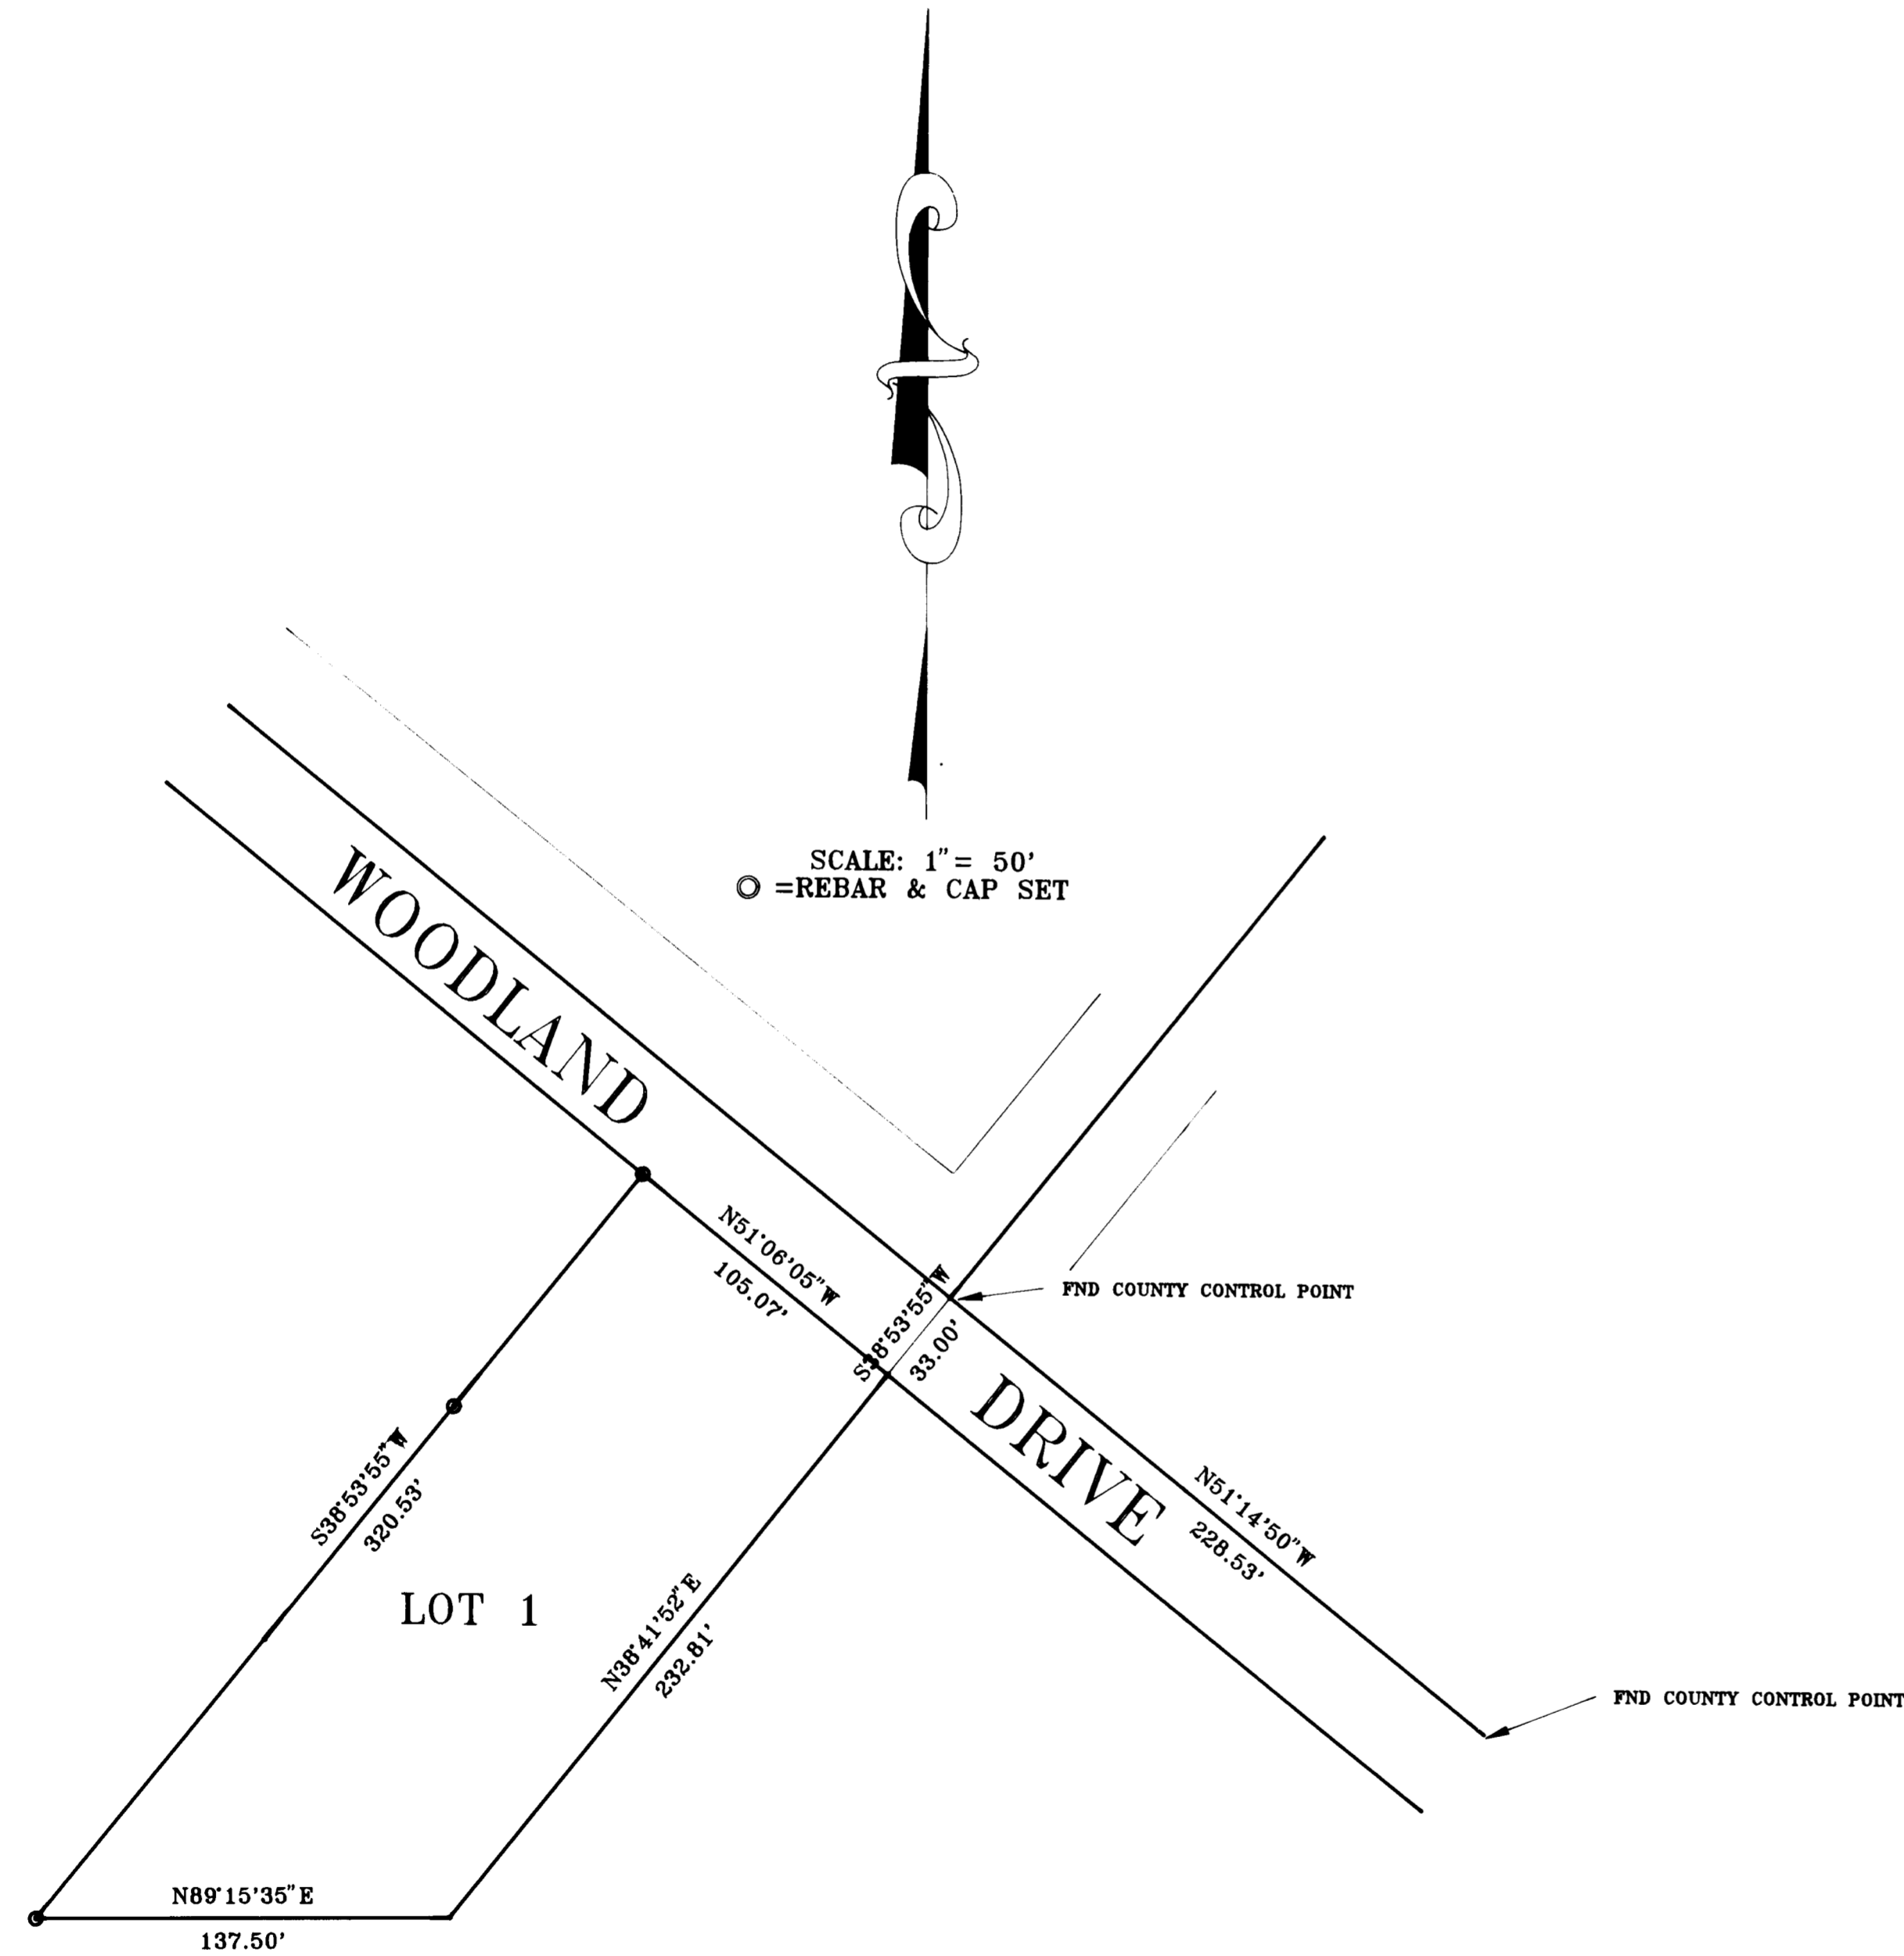

**BUTTARS**  
**LANDMARK SURVEYING**  
 A COMPLETE SURVEYING SERVICE  
 2480 GRANT AVE. SUITE 318-B OGDEN, UTAH 84401  
 PH 827-6014 FAX 827-6281

CLIENT: MICHELLE CHRISTIAN  
 LOCATION: N.E. 1/4 SEC. 23, T.5 N. R.1 W. S.L.B.&M.  
 SURVEYED: JANUARY 14, 1995