DRAWING NUMBER 001136

PLAN HOLD CORPORATION • IRVINE, CALIFORNIA

REORDER BY NUMBER 017549

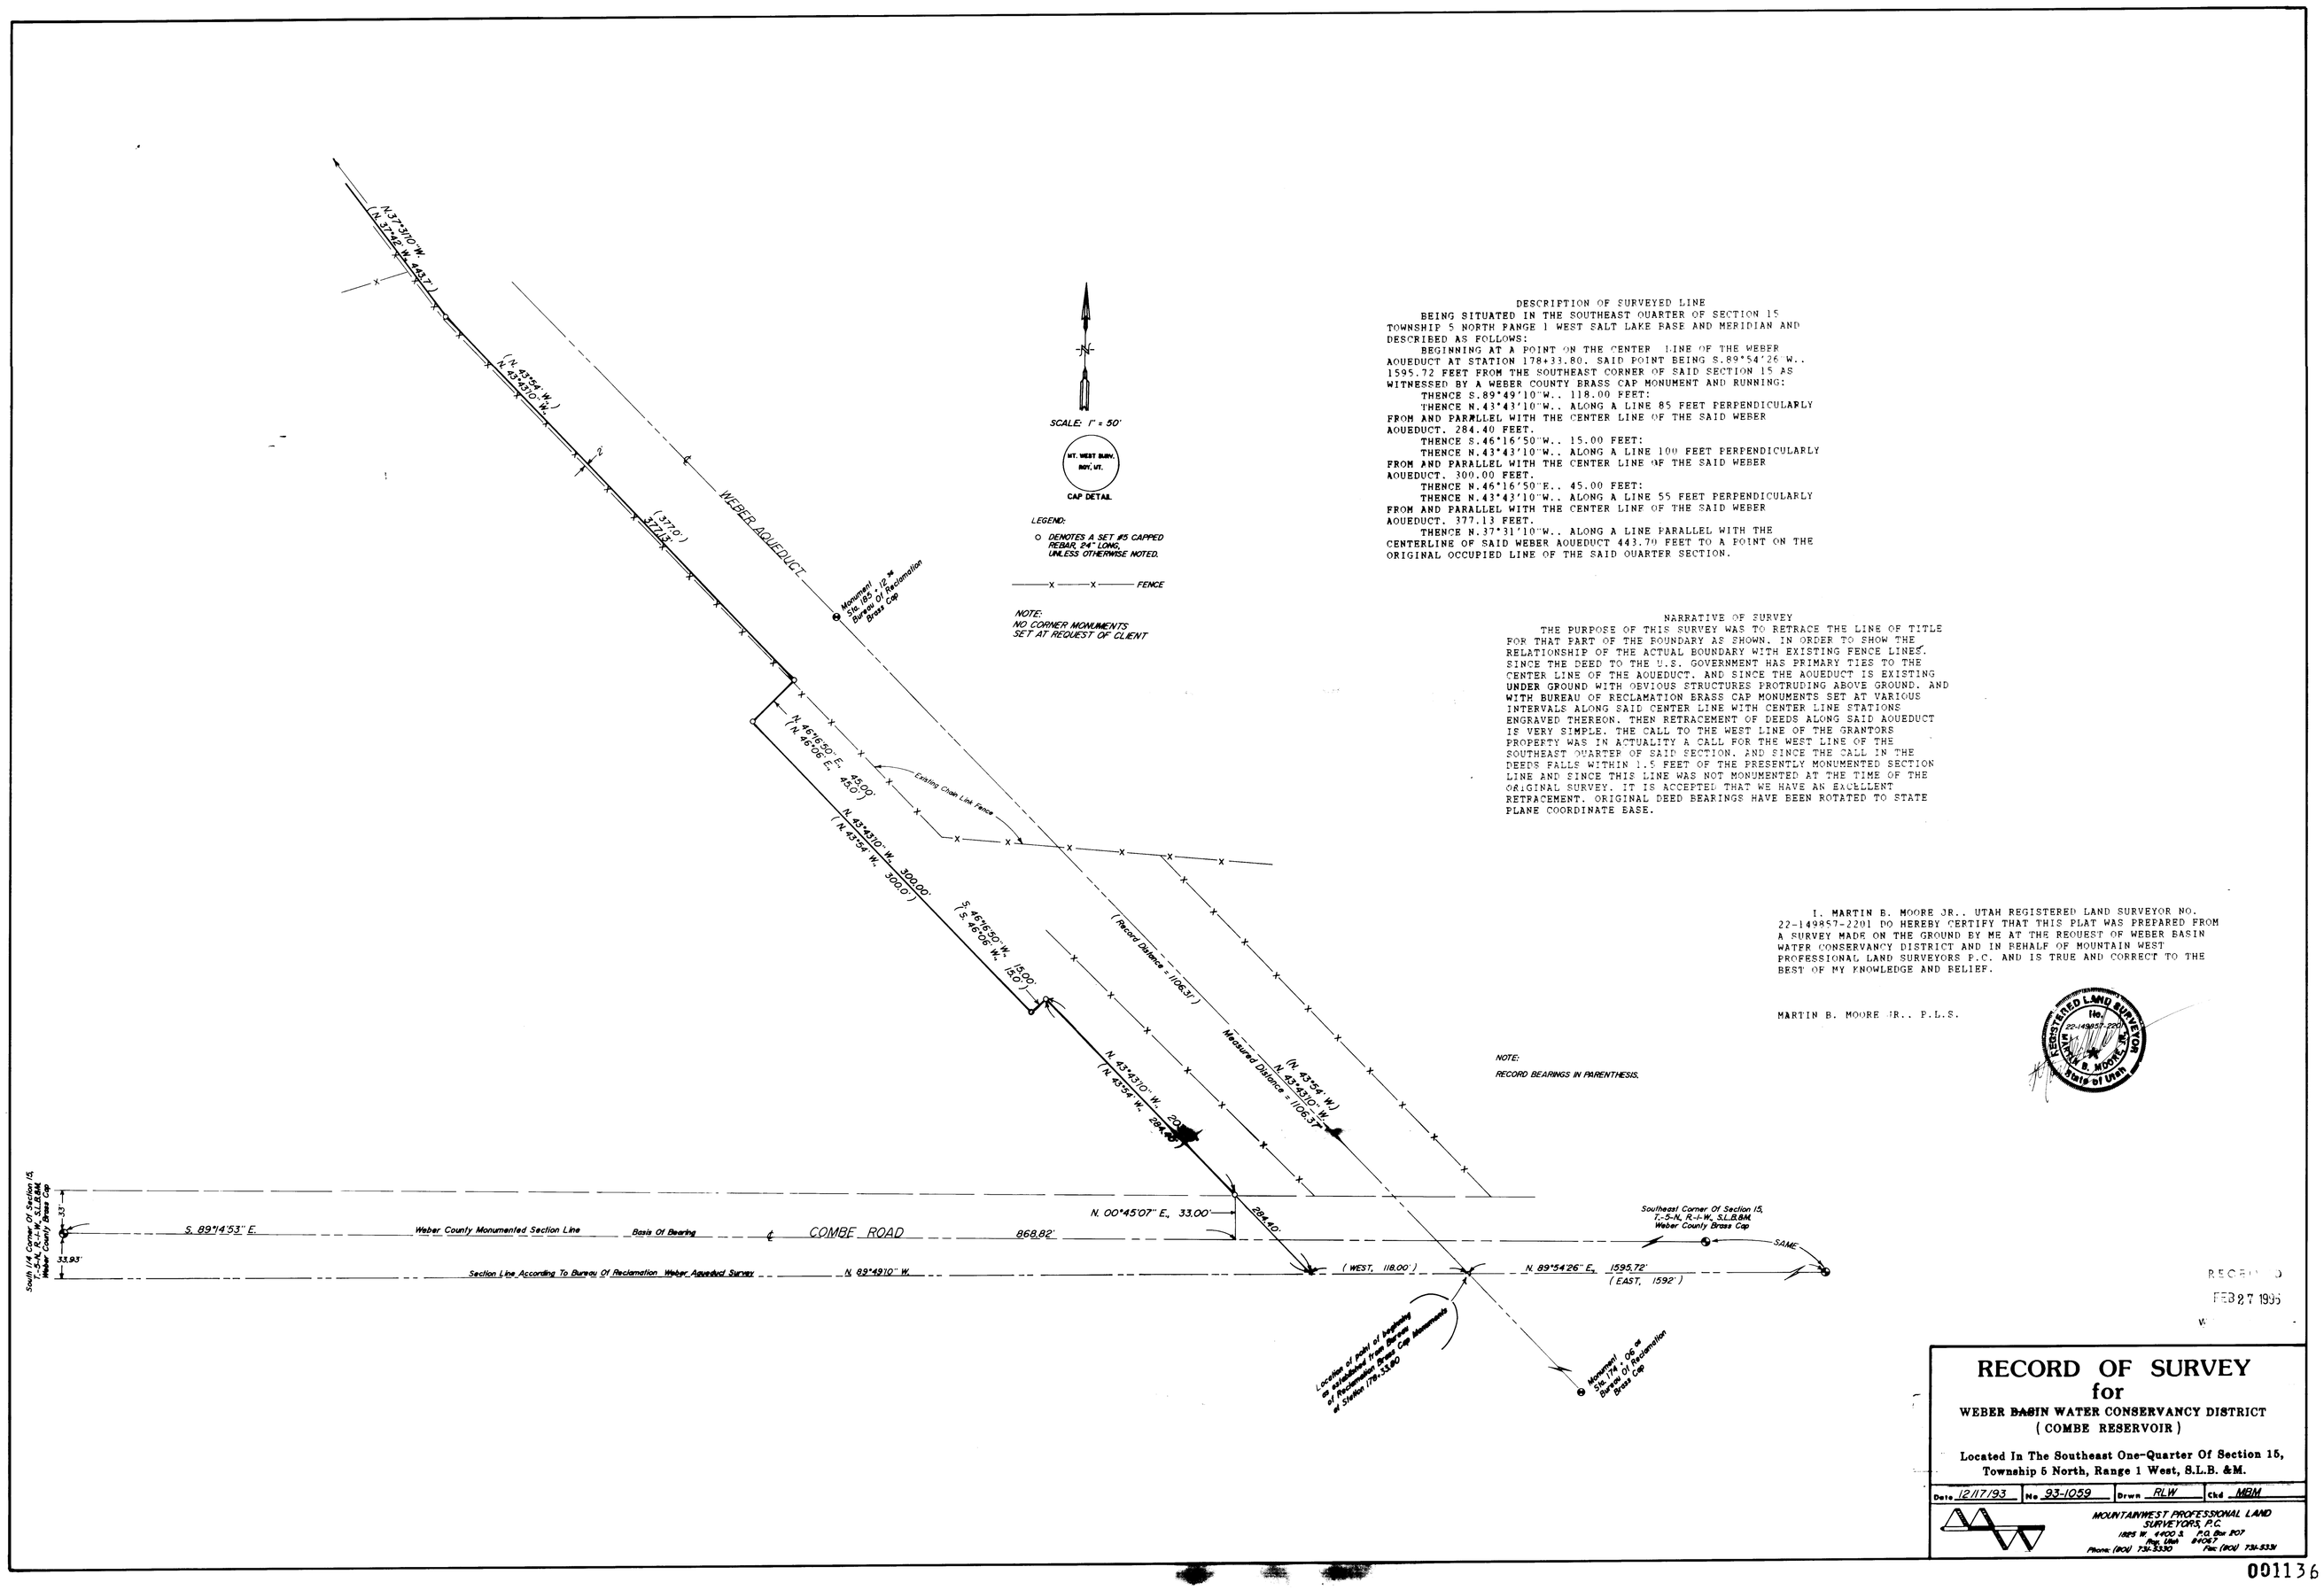


DESCRIPTION OF SURVEYED LINE

BEING SITUATED IN THE SOUTHEAST QUARTER OF SECTION 15 TOWNSHIP 5 NORTH RANGE 1 WEST SALT LAKE BASE AND MERIDIAN AND DESCRIBED AS FOLLOWS:

BEGINNING AT A POINT ON THE CENTER LINE OF THE WEBER AQUEDUCT AT STATION 178+33.60. SAID POINT BEING S.89°54'26"W.. 1595.72 FEET FROM THE SOUTHEAST CORNER OF SAID SECTION 15 AS WITNESSED BY A WEBER COUNTY BRASS CAP MONUMENT AND RUNNING:

THENCE S.89°49'10"W.. 118.00 FEET:

THENCE N.43°43'10"W.. ALONG A LINE 85 FEET PERPENDICULARLY FROM AND PARALLEL WITH THE CENTER LINE OF THE SAID WEBER AQUEDUCT. 284.40 FEET.

THENCE S.46°16'50"W.. 15.00 FEET:

THENCE N.43°43'10"W.. ALONG A LINE 100 FEET PERPENDICULARLY FROM AND PARALLEL WITH THE CENTER LINE OF THE SAID WEBER AQUEDUCT. 300.00 FEET.

THENCE N.46°16'50"E.. 45.00 FEET:

THENCE N.43°43'10"W.. ALONG A LINE 55 FEET PERPENDICULARLY FROM AND PARALLEL WITH THE CENTER LINE OF THE SAID WEBER AQUEDUCT. 377.13 FEET.

THENCE N.37°31'10"W.. ALONG A LINE PARALLEL WITH THE CENTERLINE OF SAID WEBER AQUEDUCT 443.70 FEET TO A POINT ON THE ORIGINAL OCCUPIED LINE OF THE SAID QUARTER SECTION.

NARRATIVE OF SURVEY

THE PURPOSE OF THIS SURVEY WAS TO RETRACE THE LINE OF TITLE FOR THAT PART OF THE BOUNDARY AS SHOWN. IN ORDER TO SHOW THE RELATIONSHIP OF THE ACTUAL BOUNDARY WITH EXISTING FENCE LINES. SINCE THE DEED TO THE U.S. GOVERNMENT HAS PRIMARY TIES TO THE CENTER LINE OF THE AQUEDUCT. AND SINCE THE AQUEDUCT IS EXISTING UNDER GROUND WITH OBVIOUS STRUCTURES PROTRUDING ABOVE GROUND. AND WITH BUREAU OF RECLAMATION BRASS CAP MONUMENTS SET AT VARIOUS INTERVALS ALONG SAID CENTER LINE WITH CENTER LINE STATIONS ENGRAVED THEREON. THEN RETRACEMENT OF DEEDS ALONG SAID AQUEDUCT IS VERY SIMPLE. THE CALL TO THE WEST LINE OF THE GRANTORS PROPERTY WAS IN ACTUALITY A CALL FOR THE WEST LINE OF THE SOUTHEAST QUARTER OF SAID SECTION. AND SINCE THE CALL IN THE DEEDS FALLS WITHIN 1.5 FEET OF THE PRESENTLY MONUMENTED SECTION LINE AND SINCE THIS LINE WAS NOT MONUMENTED AT THE TIME OF THE ORIGINAL SURVEY. IT IS ACCEPTED THAT WE HAVE AN EXCELLENT RETRACEMENT. ORIGINAL DEED BEARINGS HAVE BEEN ROTATED TO STATE PLANE COORDINATE BASE.

I. MARTIN B. MOORE JR.. UTAH REGISTERED LAND SURVEYOR NO. 22-149857-2201 DO HEREBY CERTIFY THAT THIS PLAT WAS PREPARED FROM A SURVEY MADE ON THE GROUND BY ME AT THE REQUEST OF WEBER BASIN WATER CONSERVANCY DISTRICT AND IN BEHALF OF MOUNTAIN WEST PROFESSIONAL LAND SURVEYORS P.C. AND IS TRUE AND CORRECT TO THE BEST OF MY KNOWLEDGE AND BELIEF.

MARTIN B. MOORE JR.. P.L.S.

REGISTERED LAND SURVEYOR No. 22-149857-2201 MARTIN B. MOORE, JR. State of Utah

RECORDED

FEB 27 1995

# RECORD OF SURVEY
## for
**WEBER BASIN WATER CONSERVANCY DISTRICT**
**( COMBE RESERVOIR )**

**Located In The Southeast One-Quarter Of Section 15, Township 5 North, Range 1 West, S.L.B. &M.**

| Date 12/17/93 | No. 93-1059 | Drwn RLW | Chkd MBM |
|---|---|---|---|

MOUNTAINWEST PROFESSIONAL LAND SURVEYORS, P.C.
1825 W. 4100 S. P.O. Box 907
Roy, Utah 84067
Phone: (801) 731-5330 Fax: (801) 731-5331