


THE PURPOSE OF THIS SURVEY WAS TO DETERMINE AVERAGE AND CORRECT THE PROPERTY LINES THEREON. THE PROPERTY LINES IN THIS SURVEY WERE DETERMINED BY MEASUREMENTS MADE IN THE FIELD BY THE SURVEYOR. THE PROPERTY LINES SHOWN ON THIS SURVEY WERE DETERMINED BY MEASUREMENTS MADE IN THE FIELD BY THE SURVEYOR. 

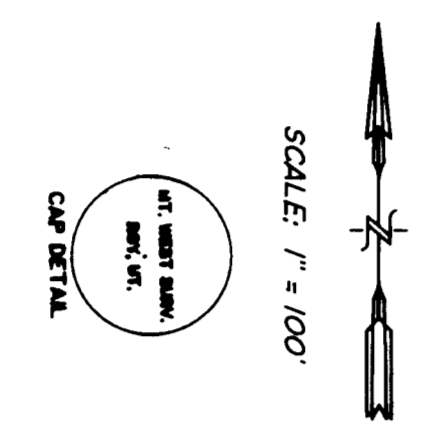

LEGEND
 O BOUNDARY AS SHOWN ON CAPRIED
 LINES OTHERWISE NOTED
 X - - - - - FENCE

PARCEL ONE DESCRIPTION
 BEING PART OF THE SOUTHWEST QUARTER OF SECTION 5, TOWNSHIP 6 NORTH, RANGE 1 WEST, SANIT LANE BASE AND MERIDIAN, AND DESCRIBED AS FOLLOWS:
 BEGINNING AT A POINT ON AN EAST-WEST FENCE LINE, SAID POINT BEING 165 FEET TO THE WEST CORNER OF SAID SECTION 5, AND RUNNING S 89°08'47\"/>





MARTIN W. MOORE JR., P.L.S.
 SURVEY MADE ON THE GROUND BY ME AT THE REQUEST OF JED MCCORMICK AND IS TRUE AND CORRECT TO THE BEST OF MY KNOWLEDGE AND BELIEF.



RECORD OF SURVEY
 for
JED MCCORMICK
 Located in the South Quarter of Section 5,
 Township 6 North, Range 1 West, S1B, 6M.
 10/28/93 33/022
