






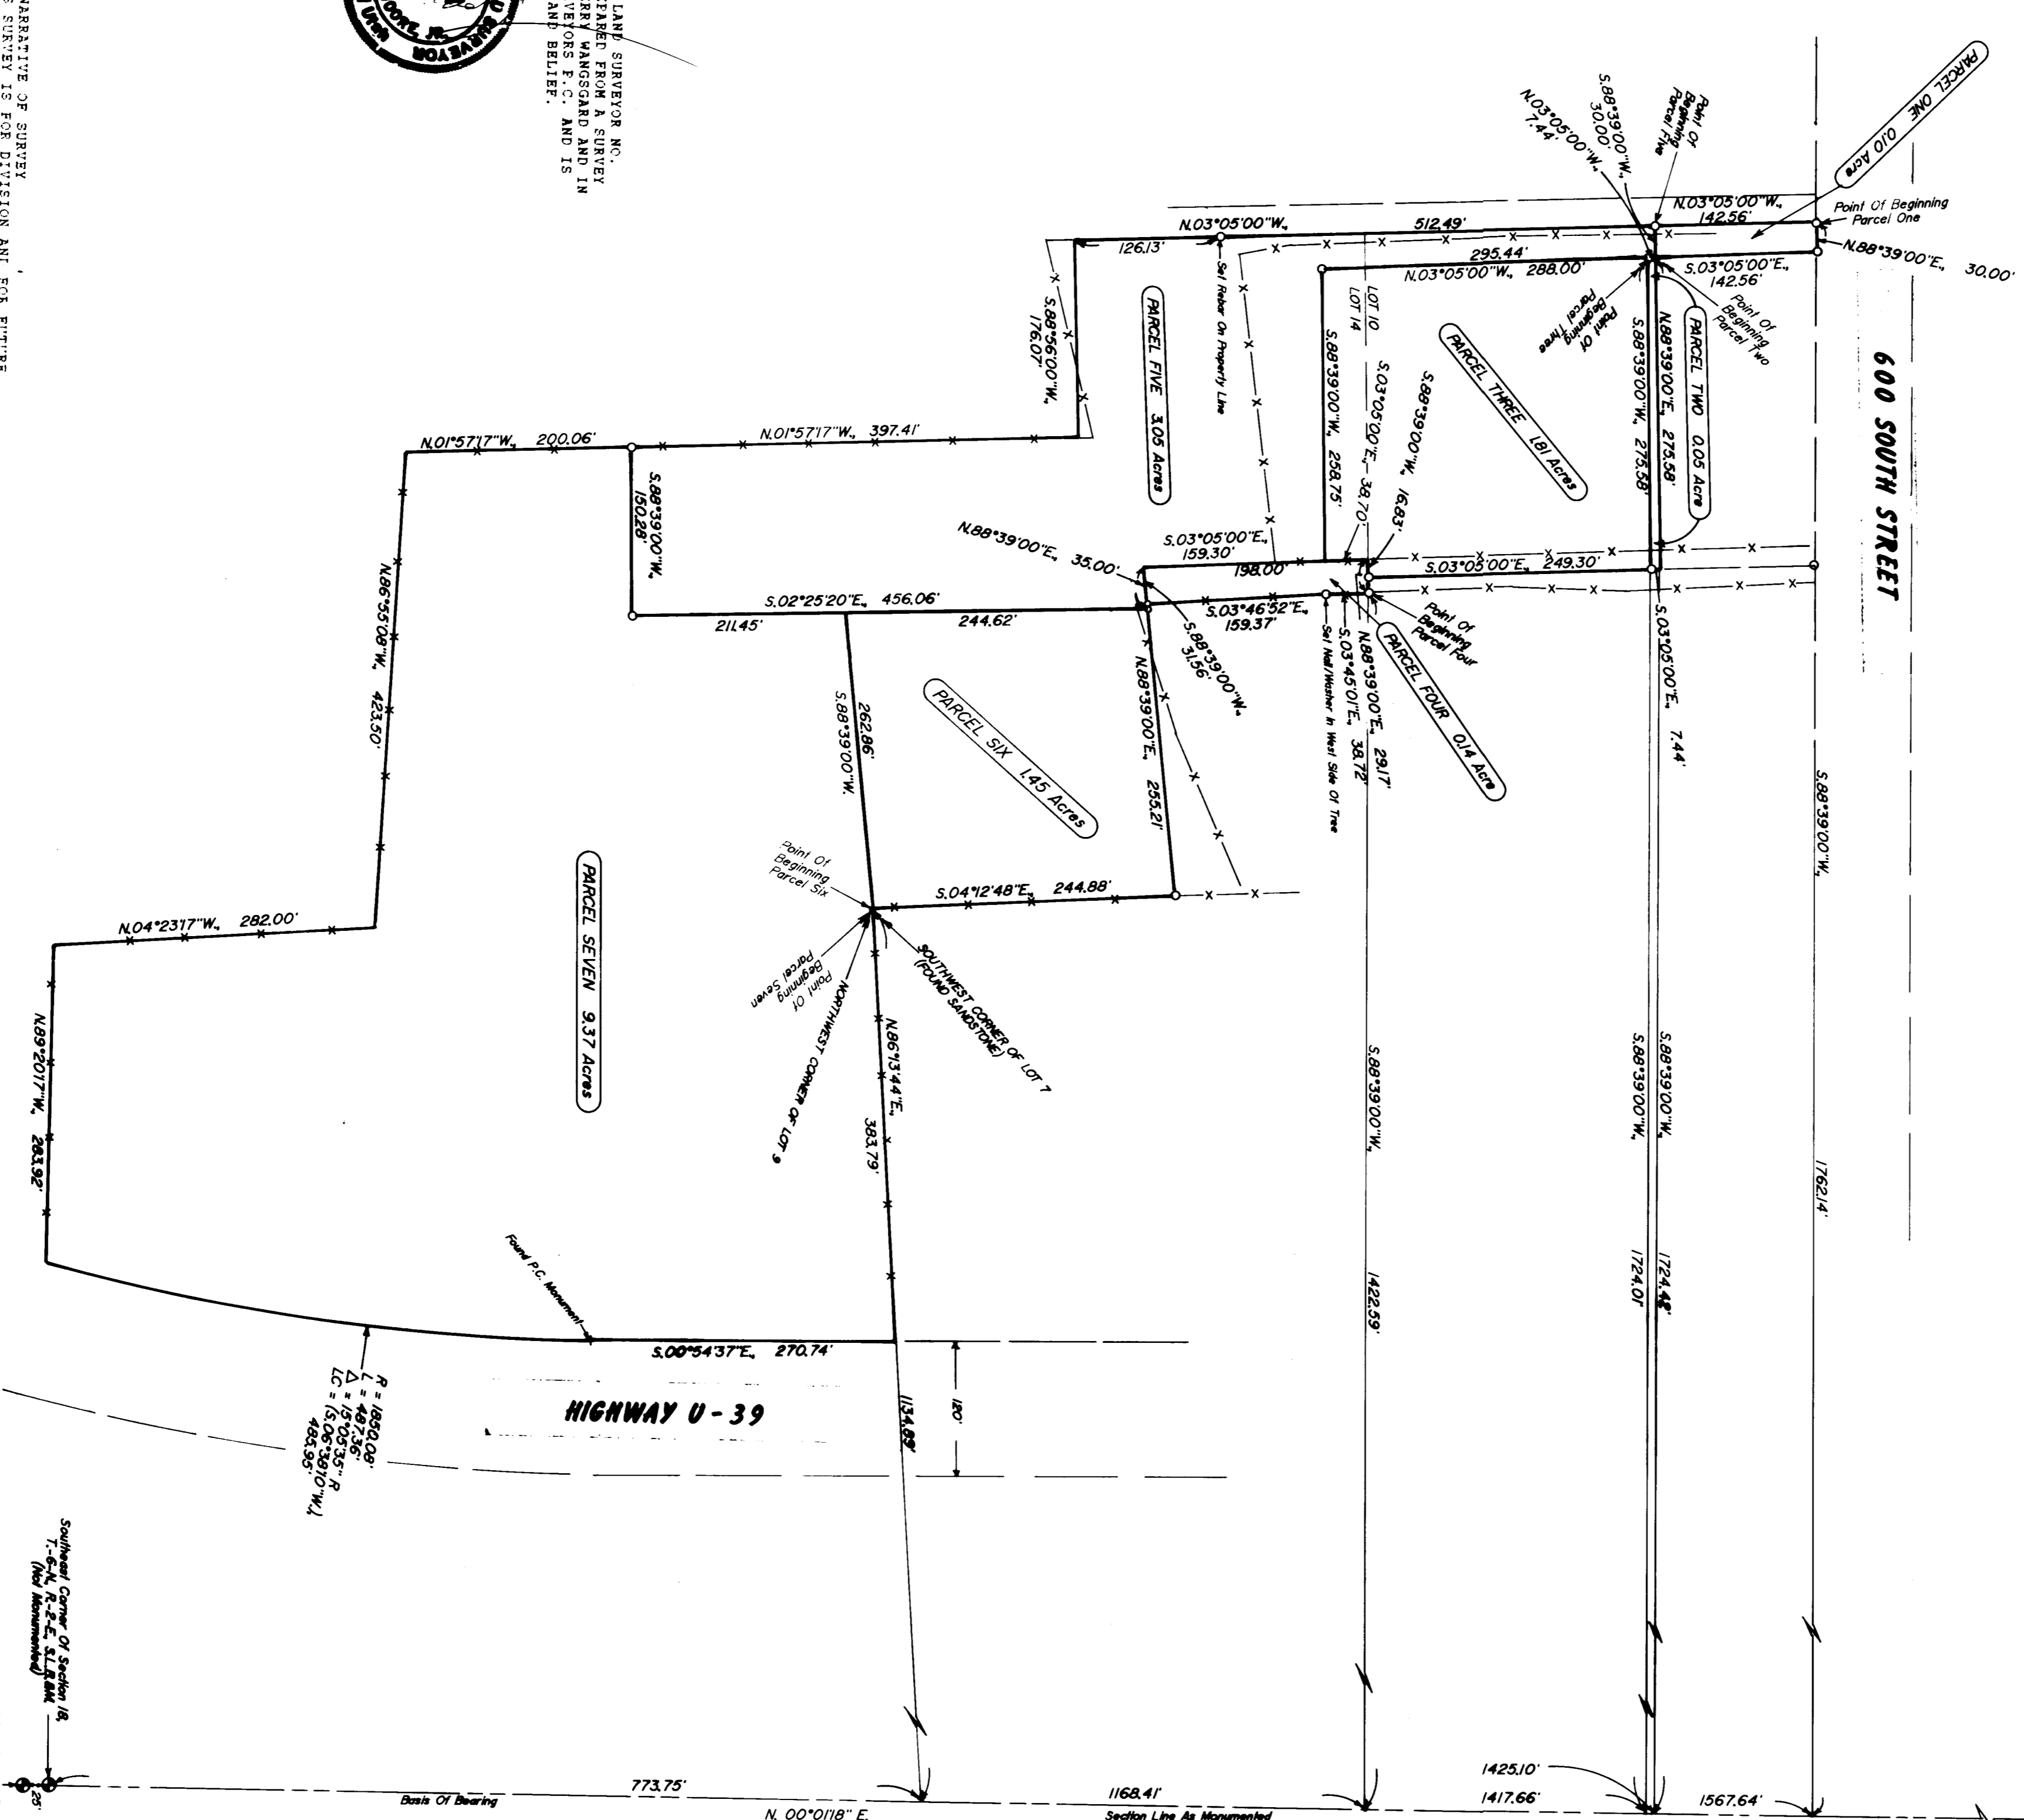








RECEIVED
FEB 27 1995
KERRY WANGSGARD
RECORD OF SURVEY
for
KERRY WANGSGARD
Located in The Southeast One-Quarter of Section 18,
Township 6 North, Range 2 East, S.L.B. 434.
Map No. 001143
Scale 1" = 100'

REVISED: 11/18/93

001143