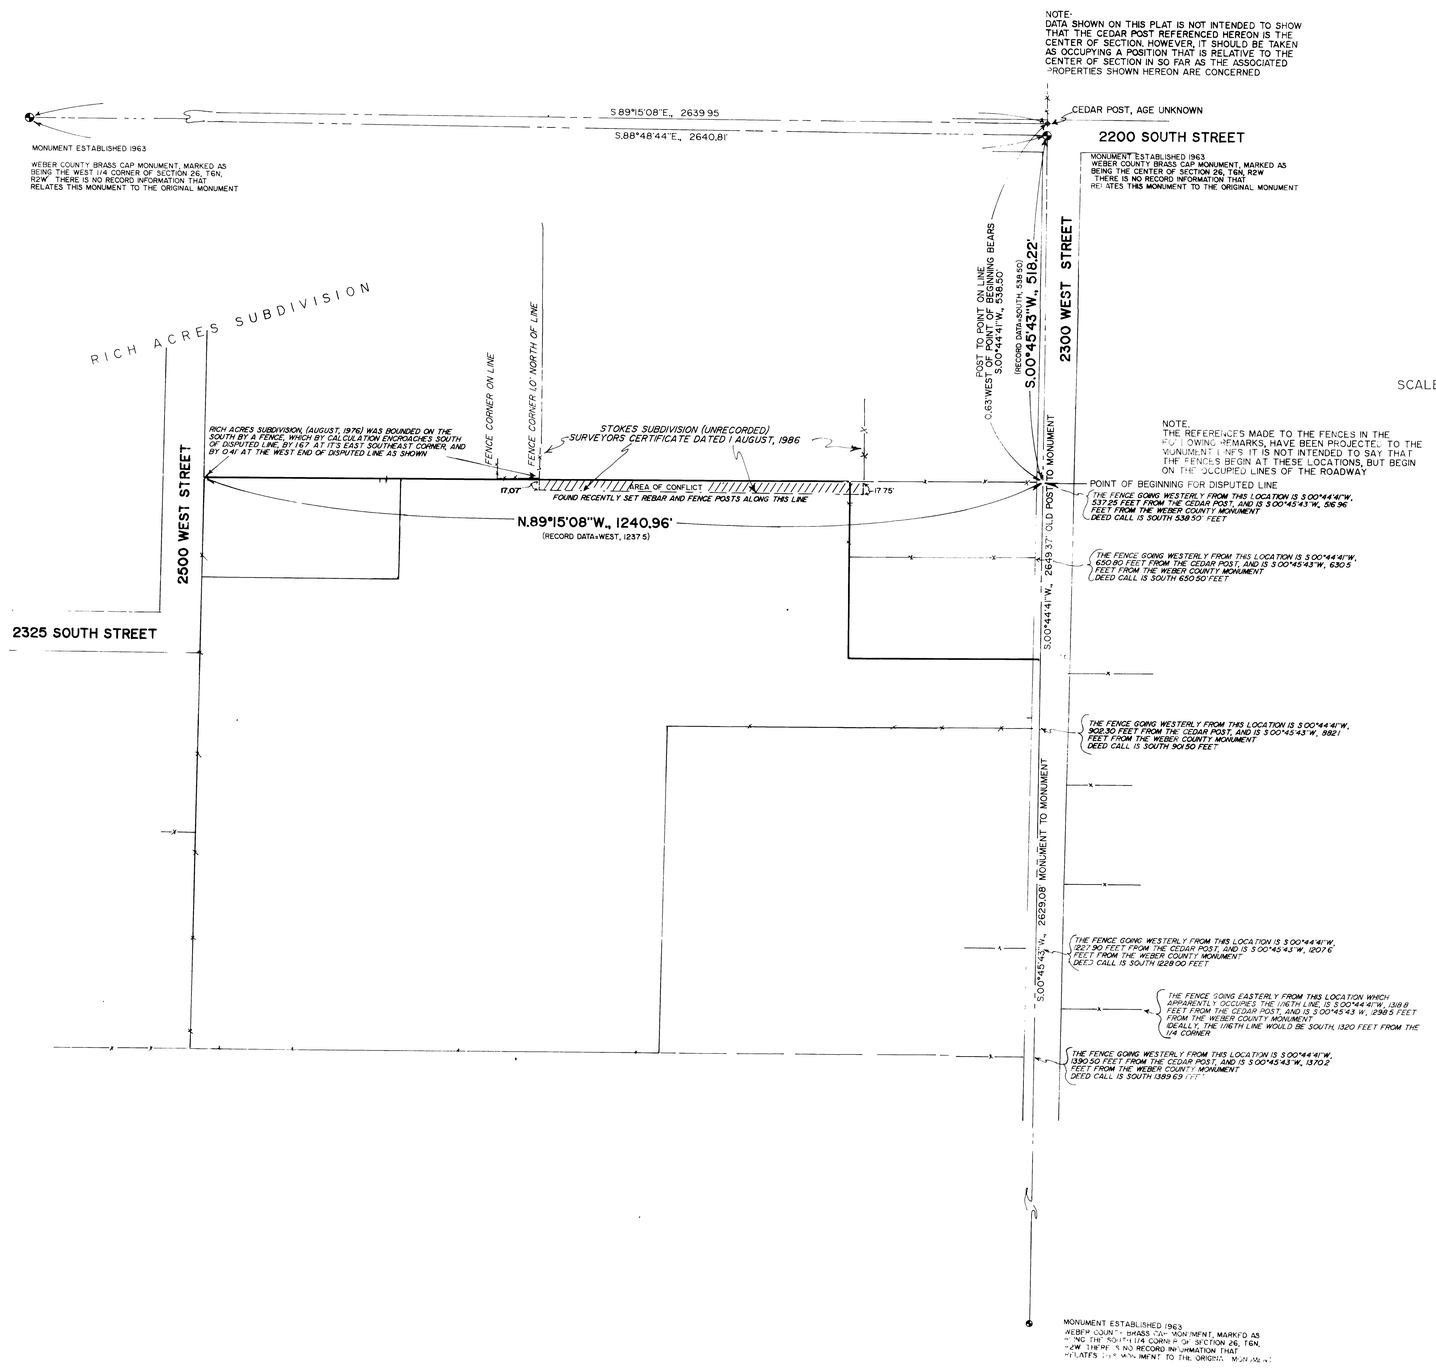

NARRATIVE OF SURVEY

THE PURPOSE OF THIS SURVEY WAS TO CONDUCT A DEPENDENT RESURVEY OF THE LINE SHOWN ON THIS PLAT AS "DISPUTED LINE", AND TO ASCERTAIN FROM THE BEST AVAILABLE EVIDENCE THE LOCATION OF THIS LINE AS ORIGINALLY ESTABLISHED.

THE LOCATION OF THIS LINE IS IN THE SOUTHWEST ONE-QUARTER OF SECTION 26, TOWNSHIP 6 NORTH, RANGE 2 WEST, SALT LAKE MERIDIAN. THIS QUARTER SECTION WAS PATENTED TO JAMES WILSON ON NOVEMBER 20, 1882. THE DISPUTED LINE HAD ITS ORIGIN FEBRUARY 24TH, 1888, AS BEGINNING 32 RODS SOUTH OF THE NORTHEAST CORNER OF SAID QUARTER SECTION, AND WAS CORRECTED BY CORRECTION DEED JUNE 9TH, 1897, TO BEGIN 32 RODS 10.5 FEET SOUTH OF THE NORTHEAST CORNER OF THE SAID QUARTER SECTION.

NO ATTEMPT HAS BEEN MADE TO SEGREGATE THAT PORTION OF THE LINE SHOWN, AS AREA OF CONFLICT, AS OBVIOUSLY THE ENTIRE LINE MUST HAVE BEEN IN QUESTION.

OTHER INFORMATION PERTINENT TO THIS RETRACEMENT APPEARS ON PLAT IN NOTE FORM.

I, MARTIN B. MOORE JR. LICENSED LAND SURVEYOR NO. 3964, AS PRESCRIBED BY THE LAWS OF THE STATE OF UTAH, DO HEREBY CERTIFY THAT THIS PLAT WAS PREPARED FROM A SURVEY MADE ON THE GROUND BY ME, ON BEHALF OF MOUNTAIN WEST PROFESSIONAL LAND SURVEYORS P.C., AT THE REQUEST OF MR. DALE STRATFORD, AND IS AN ACCURATE RETRACEMENT OF THE ORIGINAL LINE OF TITLE, ACCORDING TO THE BEST AVAILABLE SOURCES OF EVIDENCE. TO THE BEST OF MY KNOWLEDGE AND BELIEF.

MARTIN B. MOORE JR.

REGISTERED LAND SURVEYOR No. 3964 MARTIN B. MOORE JR. State of Utah

DESCRIPTION OF LINE.

BEING LOCATED IN THE SOUTHWEST ONE-QUARTER OF SECTION 26, TOWNSHIP 6 NORTH, RANGE 2 WEST, SALT LAKE MERIDIAN, AND DESCRIBED AS FOLLOWS:

BEGINNING AT A POINT ON THE MONUMENTED EAST LINE OF THE SAID SOUTHWEST ONE-QUARTER, SAID POINT BEING S.00 DEG. 45 MIN. 43 SEC. W., 518.22 FEET FROM THE WEBER COUNTY MONUMENT MARKED AS BEING THE CENTER OF SAID SECTION, AND RUNNING:

THENCE N.89 DEG. 15 MIN. 08 SEC. W., 972.00 FEET, TO THE END OF SAID LINE, AS CALLED IN DEED DATED FEB. 24, 1888, AND CONTINUING FOR A TOTAL LENGTH OF 1240.96 FEET.

RECEIVED
JUN 15 1988
Weber County Surveyor

RECORD OF SURVEY

PART OF THE S.W. 1/4 OF SEC. 26
T6N, R2W, SLB&M

for
DALE STRATFORD et al

Date 4-16-88	No 88-1015	Drwn MBM	Ckd DNM

MOUNTAIN WEST PROFESSIONAL LAND SURVEYORS, P.C.

DRAWING NUMBER 000115

DRAWING NUMBER 000115

DRAWING NUMBER 000115