


McNEIL ENGINEERING, INC.
CIVIL, STRUCTURAL ENGINEERING & LAND SURVEYING
PAVEMENT & ROOF CONSULTANTS
1952 EAST 7000 SOUTH, SUITE 200, SALT LAKE CITY, UTAH 84123
944-8112

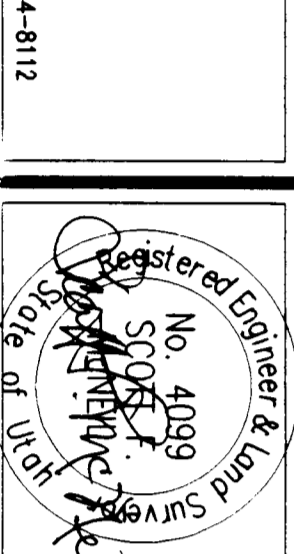

BOYER - ODGEN MEDICAL CENTER
693 EAST 12TH STREET ODGEN, UTAH
LOCATED IN THE NW 1/4 OF THE SE 1/4 AND THE SW 1/4 OF THE NE 1/4 SECTION 21, T8N, R1W, S28M




REVISIONS:

DRAWN BY:	KAP
CHECKED BY:	
DATE:	03/15/94
JOB NO.:	94135

DESIGNED BY:	CM/RG
CALC. BY:	
SCALE:	1" = 30'
COMP. DRAWING:	94135SVY.DWG

SHEET DESCRIPTION:
TOPOGRAPHIC &
BOUNDARY SURVEY

SHEET NO.
1
OF ONE

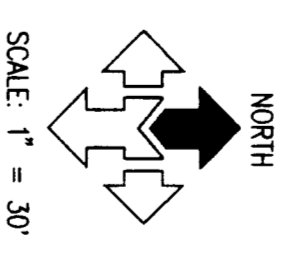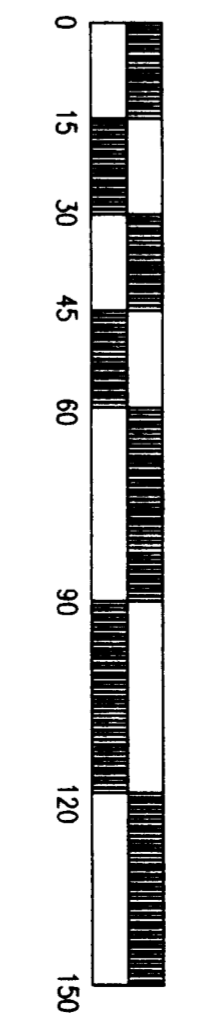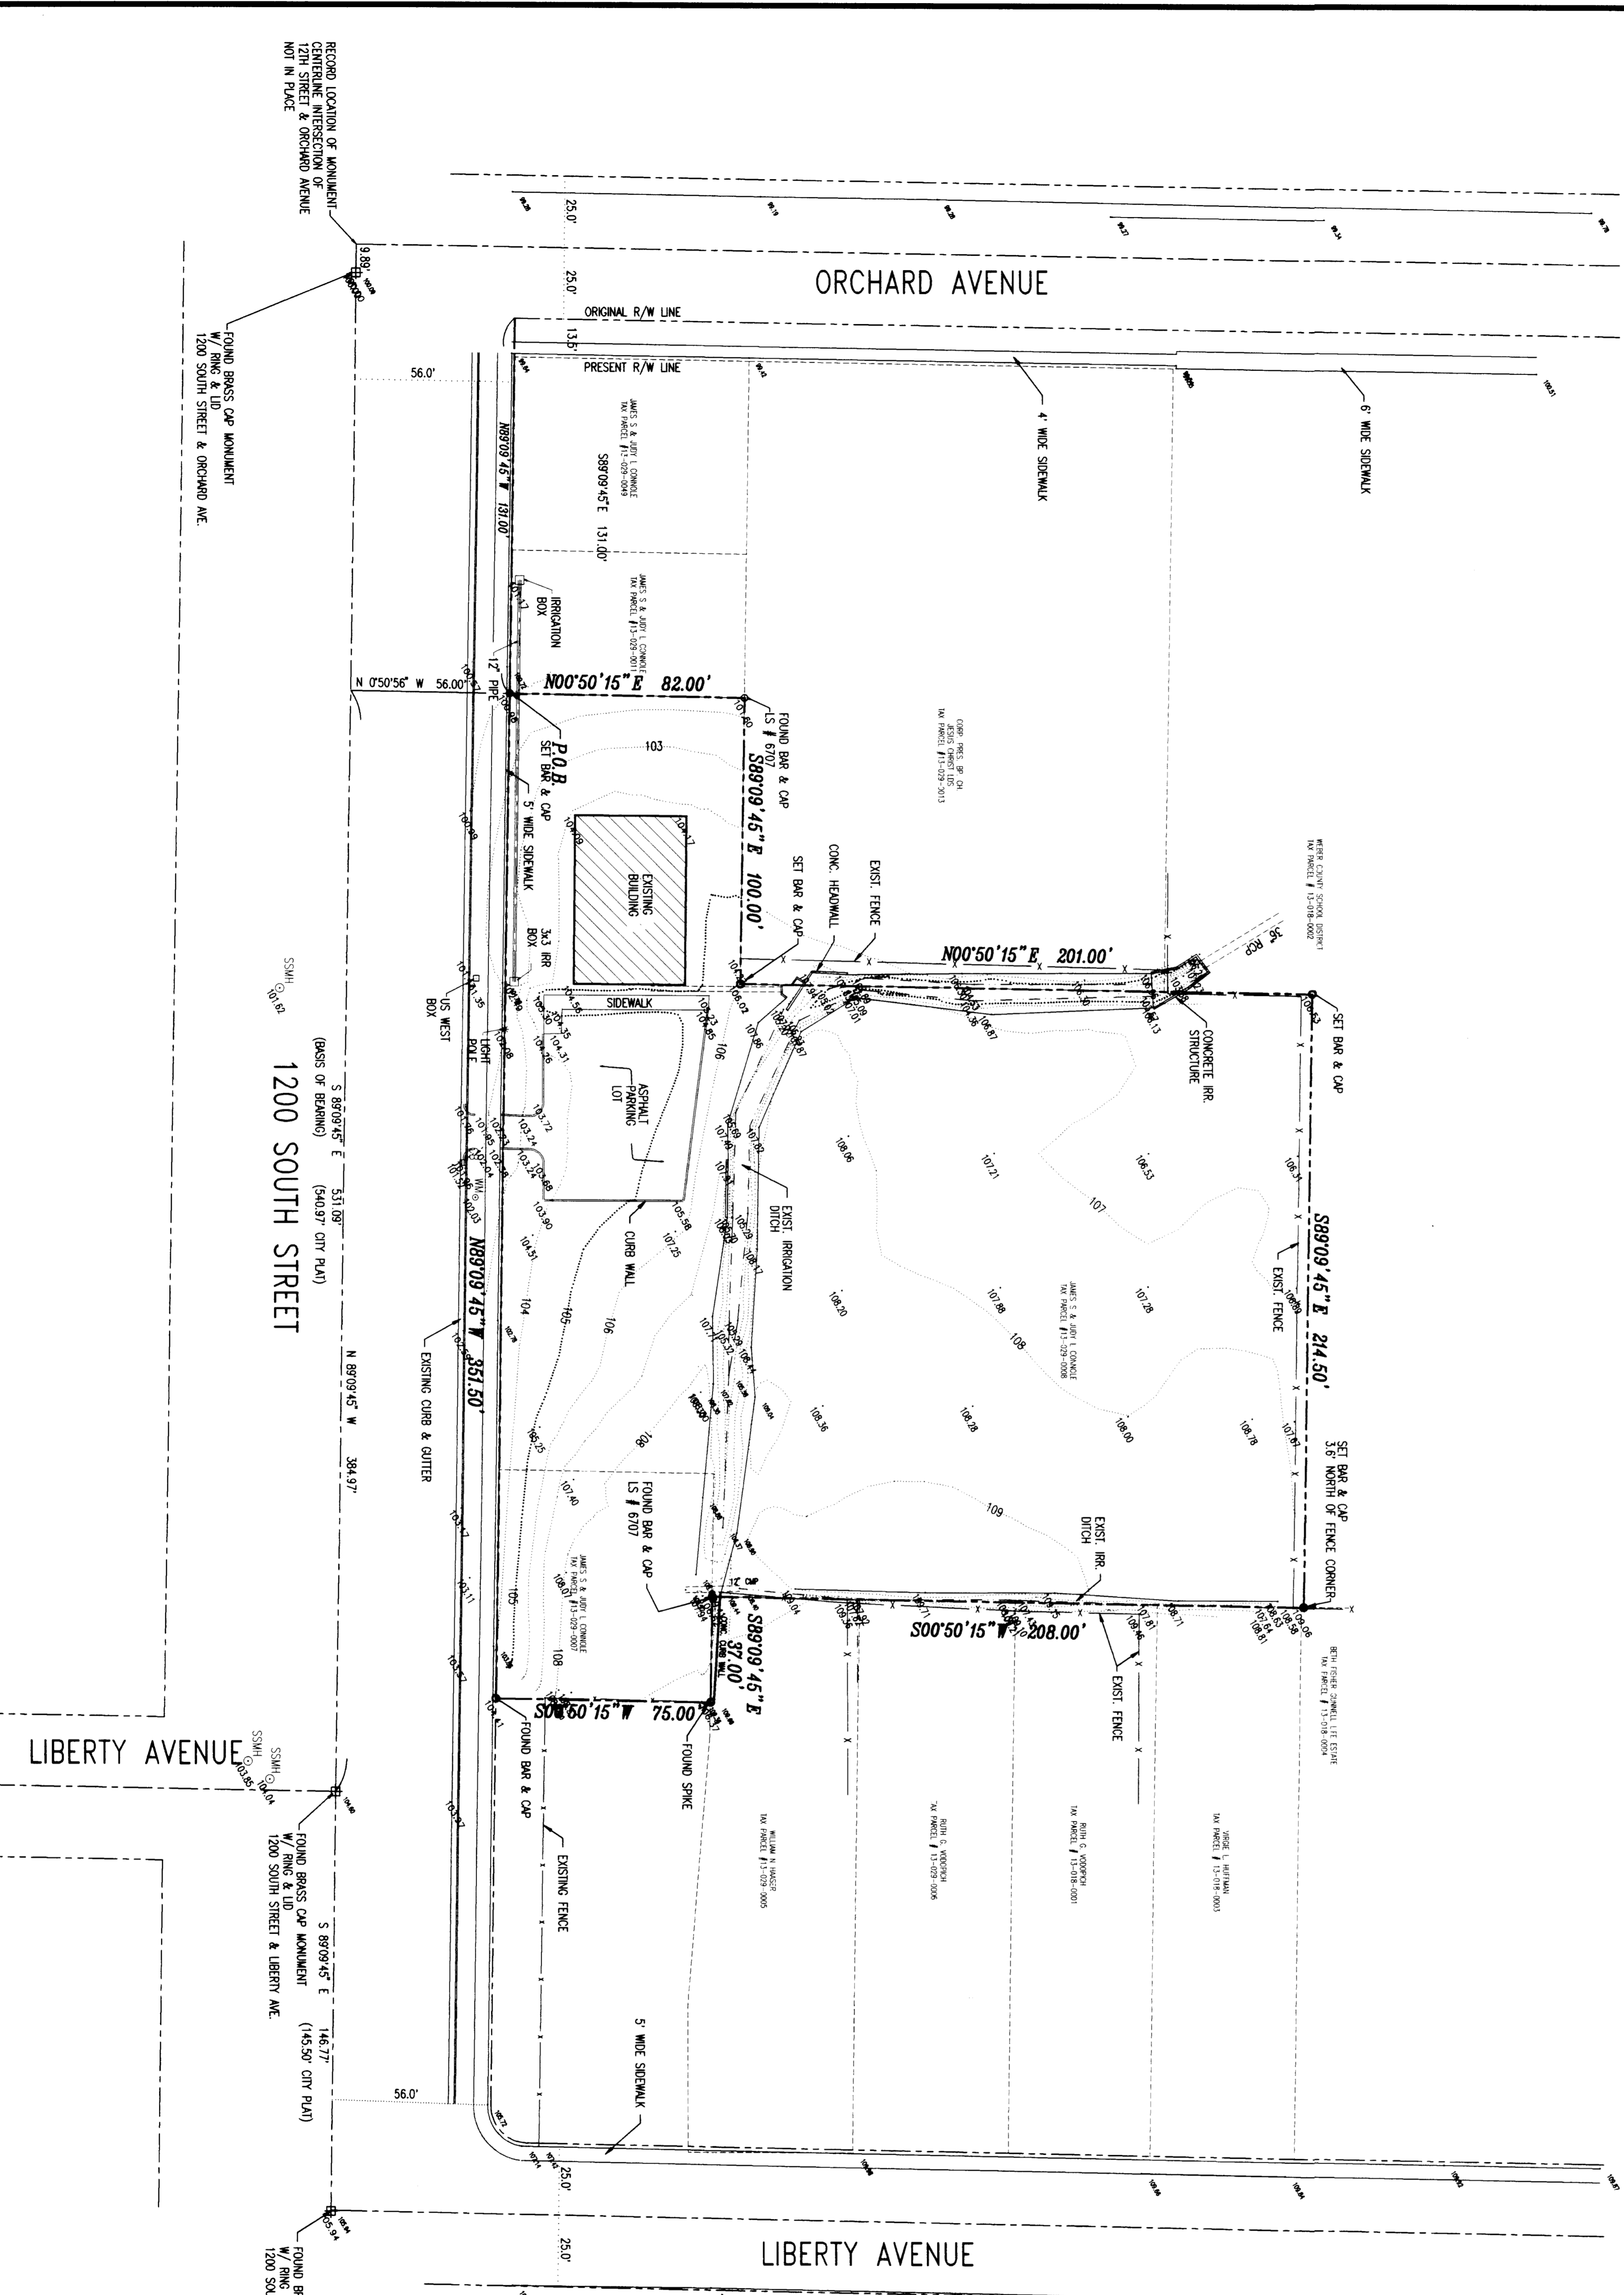

SCALE: 1" = 30'


BOUNDARY DESCRIPTION


NARRATIVE


DATE: 8/15/94
BY: [Signature]
