


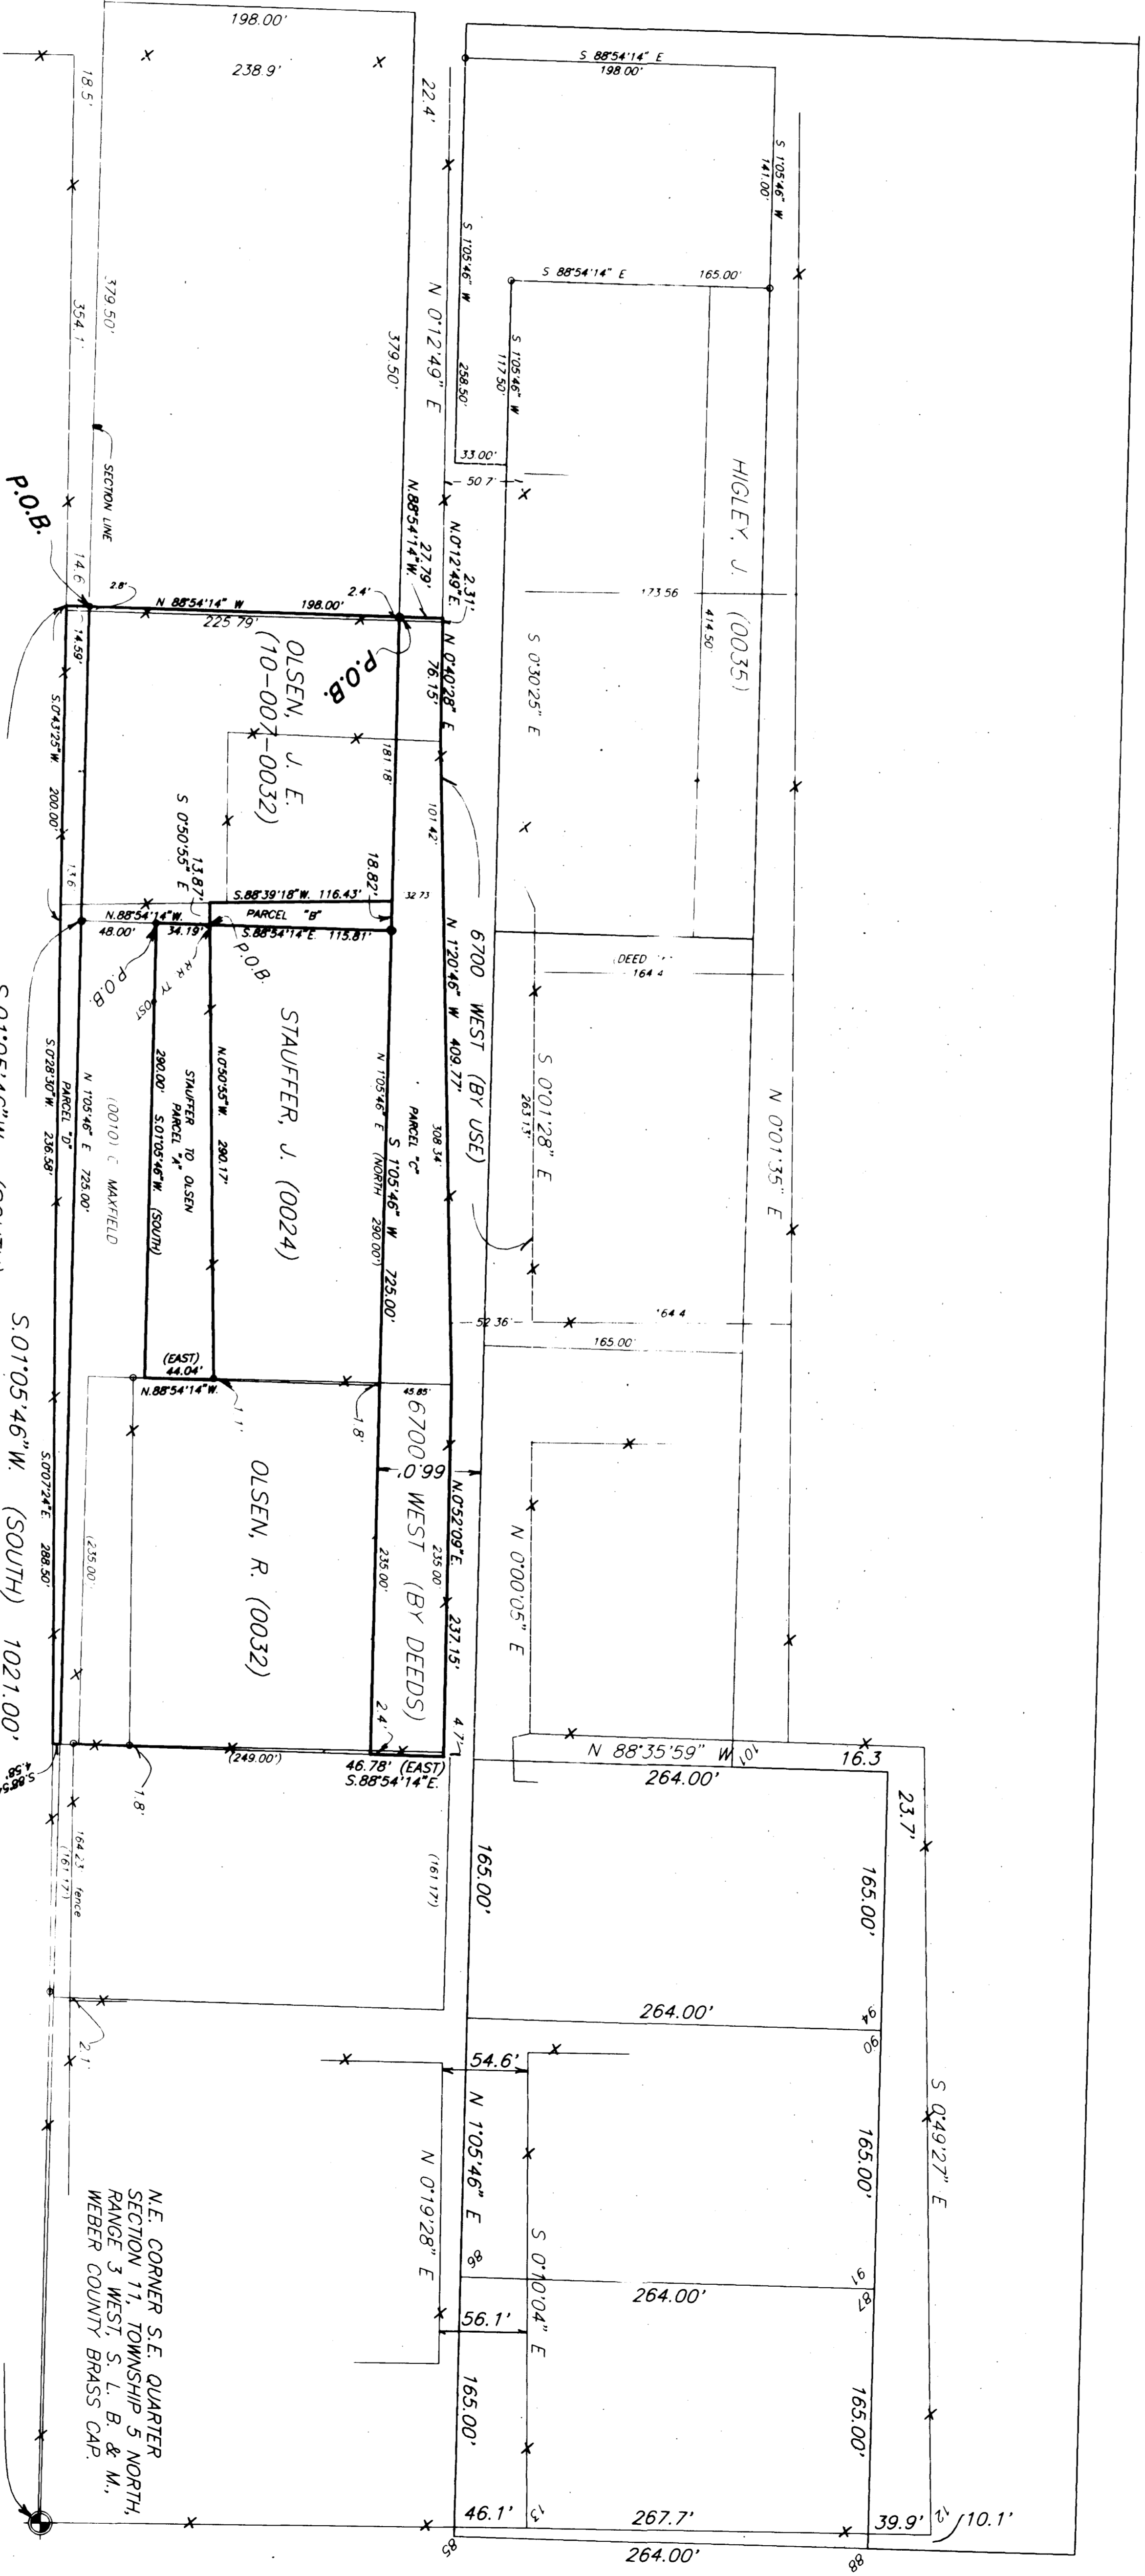

SOUTHEAST CORNER OF
SEC. 11, T. 5 N., R. 3 W.,
W.C.S. BRASS CAP MON.



LEGAL DESCRIPTIONS

PARCEL "A" (RESUB TO OLSEN)
A PART OF THE SOUTHWEST QUARTER OF SECTION 11, TOWNSHIP 5 NORTH, RANGE 3 WEST, SALT LAKE BASE AND MERIDIAN, BEGINNING AT THE SOUTHWEST CORNER OF JOSEPH STAUFFER PROPERTY AS RECORDED IN BOOK 1532 PAGE 1343 OF THE WEBER COUNTY RECORDS, SAID POINT BEARS S. 010 05' 46" W. (SOUTH) 1021.00 FEET NORTHWEST CORNER OF SAID QUARTER SECTION, 45.00 FEET WEST AND 11.342 SQUARE FEET, MORE OR LESS, CONTAINING 11.342 SQUARE FEET, MORE OR LESS.

PARCEL "C" (TOTAL DESCRIPTION FOR THE PURPOSE OF A QUIET TITLE ACTION)
(Property lies east of existing east fence line of 6700 WEST)
A PART OF THE SOUTHWEST QUARTER OF SECTION 11, TOWNSHIP 5 NORTH, RANGE 3 WEST, SALT LAKE BASE AND MERIDIAN, BEGINNING AT A POINT WHICH BEARS S. 010 05' 46" W. (SOUTH) 1221.00 FEET FROM THE NORTHWEST CORNER OF SAID QUARTER SECTION, 45.00 FEET WEST AND 11.342 SQUARE FEET, MORE OR LESS, CONTAINING 0.65 ACRES, MORE OR LESS.

PARCEL "D" (RESUB TO STAUFFER)



SURVEYOR'S CERTIFICATE

I, CYNTHIA L. ROBINETT DO HEREBY CERTIFY THAT I AM A REGISTERED LAND SURVEYOR AND THAT I HOLD CERTIFICATE NO. 7511 AS PRESCRIBED BY THE LAWS OF THE STATE OF UTAH AND THAT I HAVE MADE A SURVEY ON THE GROUND AND FROM RECORDS OF THE WEBER COUNTY RECORDERS OFFICE AS DESCRIBED ABOVE AND AS SHOWN PER THIS PLAN.

DATED: 6/21/74

CYNTHIA L. ROBINETT, R.L.S.# 7511

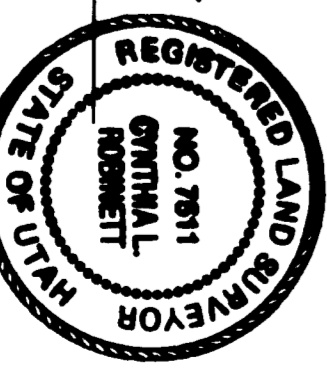

RECEIVED
JUN 8 8 55

NARRATIVE

THE PURPOSE OF THIS SURVEY WAS TO SHOW DEED LINES IN COMPARISON TO THE EXISTING FENCE LINES. EXISTING WEBER COUNTY SURVEYOR'S BRASS CAP MONUMENTS WERE USED TO PERPETUATE SAID DEED LINES AND FENCES AS SHOWN ON THIS PLAN. A BOUNDARY LINE AGREEMENT HAS BEEN PREPARED FOR THE ADJACENT PROPERTY OWNERS LYING EAST OF THE AS MONUMENTED SECTION LINE FOR THE ADJACENT PROPERTY OWNERS. THE EAST LINE OF THE SOUTHWEST QUARTER OF SECTION 11, TOWNSHIP 5 NORTH, RANGE 3 WEST, (AS MONUMENTED).

LEGEND:

- () DISTANCE AND OR BEARING PER DEED OR PLAN
- NO PARAPHERS IS MEASURED DISTANCE OR ROTATED PLAT
- EXISTING FENCES
- SET 3/4" REBAR WITH C & L.S. CAP.

CLIENT: JERRY OLSEN
SURVEY LOCATION: 2751 WASHINGTON BLVD OGDEN, UTAH 84401 (801) 398-6035
SURVEY DATE: 12/02/74
JOB NO. PS94-34