

DRAWING NUMBER
001188

DRAWING NUMBER
001188

DRAWING NUMBER
001188


DRAWING NUMBER
001188

PLAN HOLD CORPORATION • IRVINE, CALIFORNIA
RECORD BY NUMBER 07348
SECTION LINE OF PLAT OR PLATS





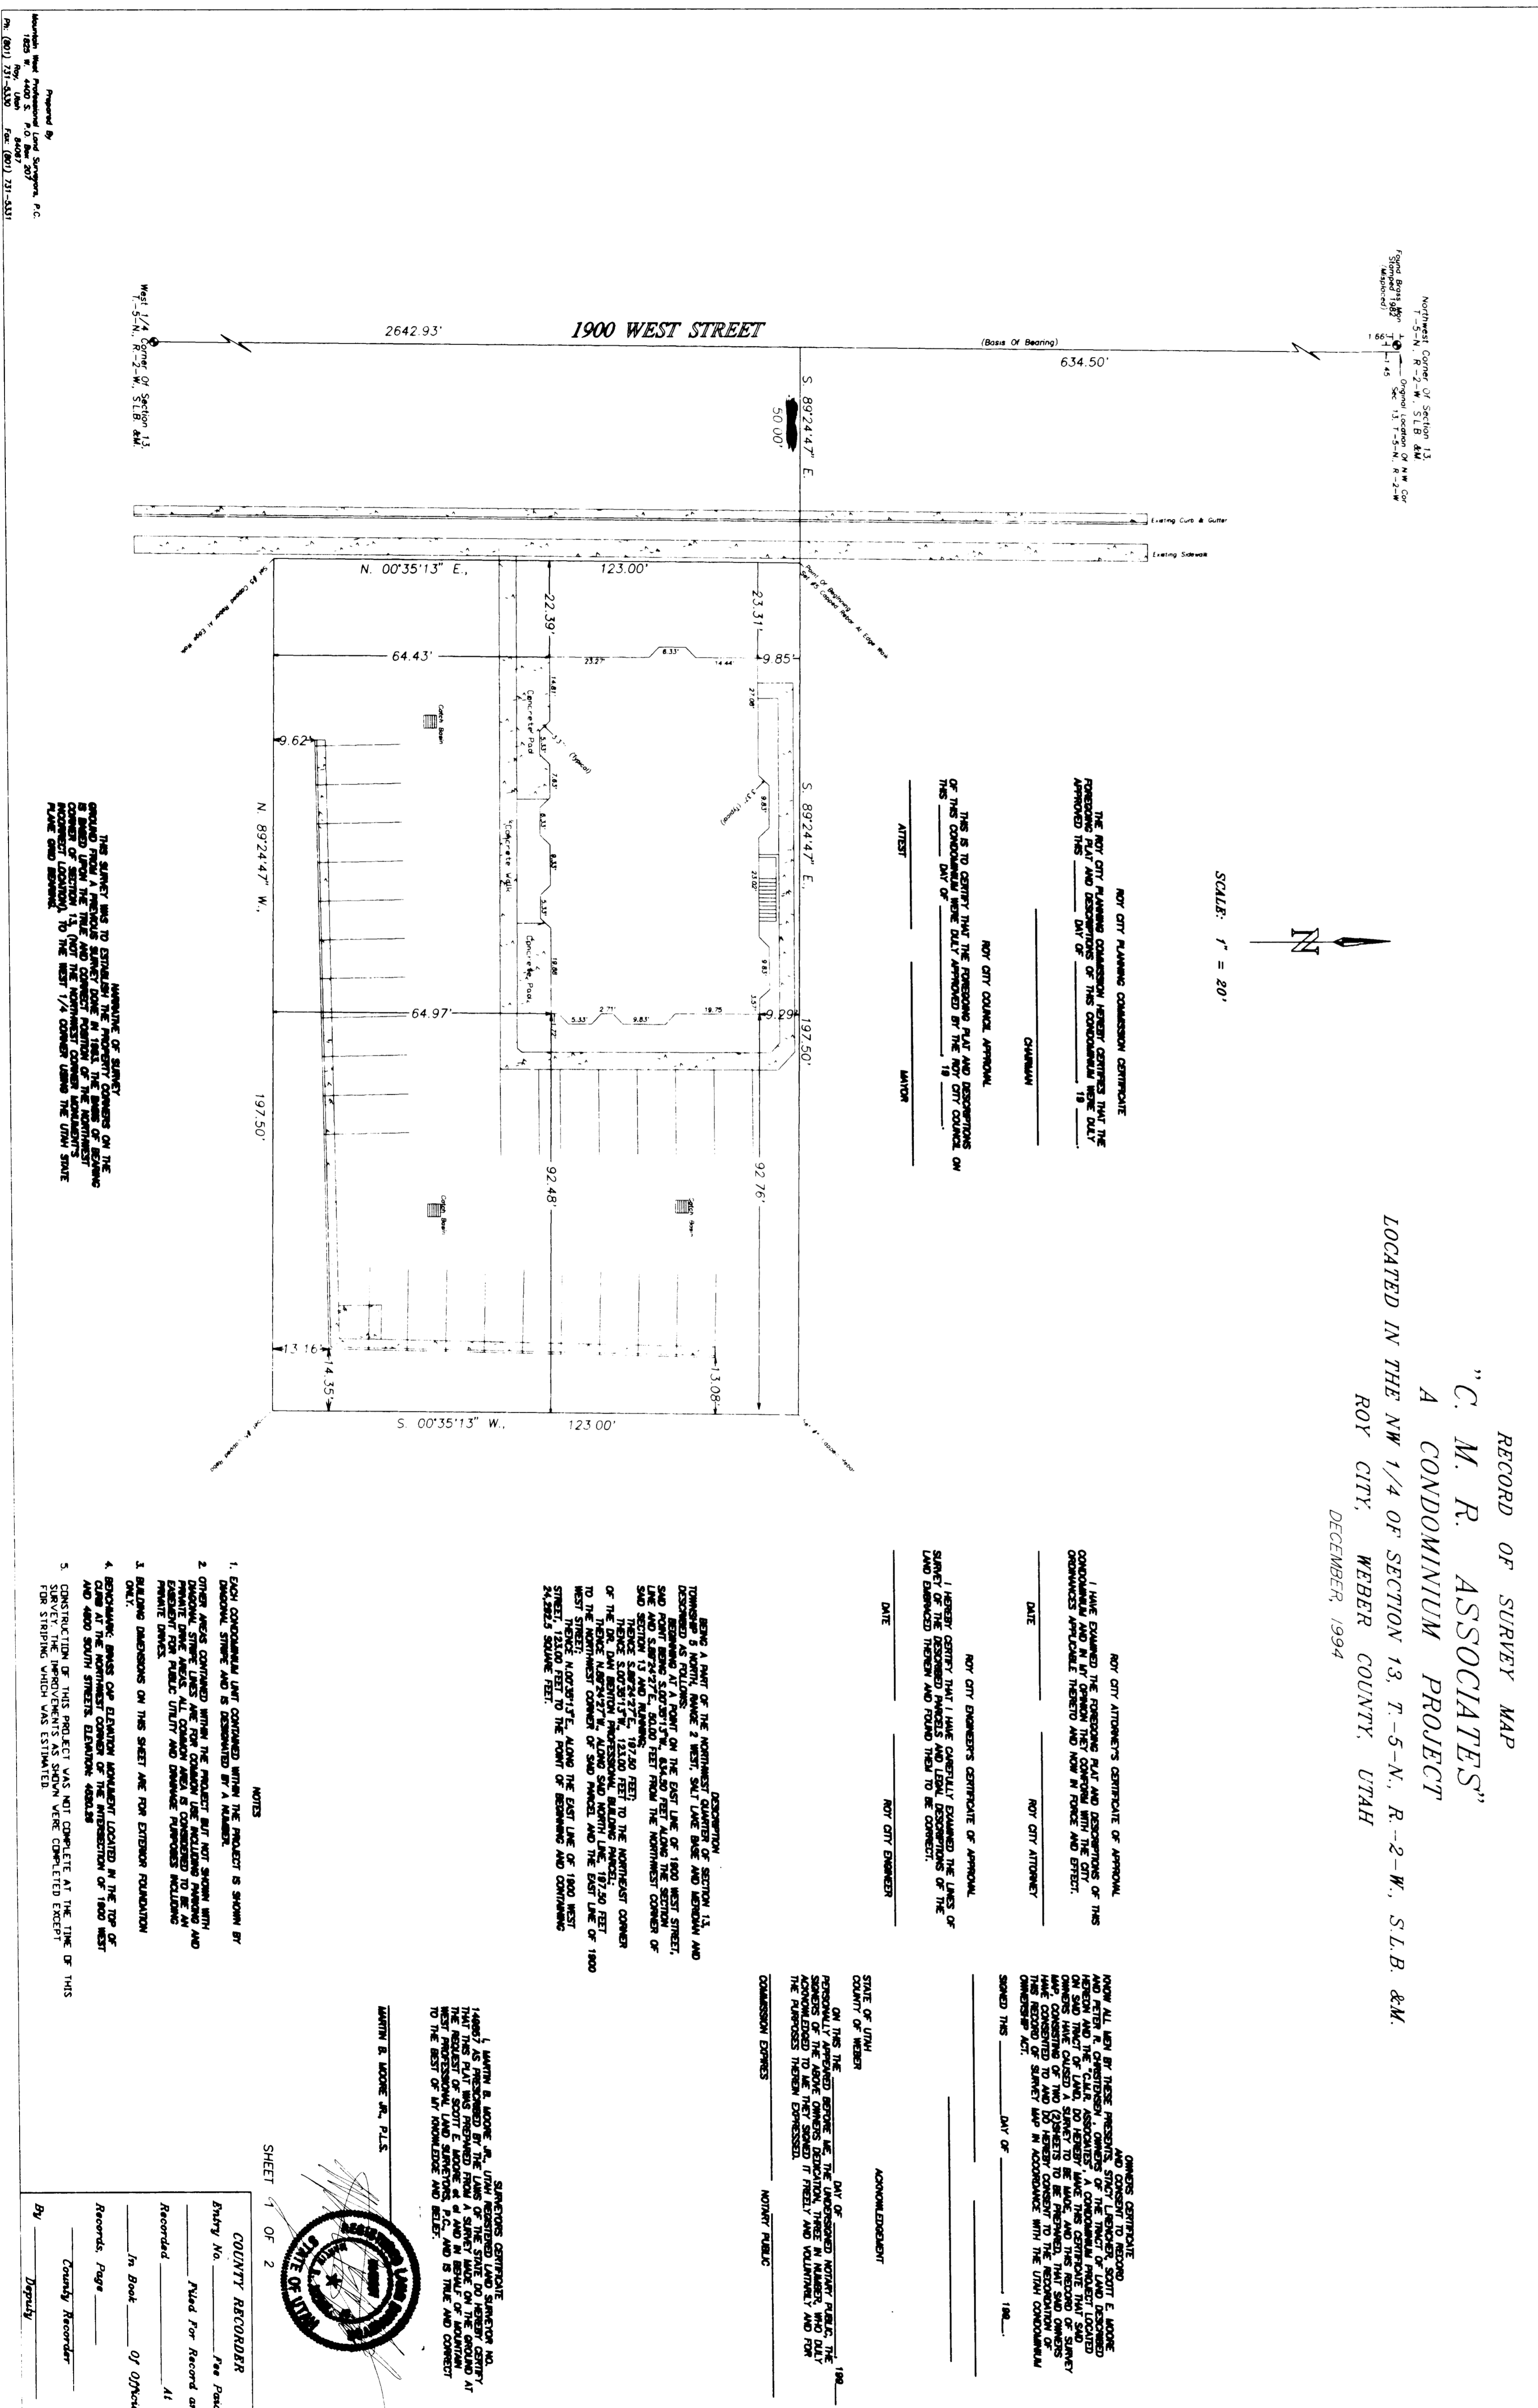

RECORD OF SURVEY MAP
 "C. M. R. ASSOCIATES"
 A CONDOMINIUM PROJECT
 LOCATED IN THE NW 1/4 OF SECTION 13, T-5-N., R-2-W., S.L.B. & M.
 ROY CITY, WEBER COUNTY, UTAH
 DECEMBER 1994

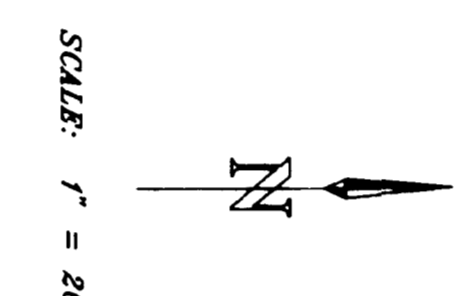











- NOTES


COUNTY RECORDER

Entry No. _____ Fee Paid _____

Recorded _____ of _____

In Book _____ of _____

Received _____

County Recorder _____

By _____

RECEIVED
 JUN 26 1995
 Web-Cad/CadView

001188