

DRAWING NUMBER

001198

PLAN HOLD CORPORATION • IRVINE, CALIFORNIA

REORDER BY NUMBER 075AR

REORDER BY NUMBER 075AR

DRAWING NUMBER

001198

PLAN HOLD CORPORATION • IRVINE, CALIFORNIA

REORDER BY NUMBER 075AR

REORDER BY NUMBER 075AR

DRAWING NUMBER

001198

PLAN HOLD CORPORATION • IRVINE, CALIFORNIA

REORDER BY NUMBER 075AR

REORDER BY NUMBER 075AR

DRAWING NUMBER

001198

PLAN HOLD CORPORATION • IRVINE, CALIFORNIA


REORDER BY NUMBER 075AR

REORDER BY NUMBER 075AR

### SURVEYORS CERTIFICATE


DATE: Mar. 21, 1995 SIGNED: Dallas K. Buttars

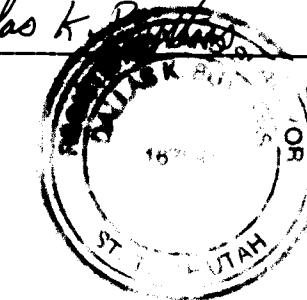


### DESCRIPTION

ALL OF LOT 45, PATIO SPRINGS UNIT NO. 1, A CLUSTER TYPE SUBDIVISION LOCATED IN WEBER COUNTY, UTAH.

### NARRATIVE

THE PURPOSE OF THIS SURVEY WAS TO ESTABLISH THE PROPERTY CORNERS SO A HOUSE COULD BE BUILT.

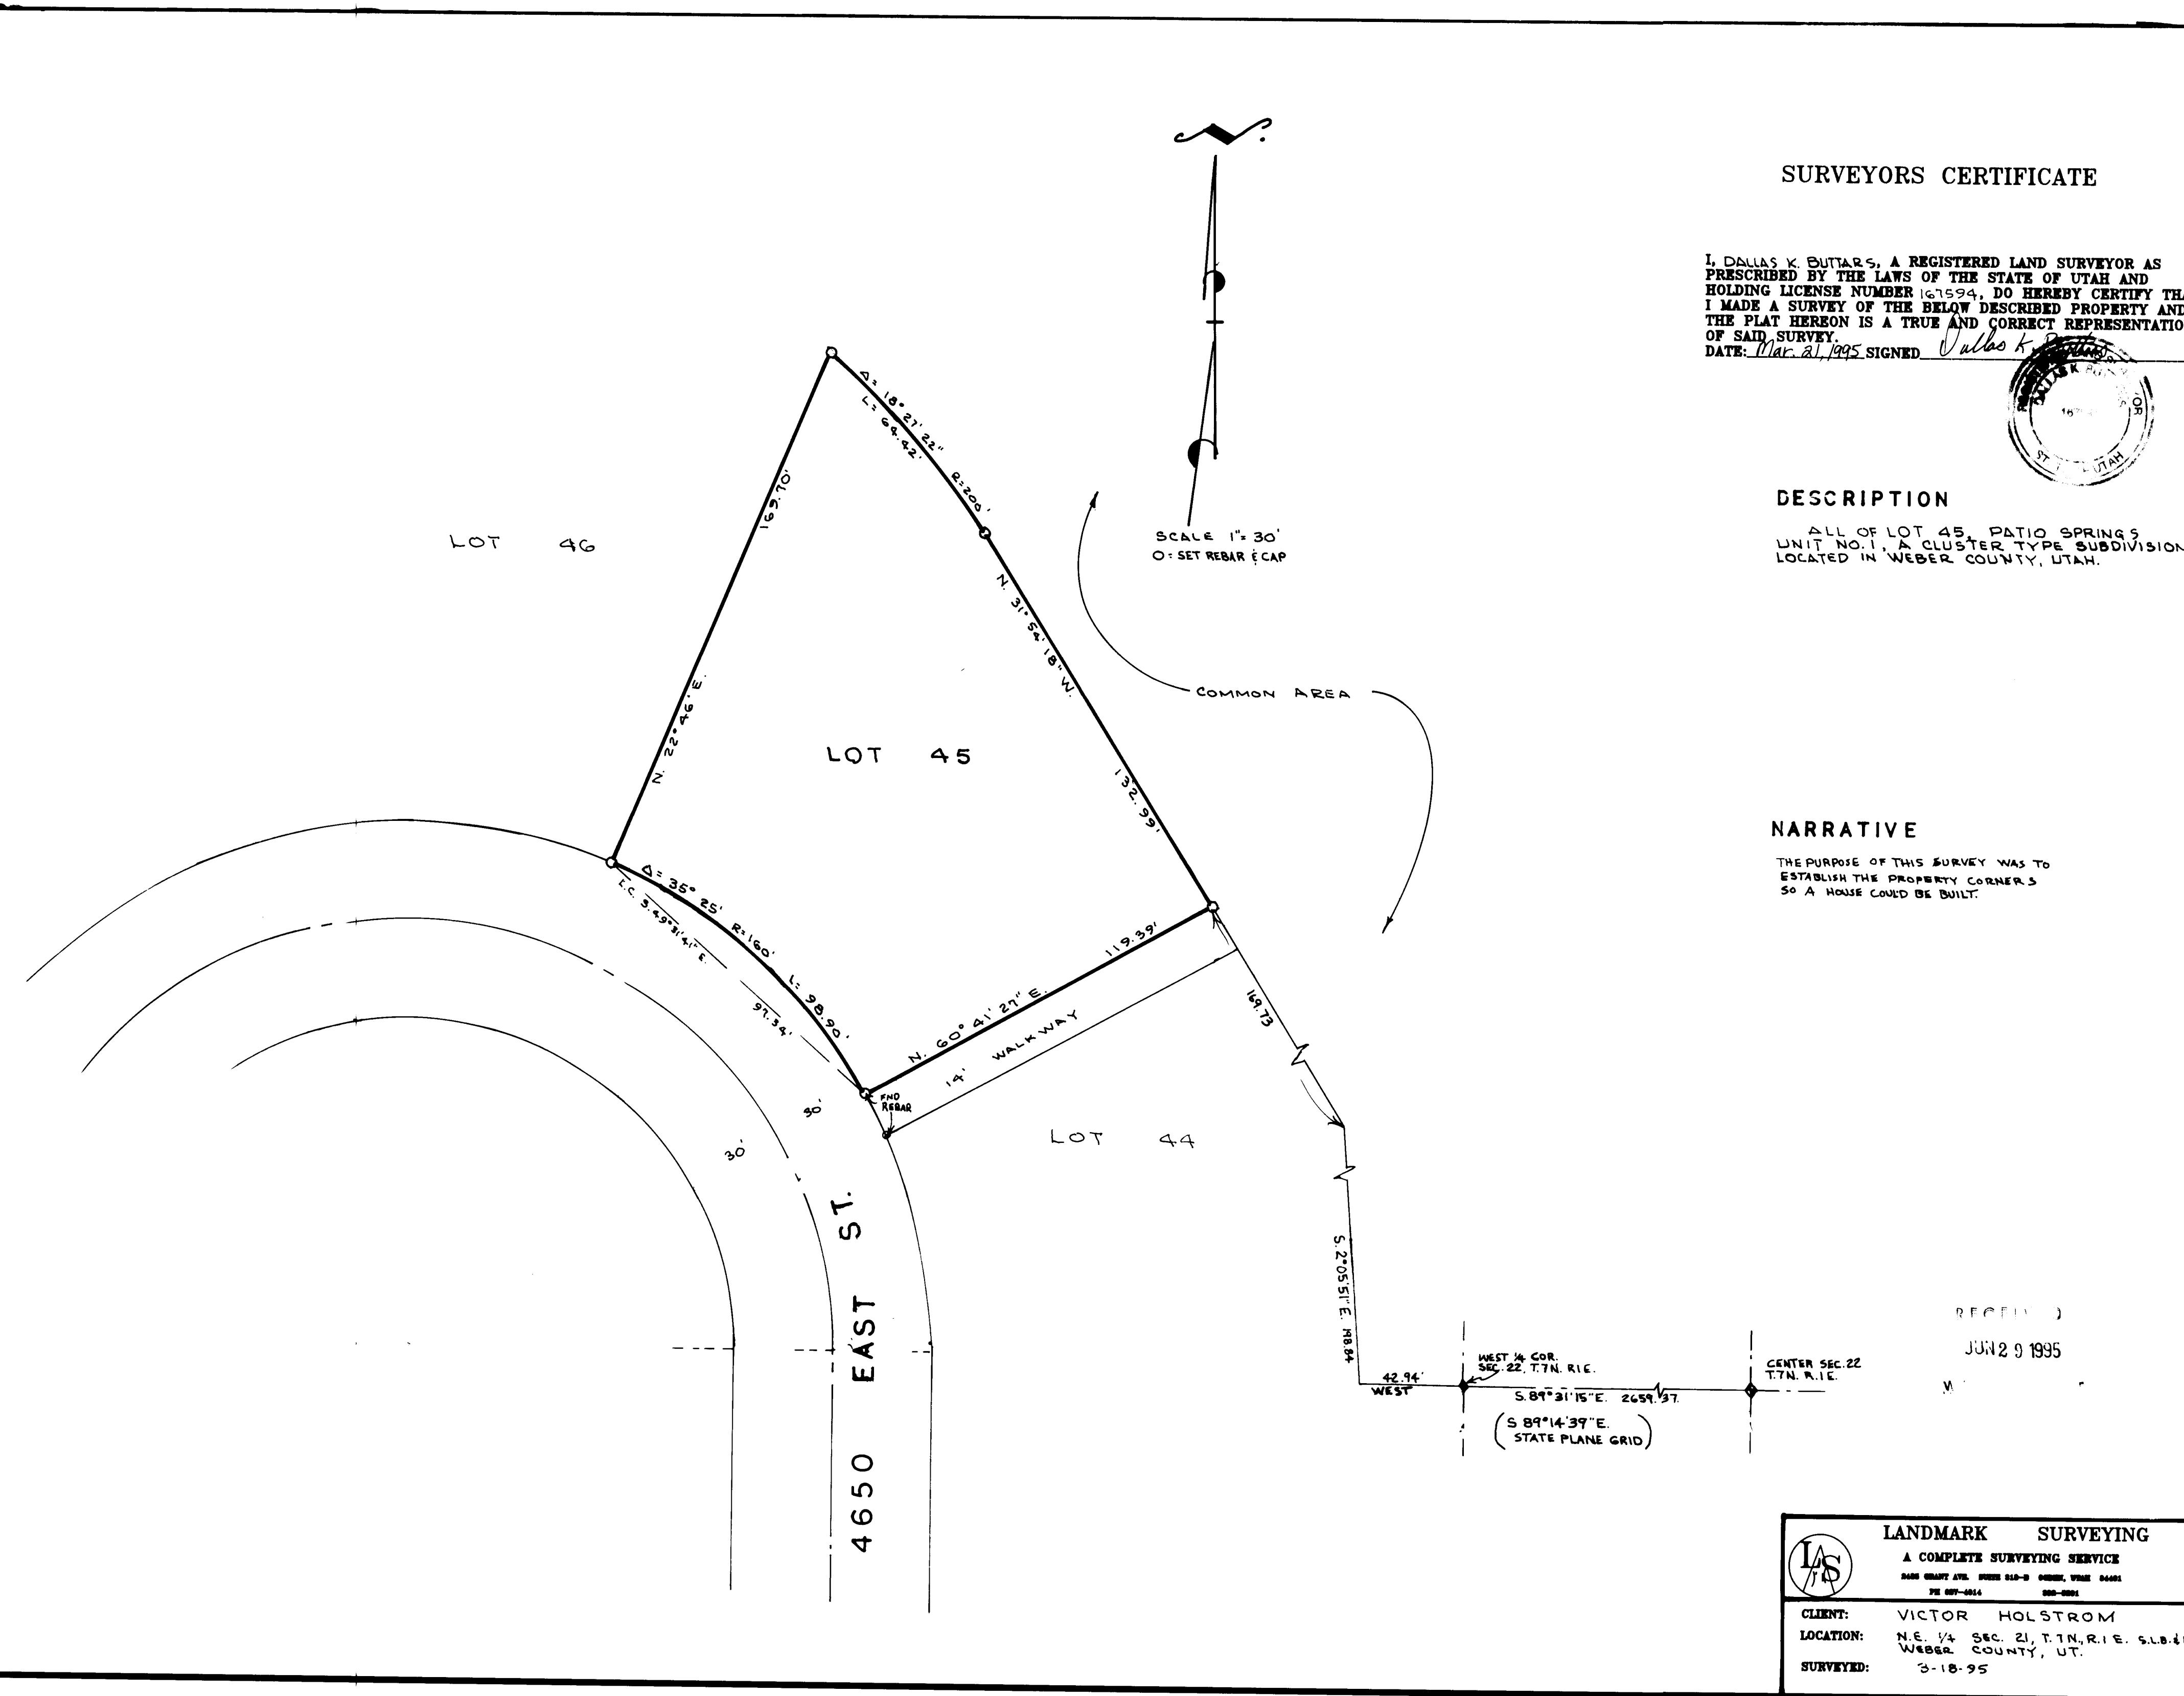

RECEIVED

JUN 29 1995

**LANDMARK SURVEYING**  
 A COMPLETE SURVEYING SERVICE  

CLIENT: VICTOR HOLSTROM  
 LOCATION: N.E. 1/4 SEC. 21, T.7N. R.1E. S.U.B.D.M. WEBER COUNTY, UT.  
 SURVEYED: 3-18-95

001198